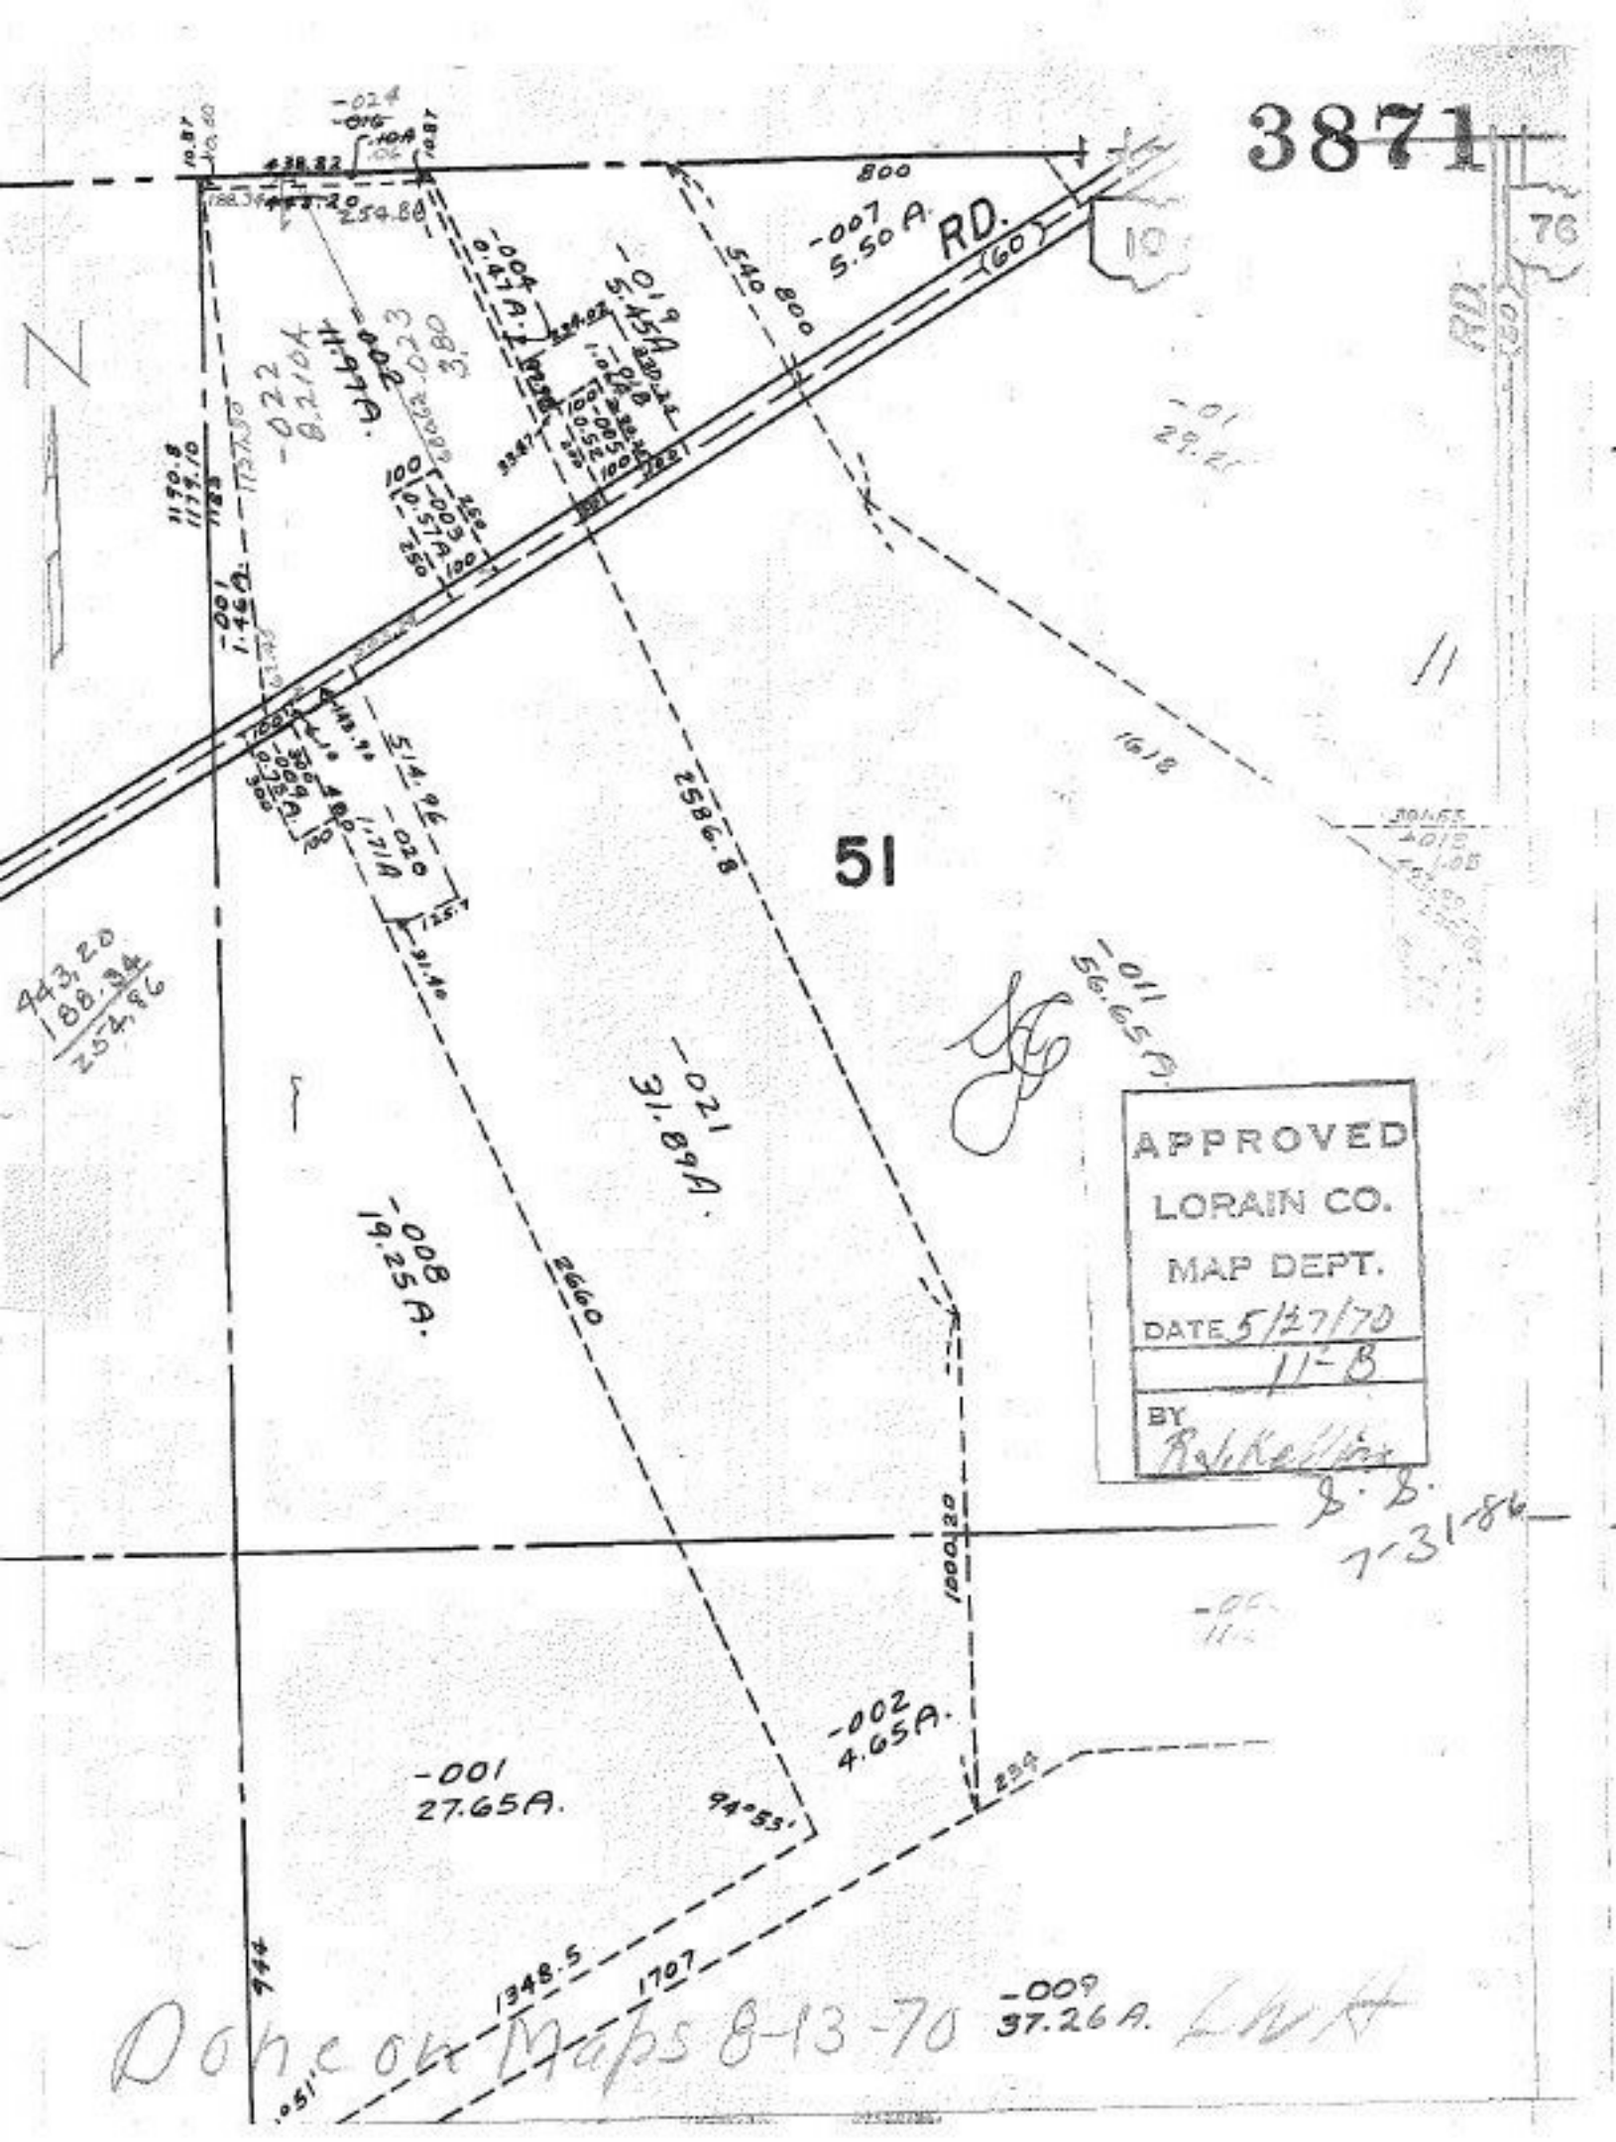
3871
RD.
(60')
800
-007
5.50 A.
-019
5.45A
-004
0.47 A.
-002
11.97A.
-022
8.21A
-023
3.80
-003
0.57A
-001
1.46A.
-024
-016
-017
-018
-010
-005
-006
-009A
-009B
-020
1.71A
-021
31.89A.
-008
19.25 A.
-011
56.65 A.
-01
29.2
51
2586.8
2660
1000.20
-002
4.65A.
-001
27.65A.
94°53'
1348.5
1707
-009
37.26 A.
443.20
188.34
254.96
APPROVED
LORAIN CO.
MAP DEPT.
DATE 5/27/70
11-B
BY
Dohcok Maps 8-13-70