3881

APPROVED
LORAIN CO.
MAP DEPT.
DATE 6/1/20
7-G
BY Rob Kelling
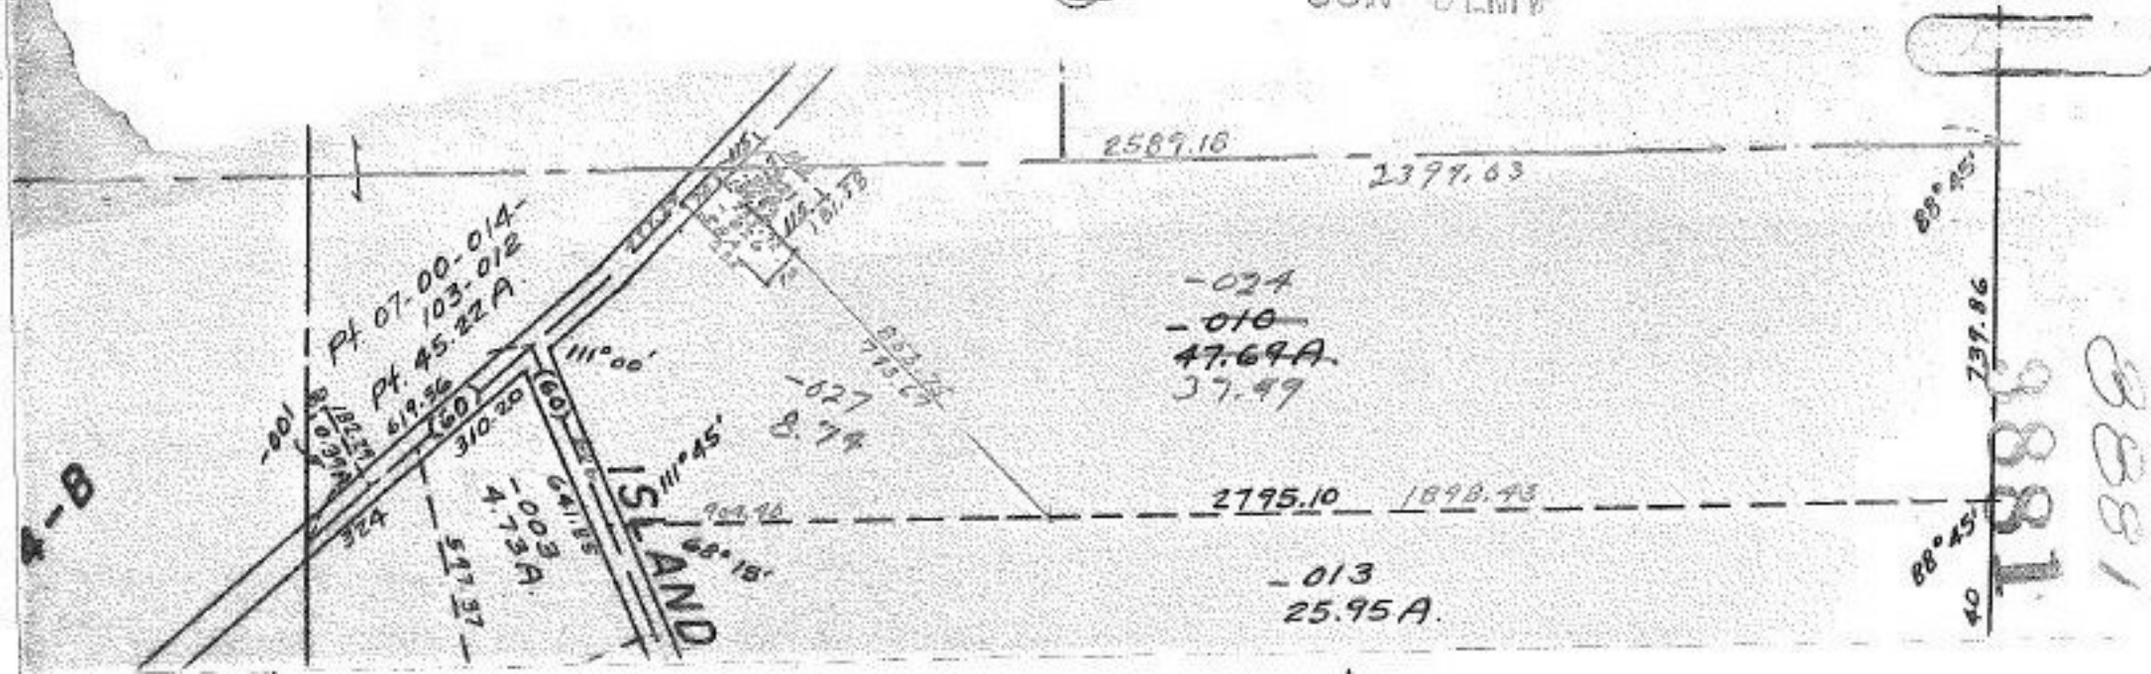
JUMP SENT