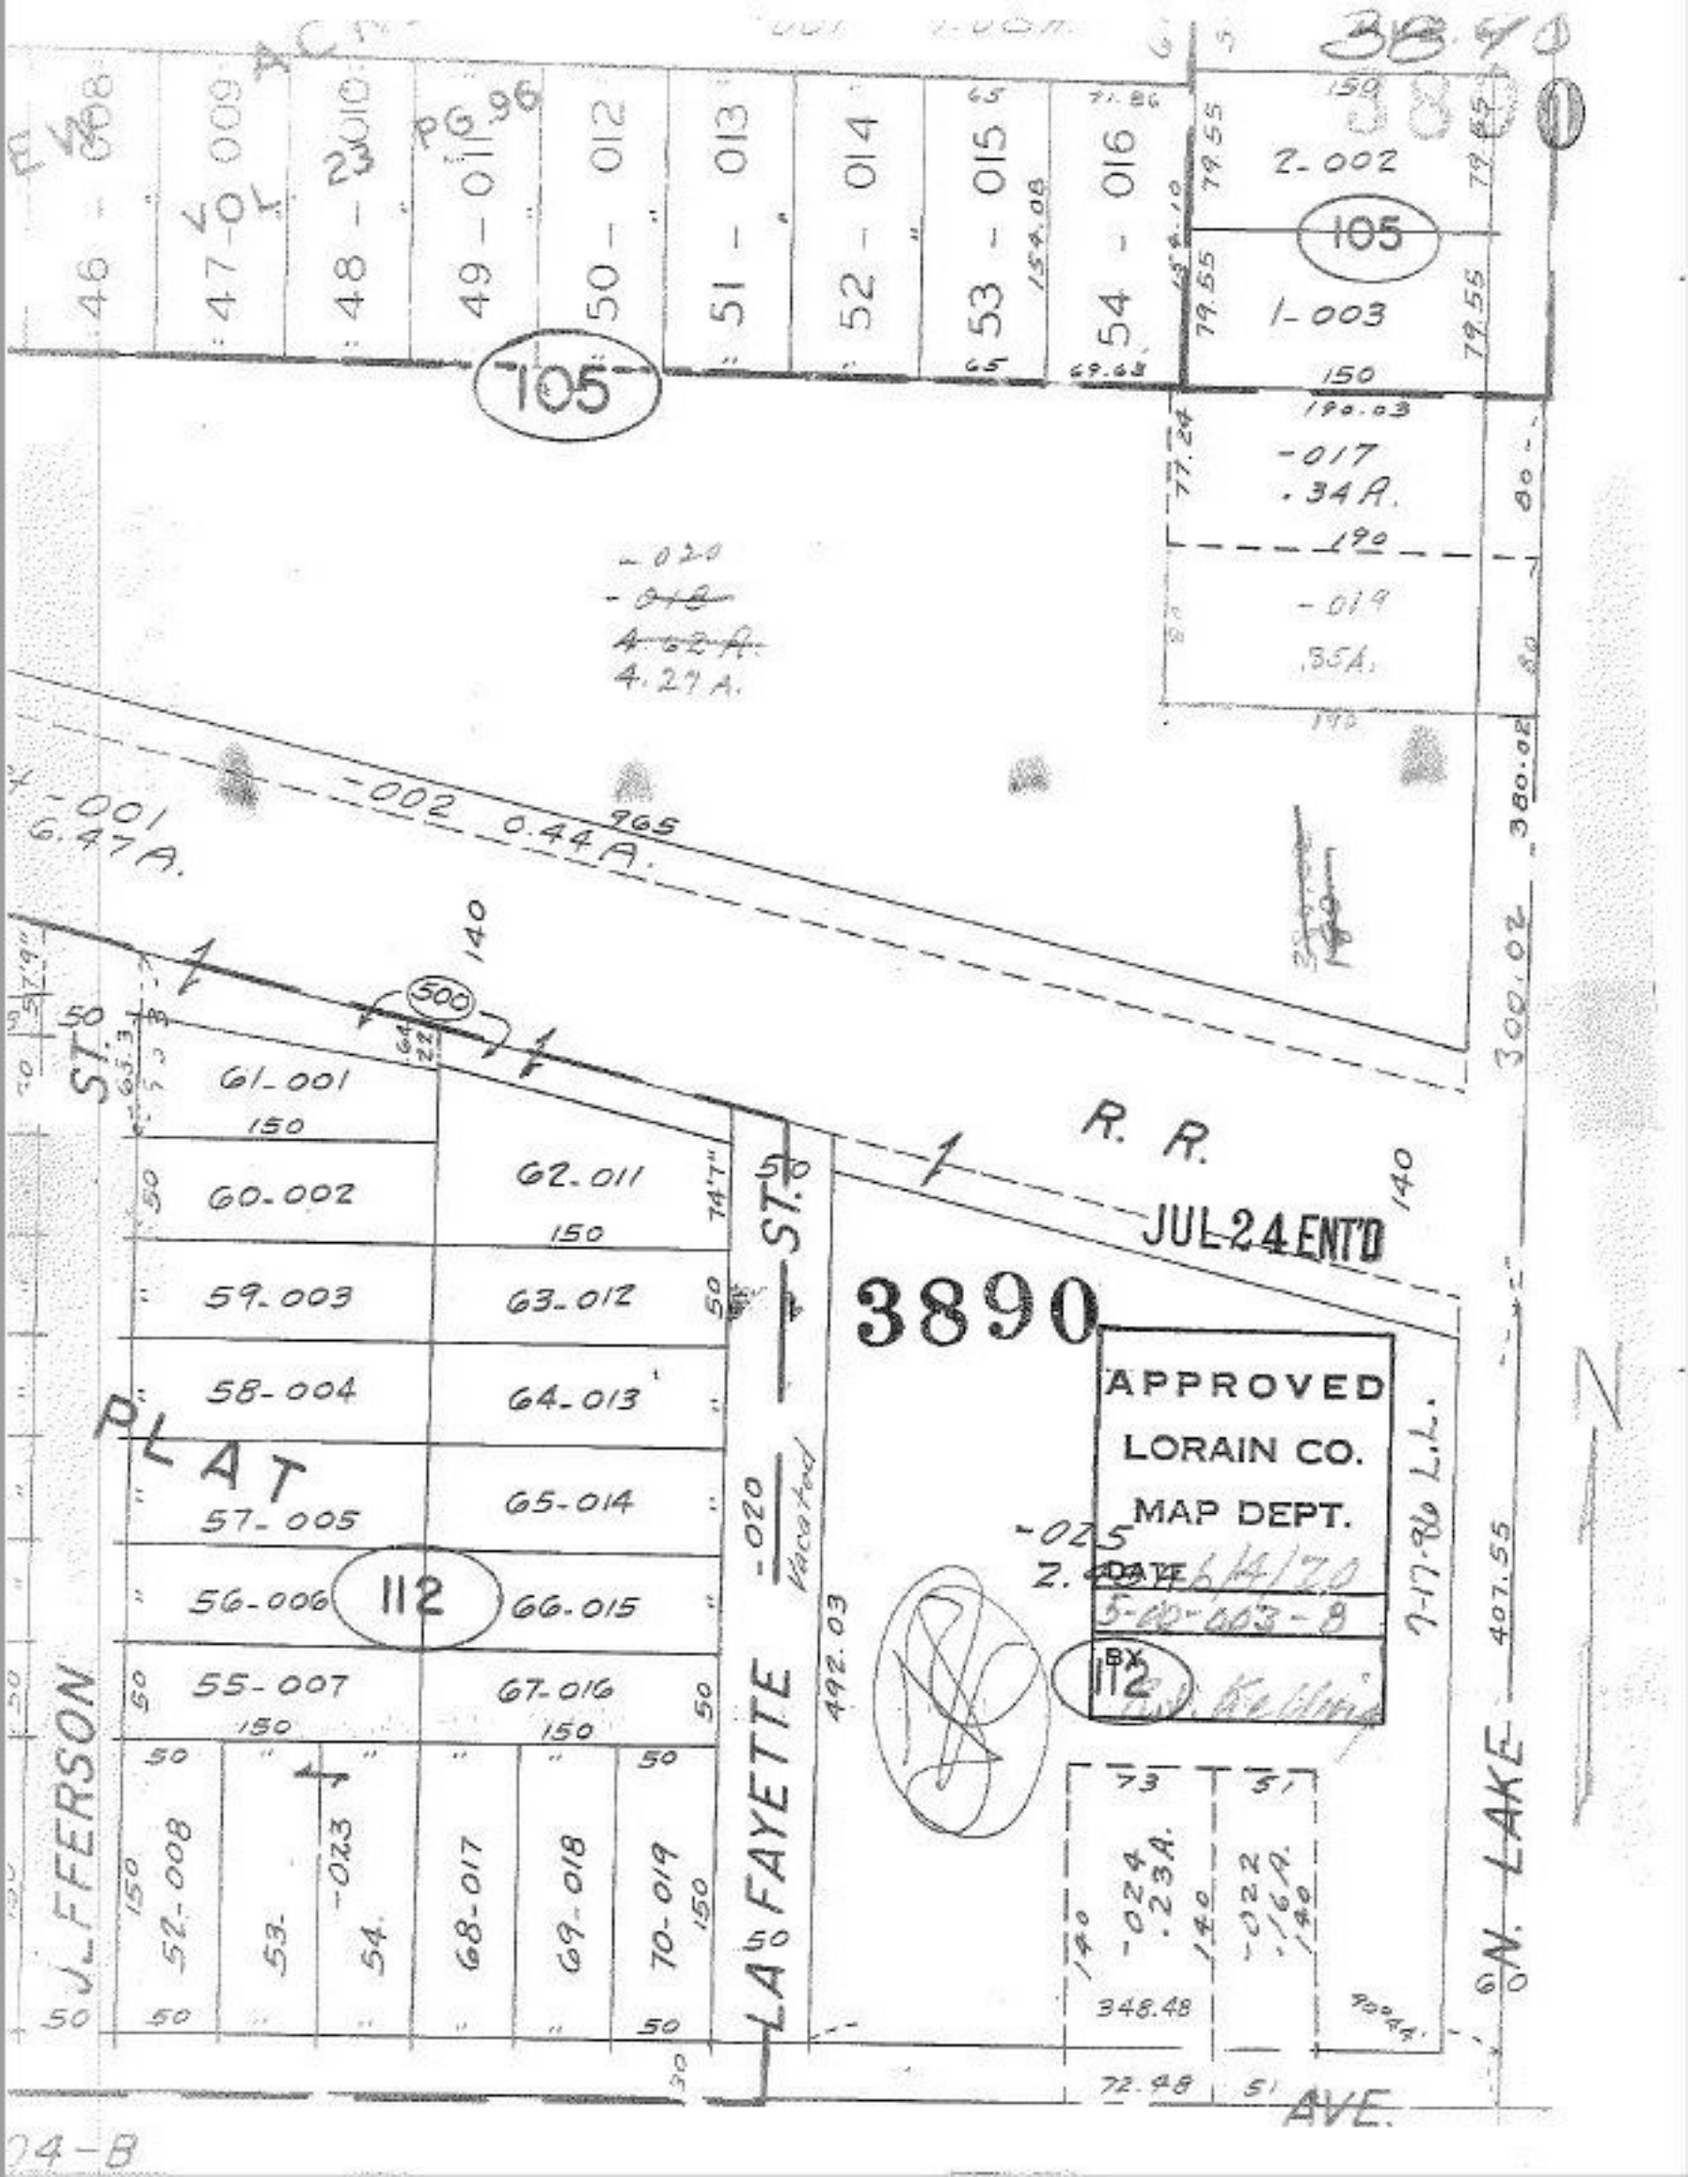
105
105
112
112
3890
APPROVED
LORAIN CO.
MAP DEPT.
DATE 6/4/70
5-02-003-8
BY
PLAT
ST.
LAFAYETTE ST.
JEFFERSON
N. LAKE AVE.
R. R.
JUL 24 ENT'D
-020
Vacated
-025
7-17-80 L.L.
-017
.34 A.
-019
.35 A.
-020
-018
4.62 A.
4.27 A.
-002 0.44 A.
61-001
.47 A.
-023
-024
.23 A.
-022
.164 A.
348.48
492.03
407.55
302.02
380.02
72.48
61-001
60-002
59-003
58-004
57-005
56-006
55-007
62-011
63-012
64-013
65-014
66-015
67-016
52-008
53-
54-
68-017
69-018
70-019
2-002
1-003
46-
47-001
48-
49-011 PG 96
50-012
51-013
52-014
53-015
54-016