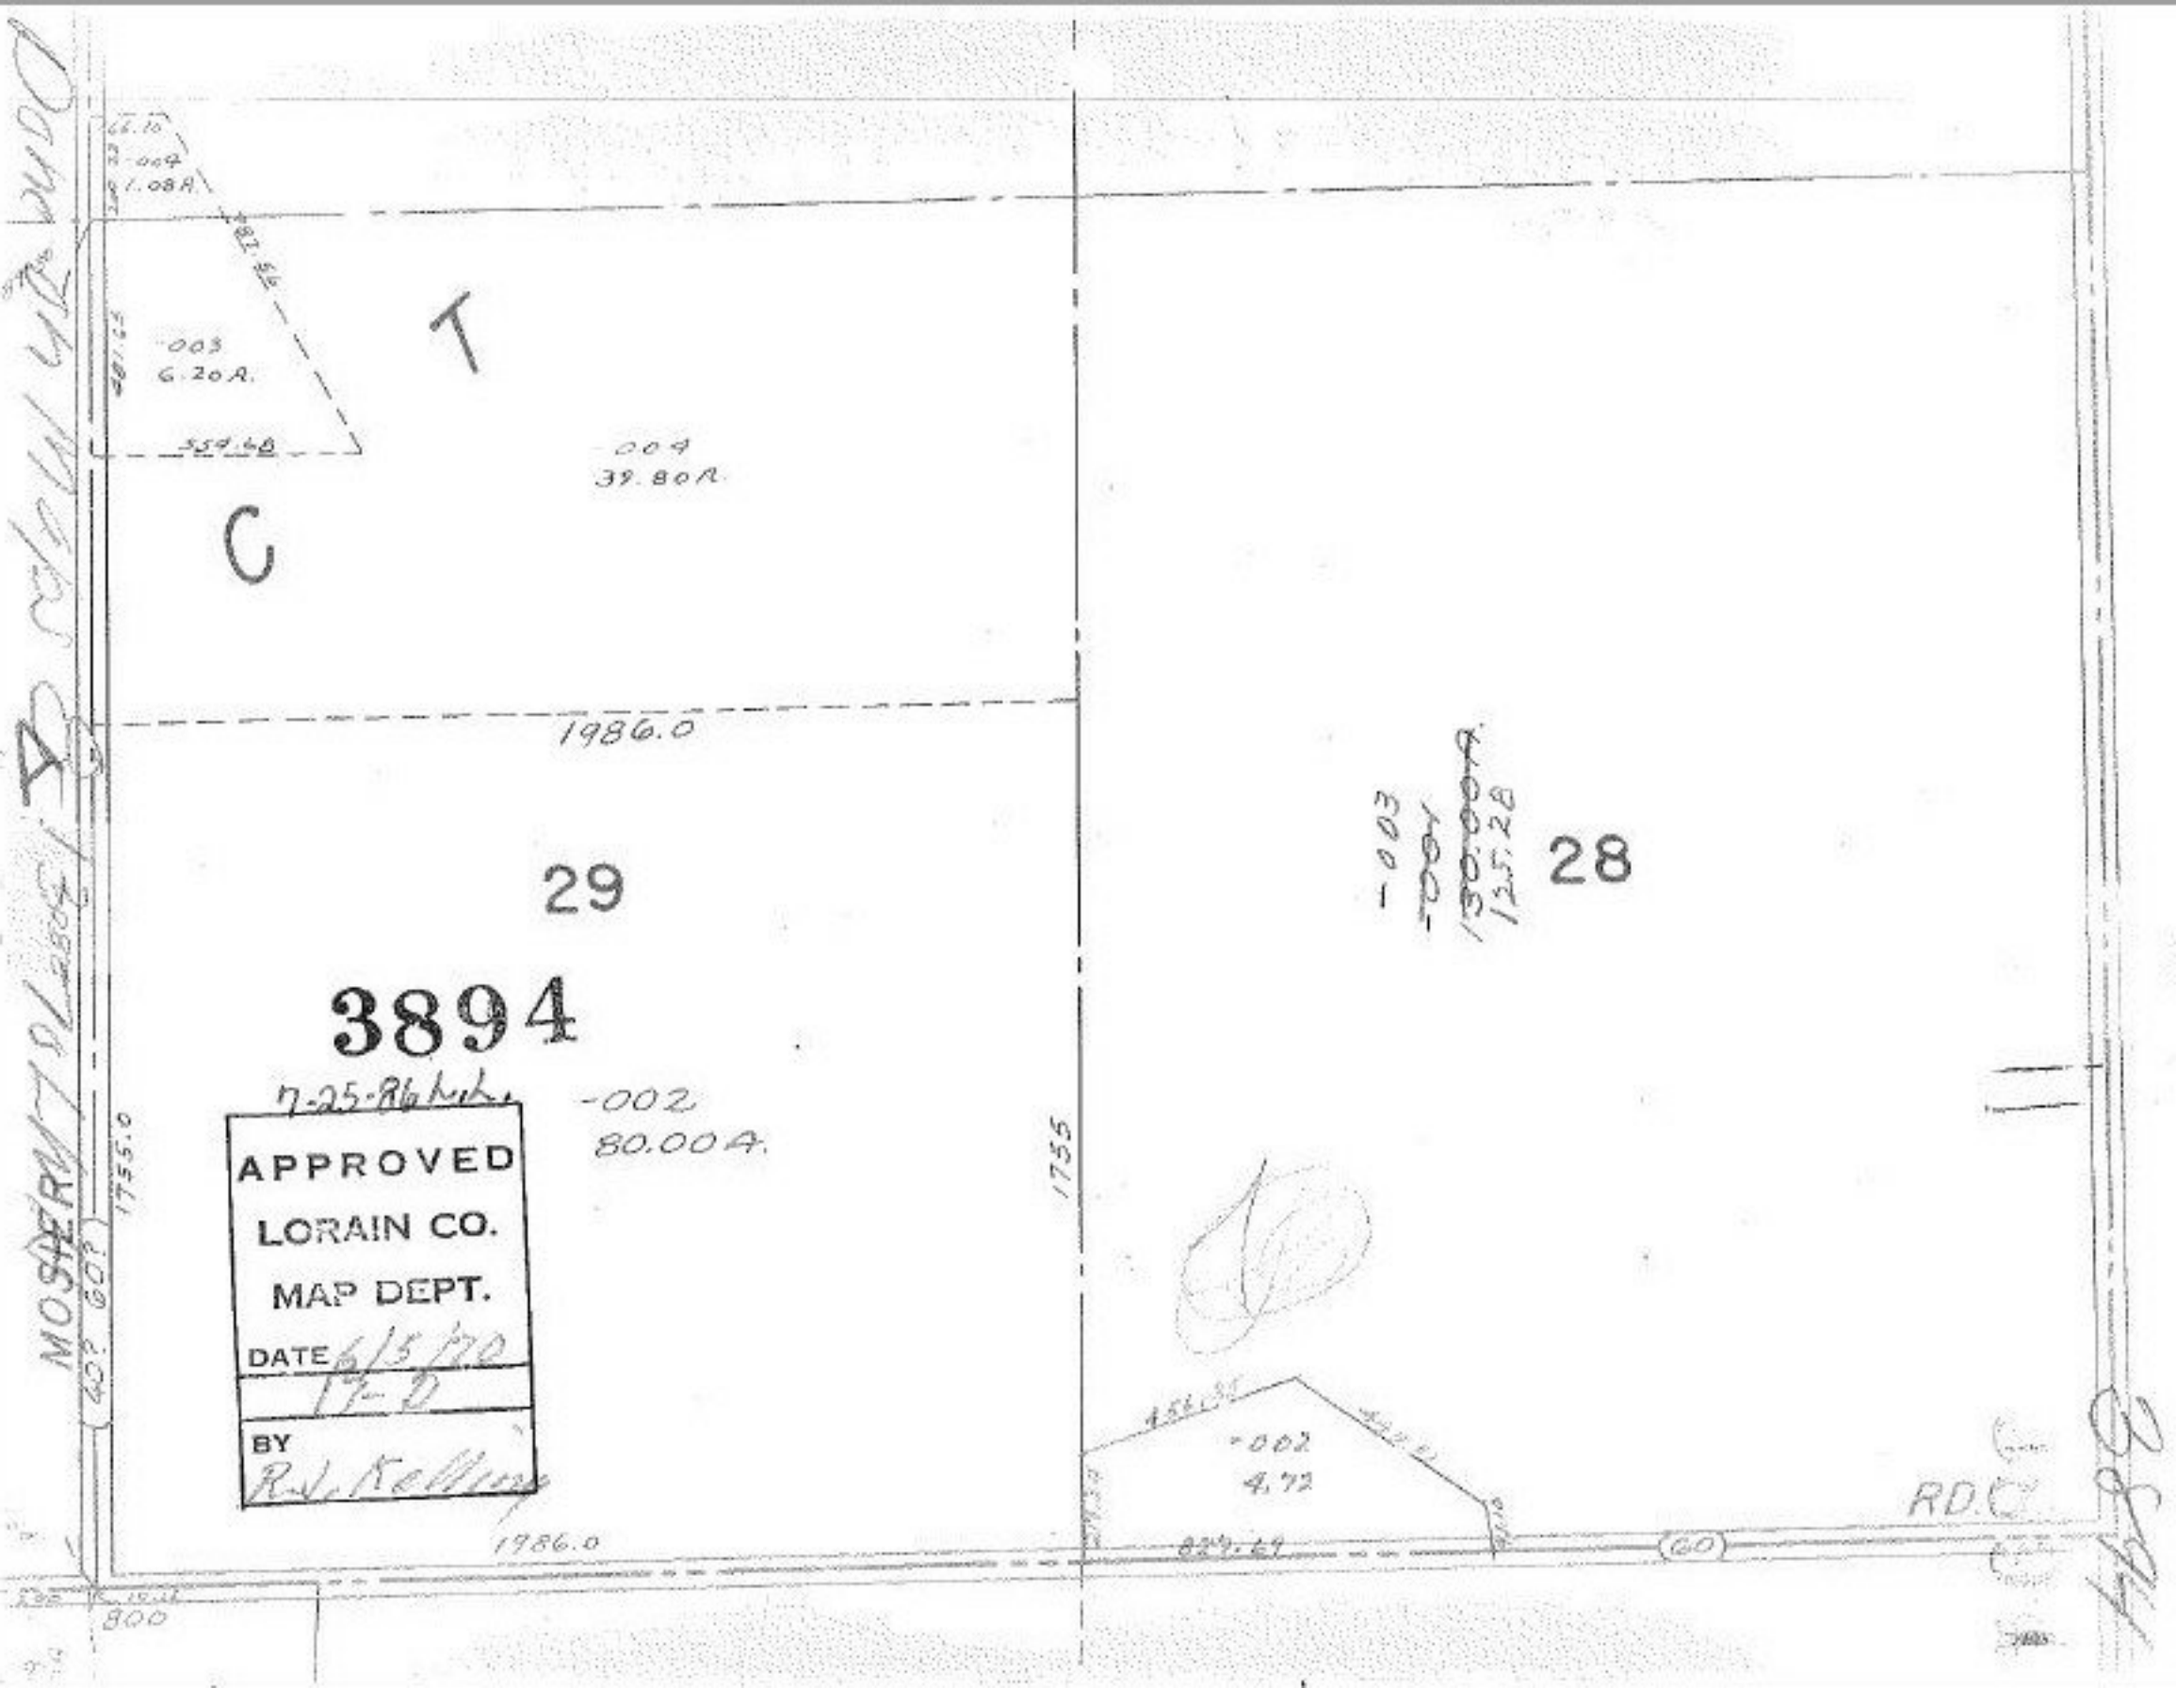

T
C
-004
1.08A.
-003
6.20A.
-004
39.80A.
1986.0
29
3894
7-25-86
-002
80.00A.
1755.0
1755
28
-003
-004
125.28
-002
4.72
1986.0
800
RD.
60
APPROVED
LORAIN CO.
MAP DEPT.
DATE 6/5/70
BY