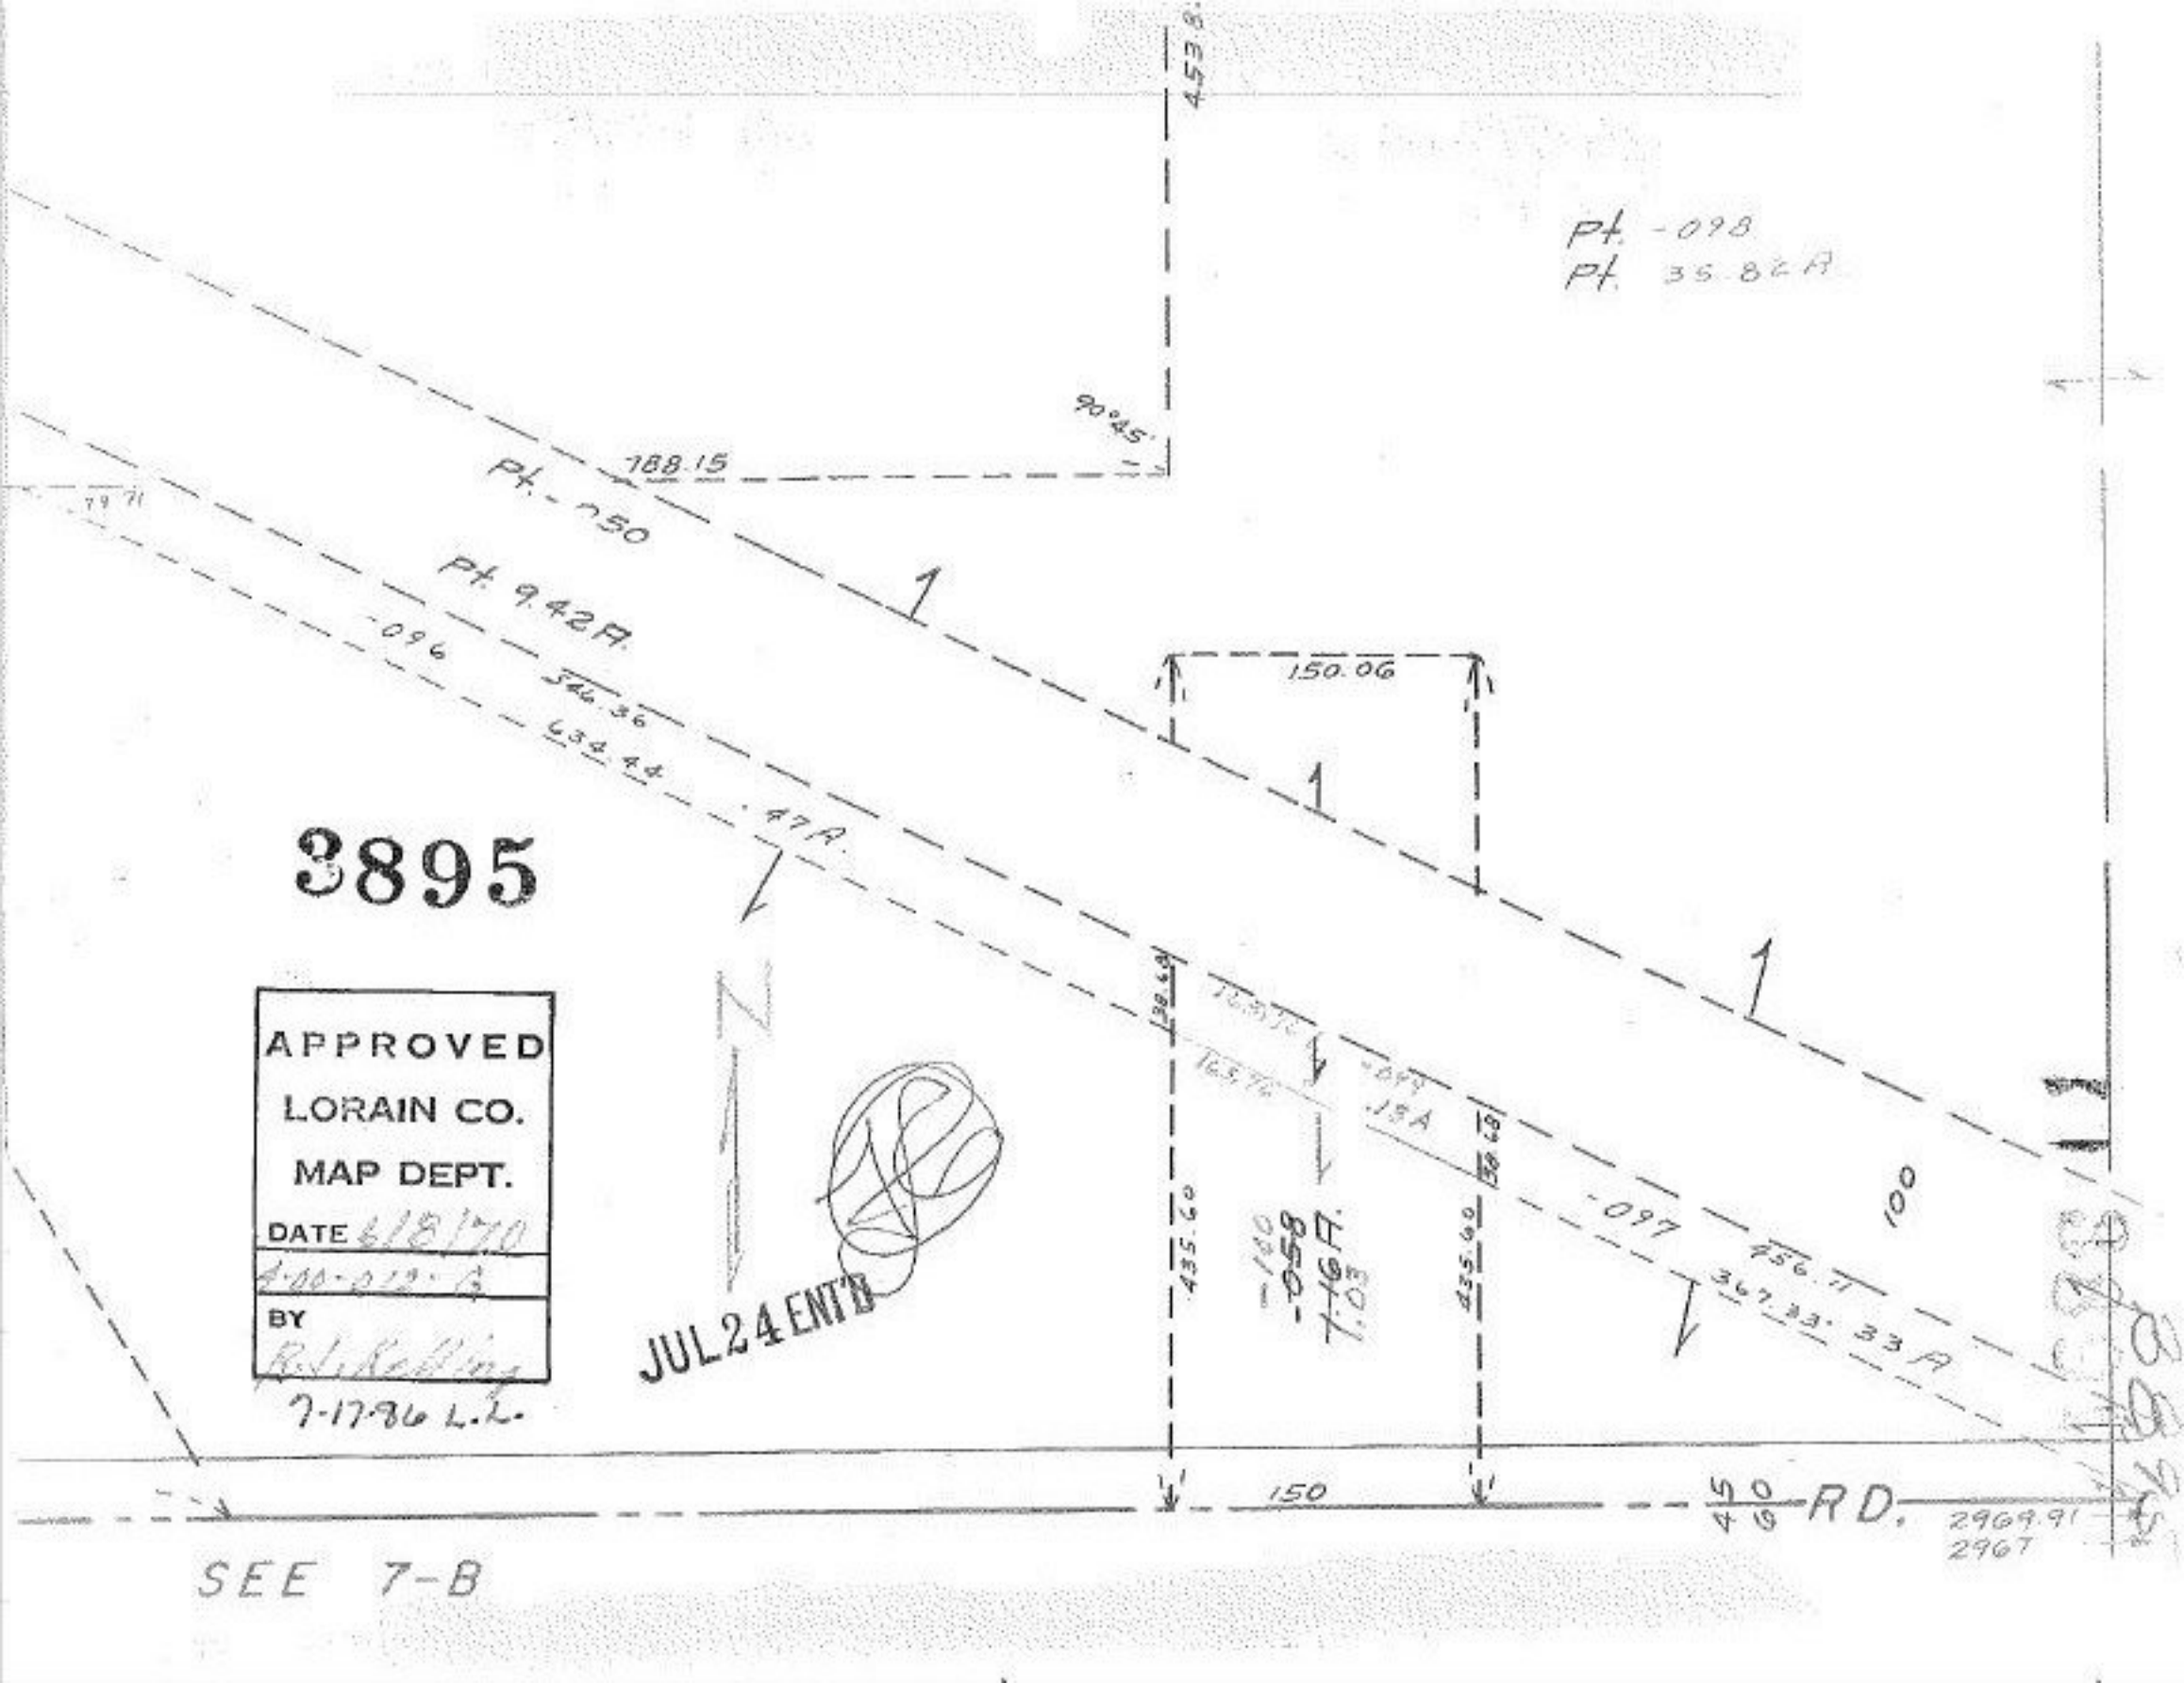
Pt. -098
Pt. 35.82A
453.8'
90°45'
168.15
Pt. -050
Pt. 9.42A.
-096
54.36
634.44
47A.
3895
150.06
1
1
1
100
APPROVED
LORAIN CO.
MAP DEPT.
DATE 6/18/70
4-00-012-B
BY
R. L. Kelling
7-17-96 L.L.
JUL 24 ENT'D
435.60
435.60
-140
-958
T.16A.
1.03
-097
456.71
367.33
33A
150
50
RD.
2969.91
2967
SEE 7-B