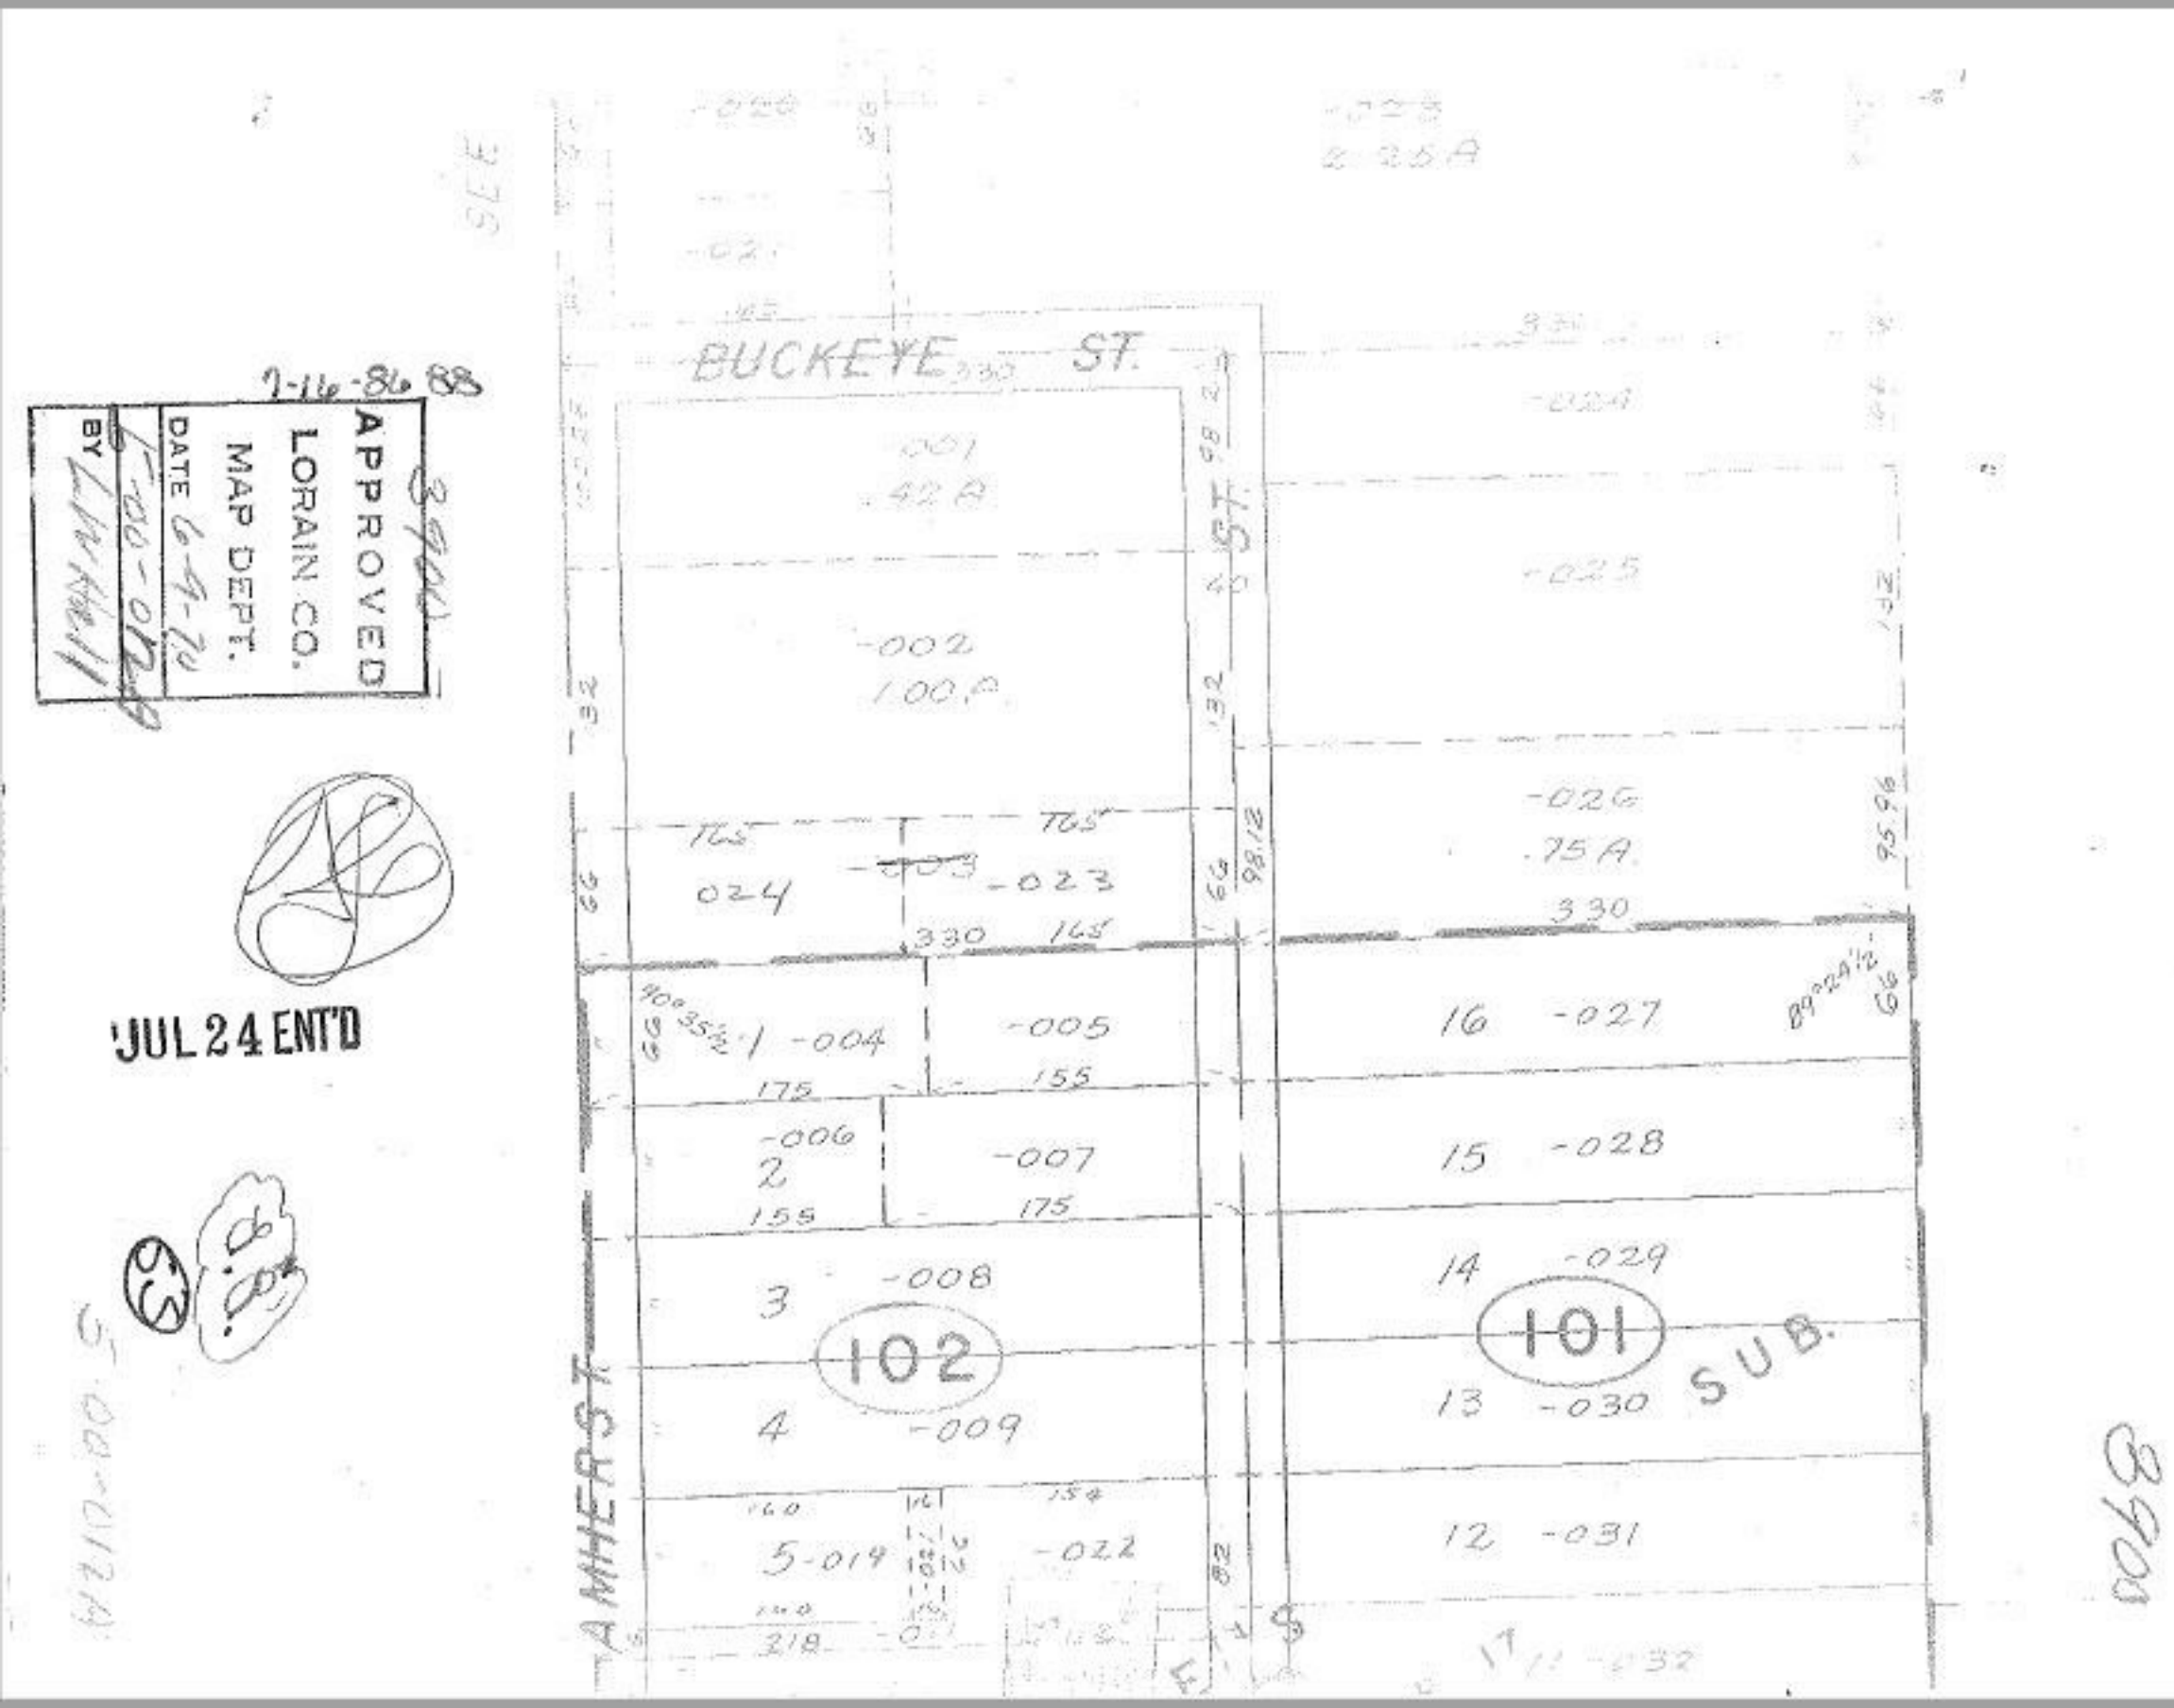

APPROVED
LORAIN CO.
MAP DEPT.
DATE 6-9-70
BY

7-16-86 88

JUL 24 ENT'D

8900