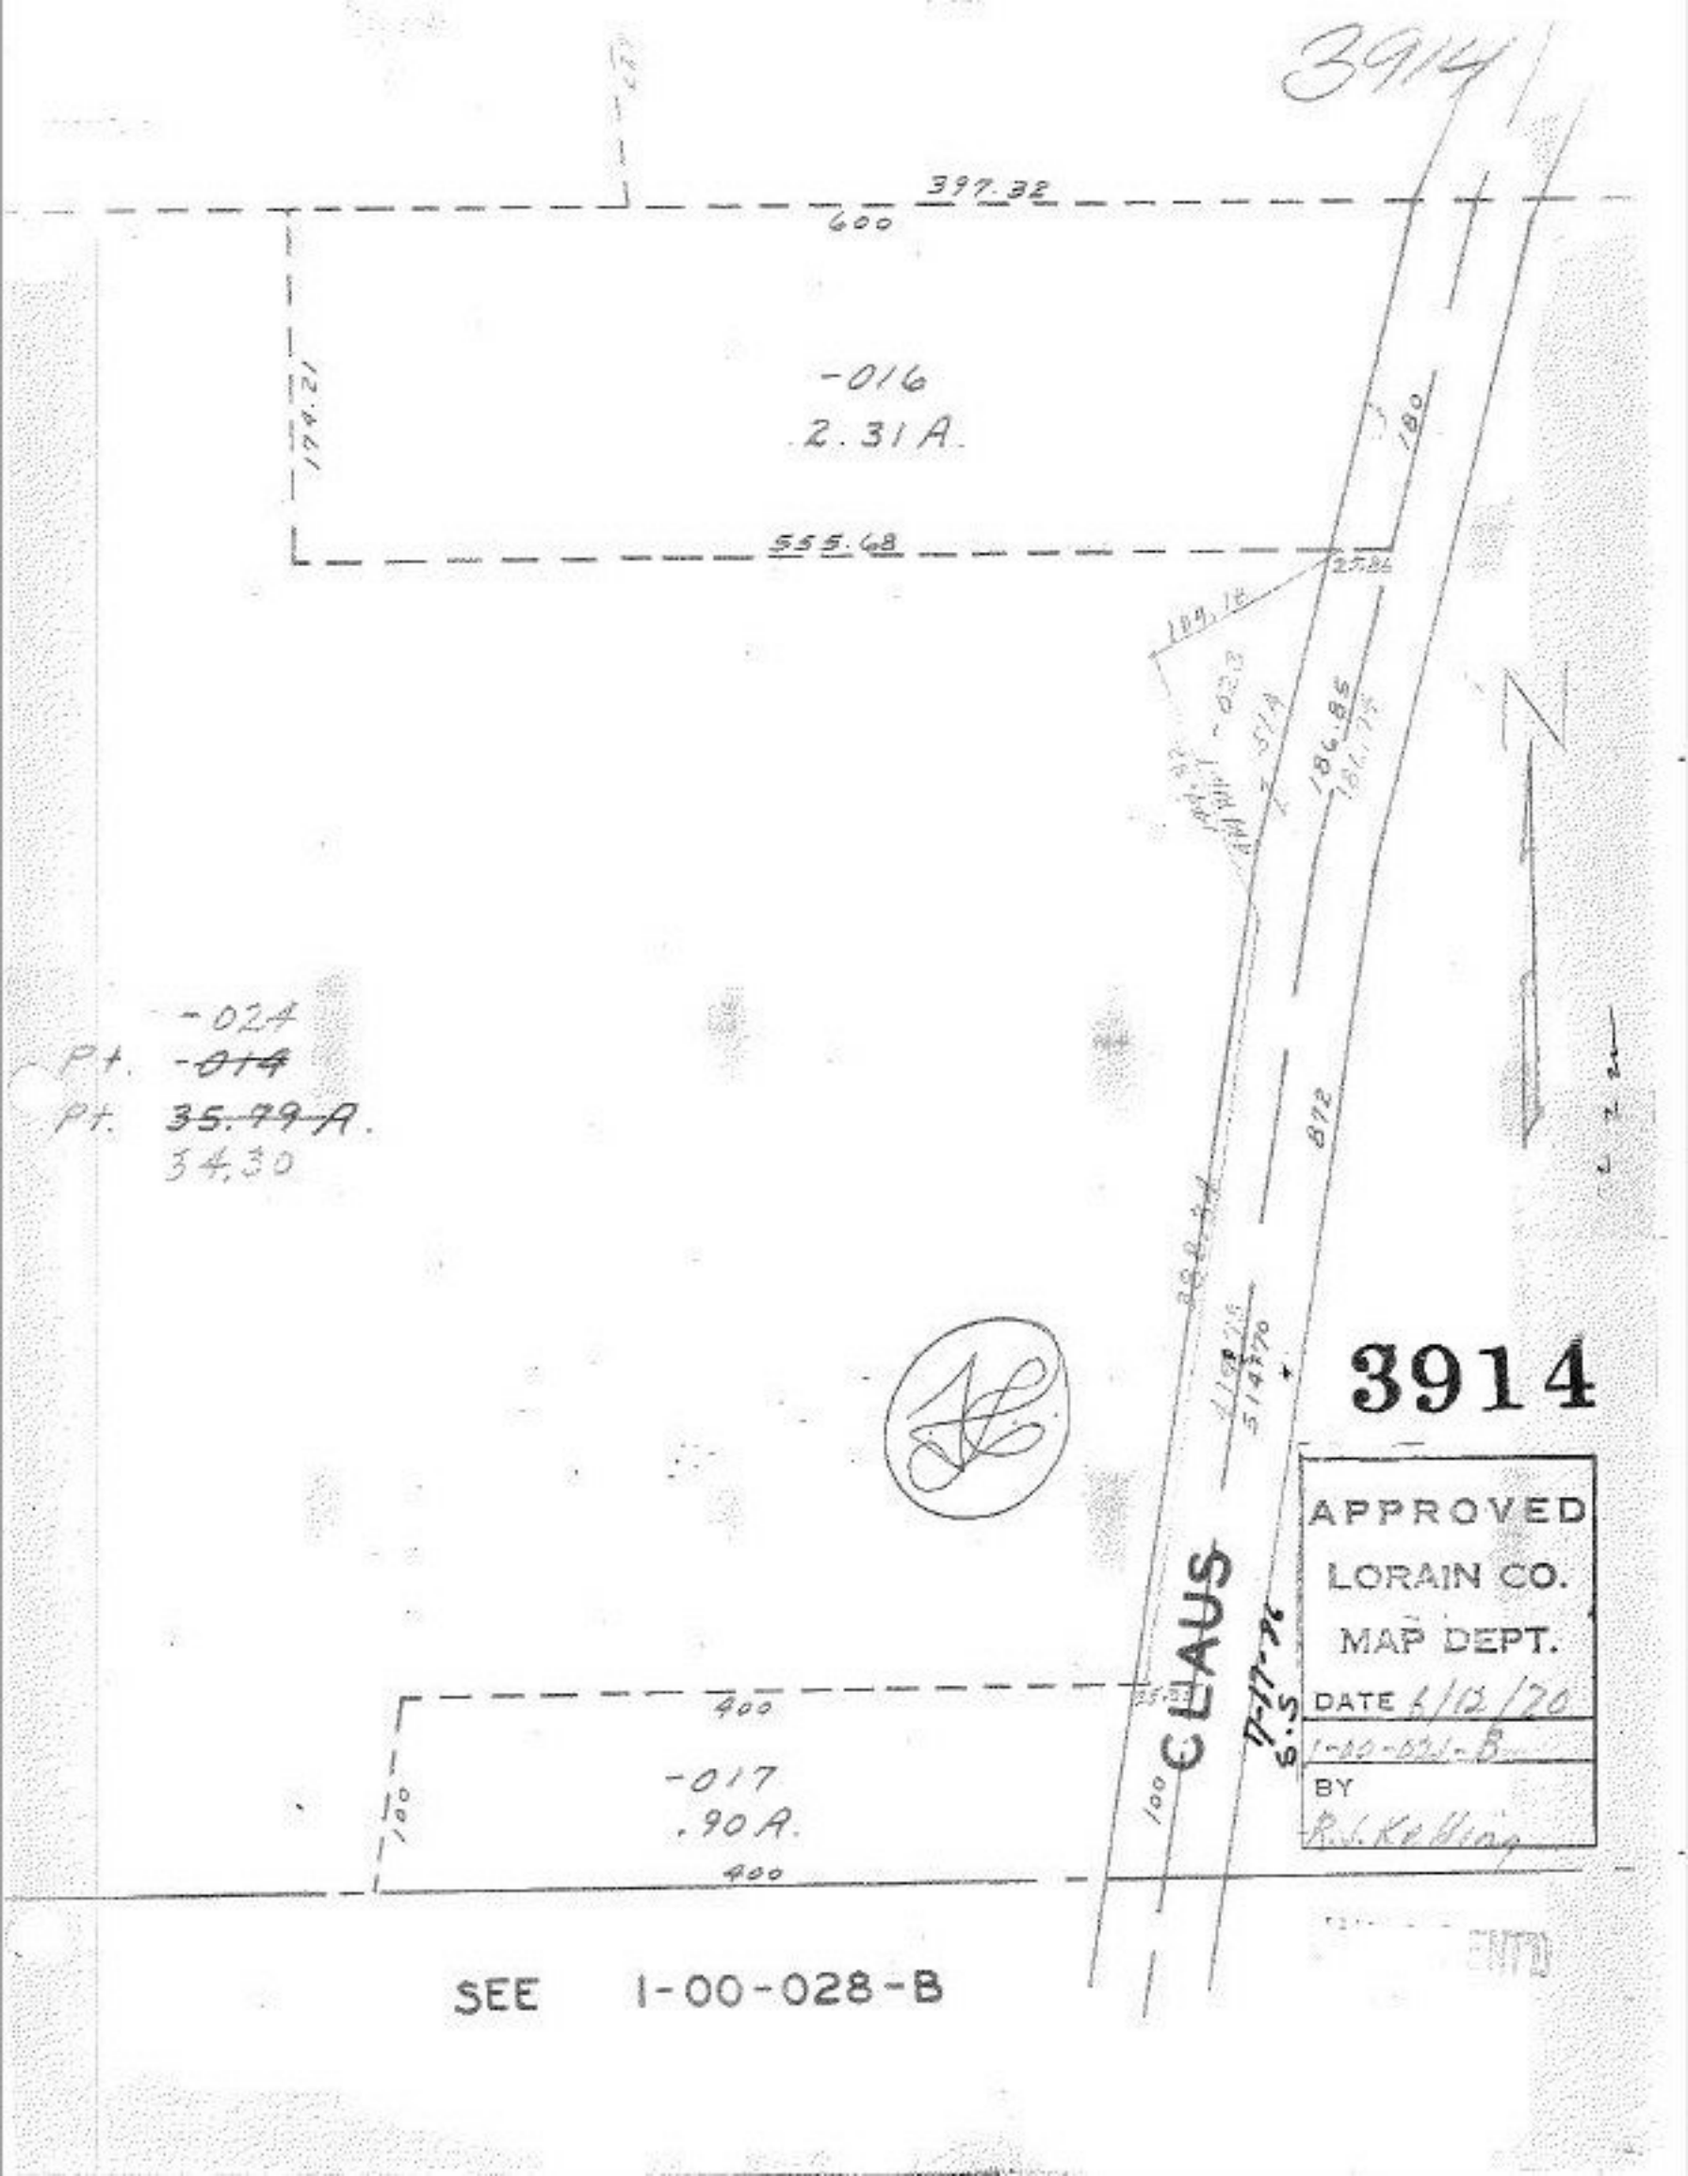
3914
397.32
600
-016
2.31 A.
174.21
555.68
180
186.85
181.75
-023
1.57 A.
-024
Pt. -014
Pt. 35.79 A.
34.30
872
3914
APPROVED
LORAIN CO.
MAP DEPT.
DATE 1/12/20
1-00-021-B
BY
R.J. Kelling
CLAUS
6.5
400
-017
.90 A.
100
400
SEE 1-00-028-B