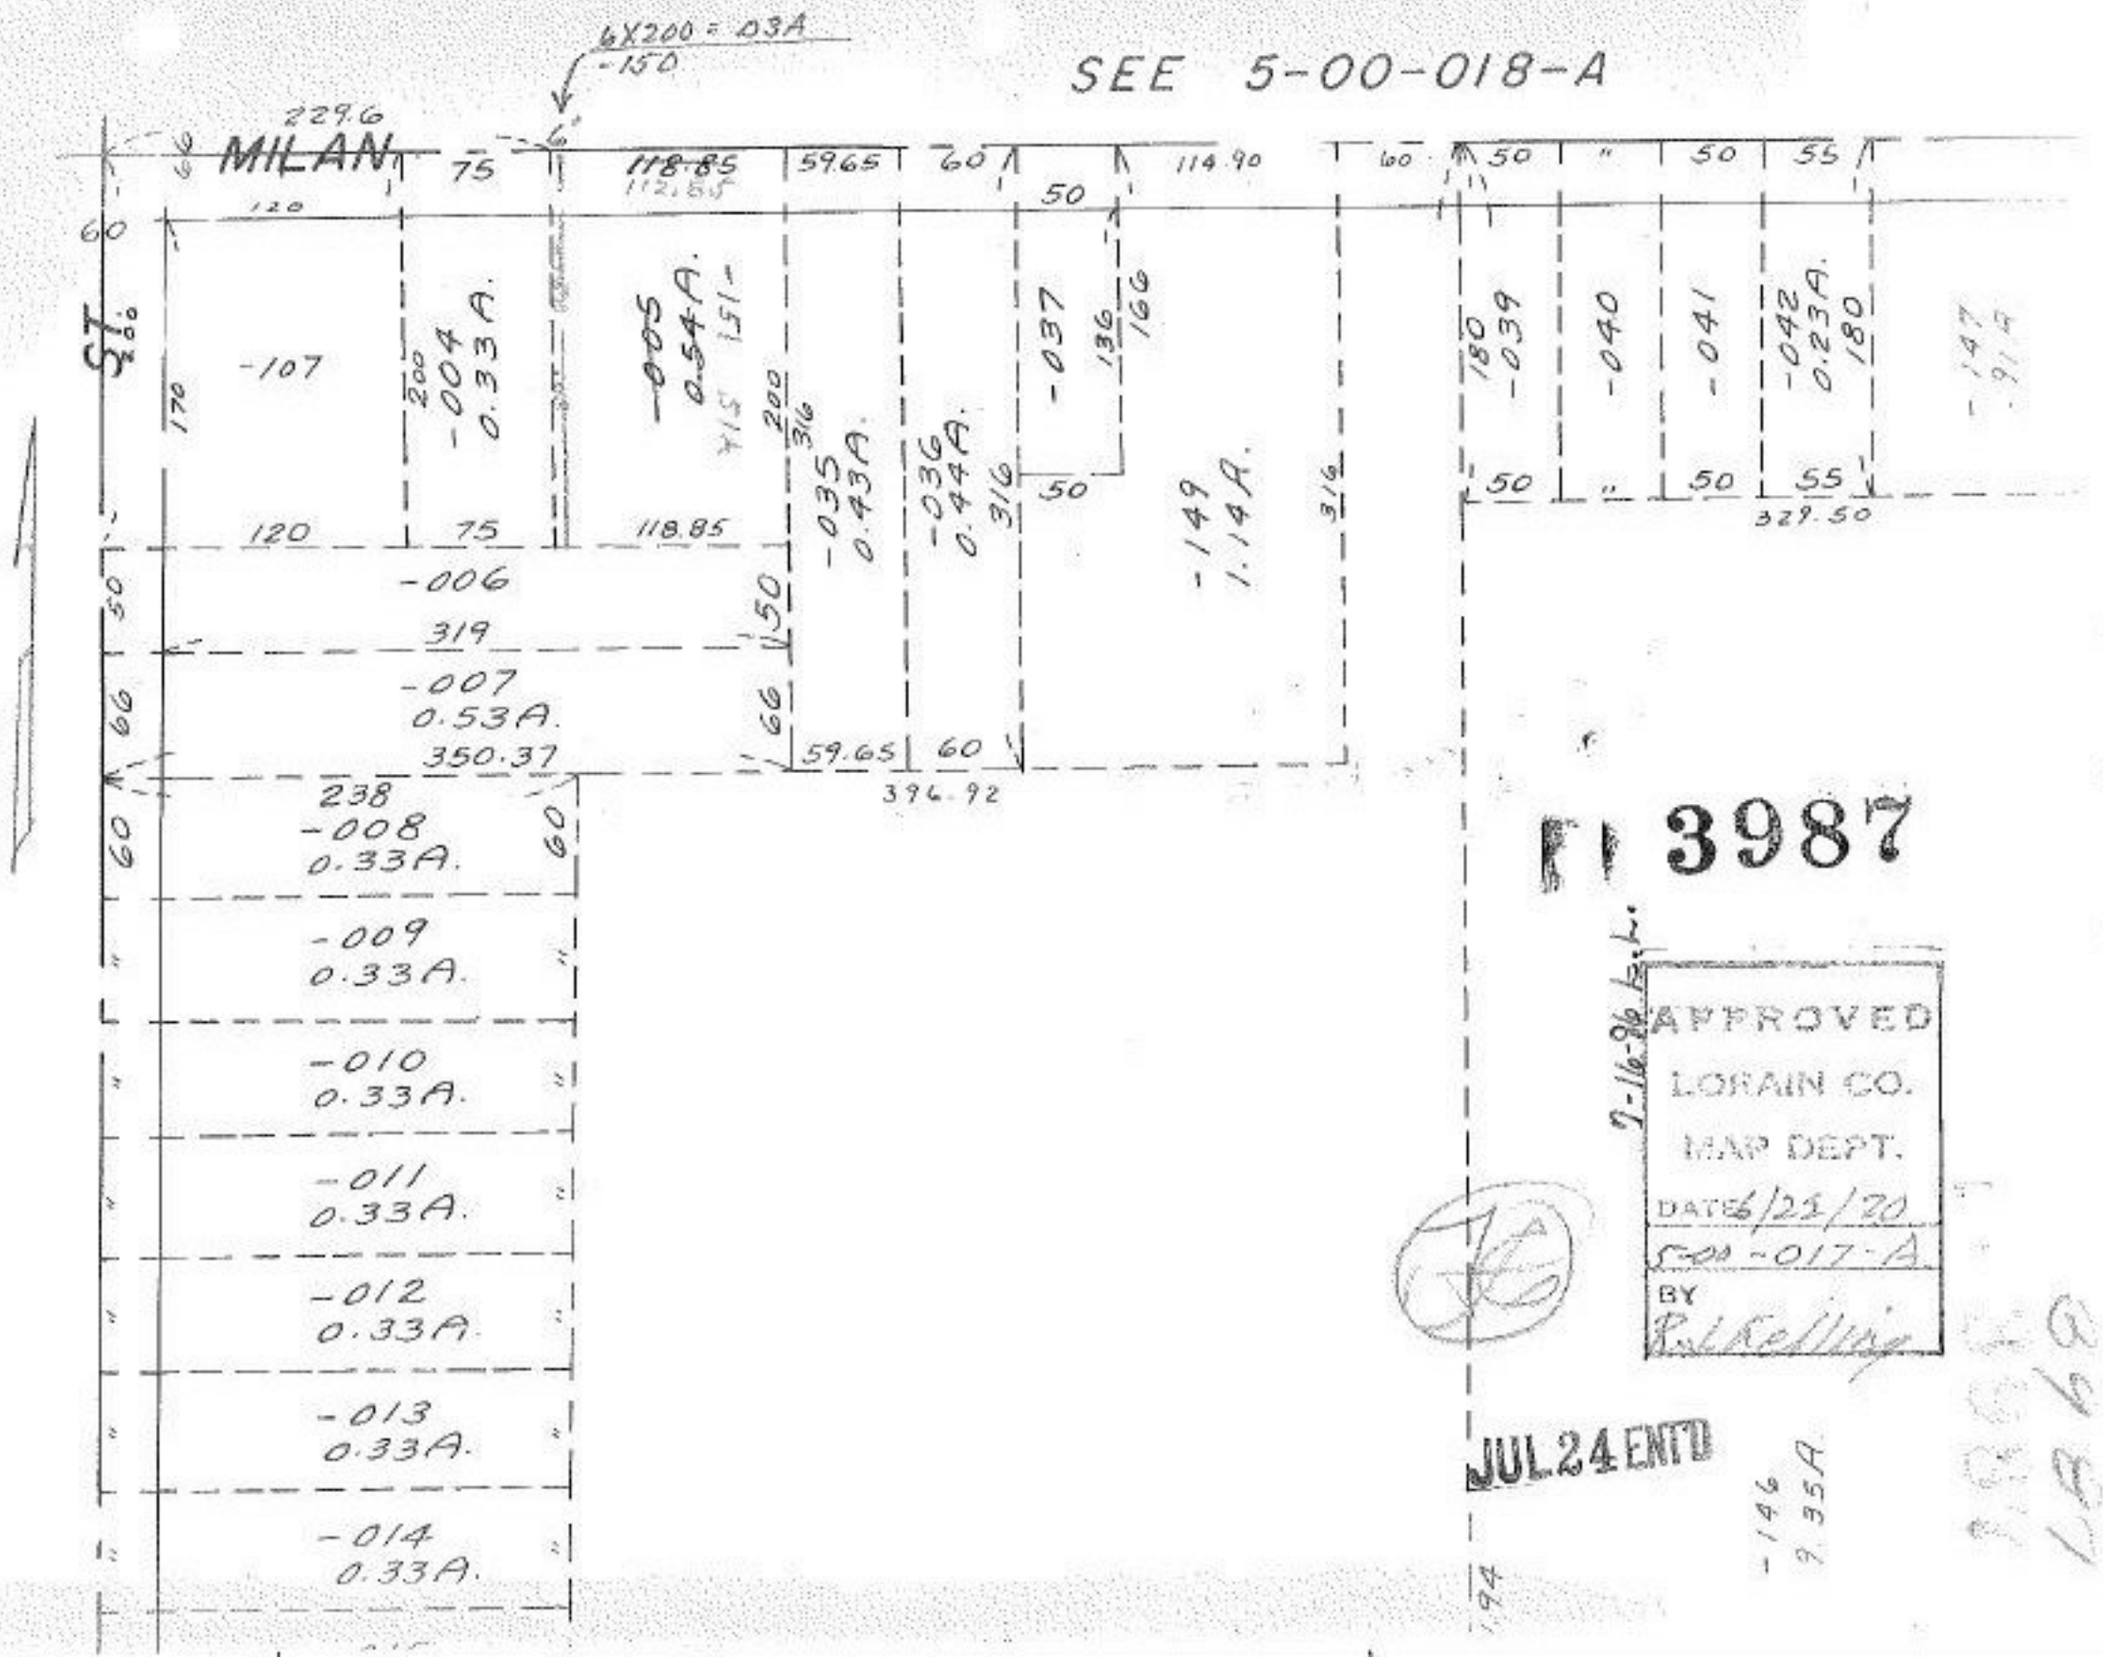

6X200 = .03A
-150
SEE 5-00-018-A
229.6
MILAN
ST.
-107
-004
0.33A.
-005
0.54A.
-035
0.43A.
-036
0.44A.
-037
-149
1.14A.
-039
-040
-041
-042
0.23A.
-147
-006
319
-007
0.53A.
350.37
238
-008
0.33A.
-009
0.33A.
-010
0.33A.
-011
0.33A.
-012
0.33A.
-013
0.33A.
-014
0.33A.
118.85
59.65
114.90
329.50
396.92
-146
9.35A
APPROVED
LORAIN CO.
MAP DEPT.
DATE 6/25/70
5-00-017-A
BY
JUL 24 ENT'D

3987