SEE 7-00-011-C
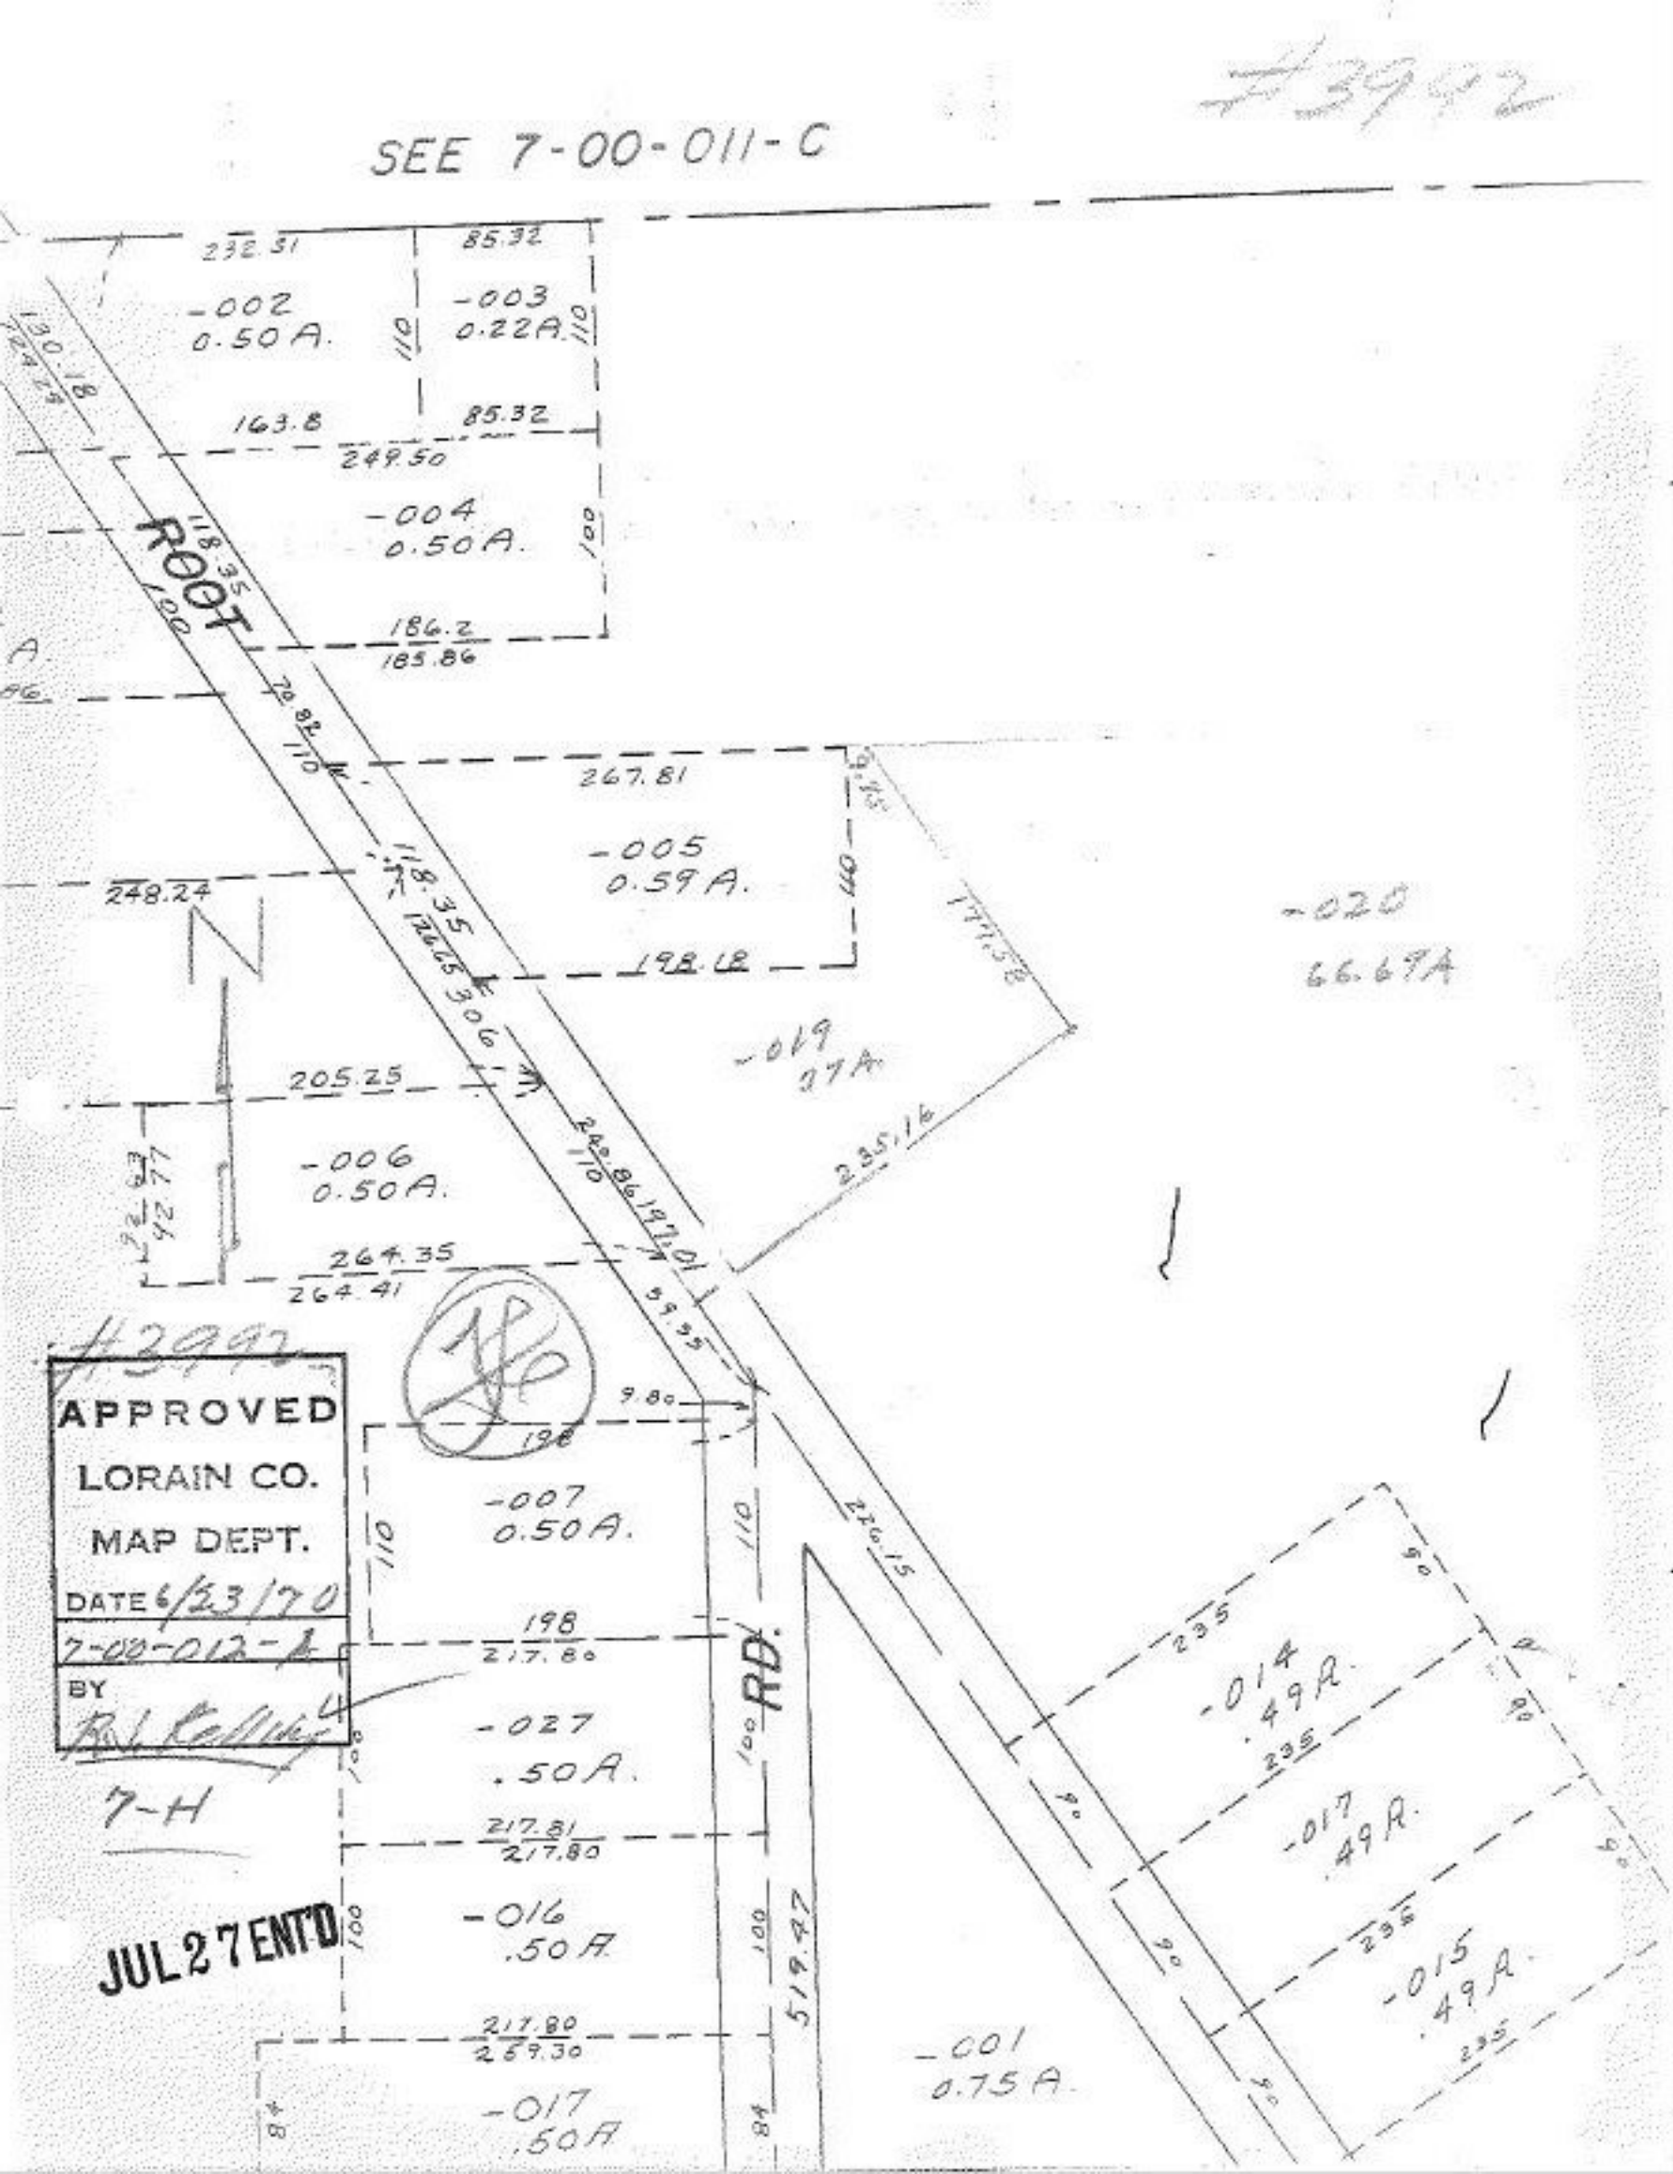
#3942