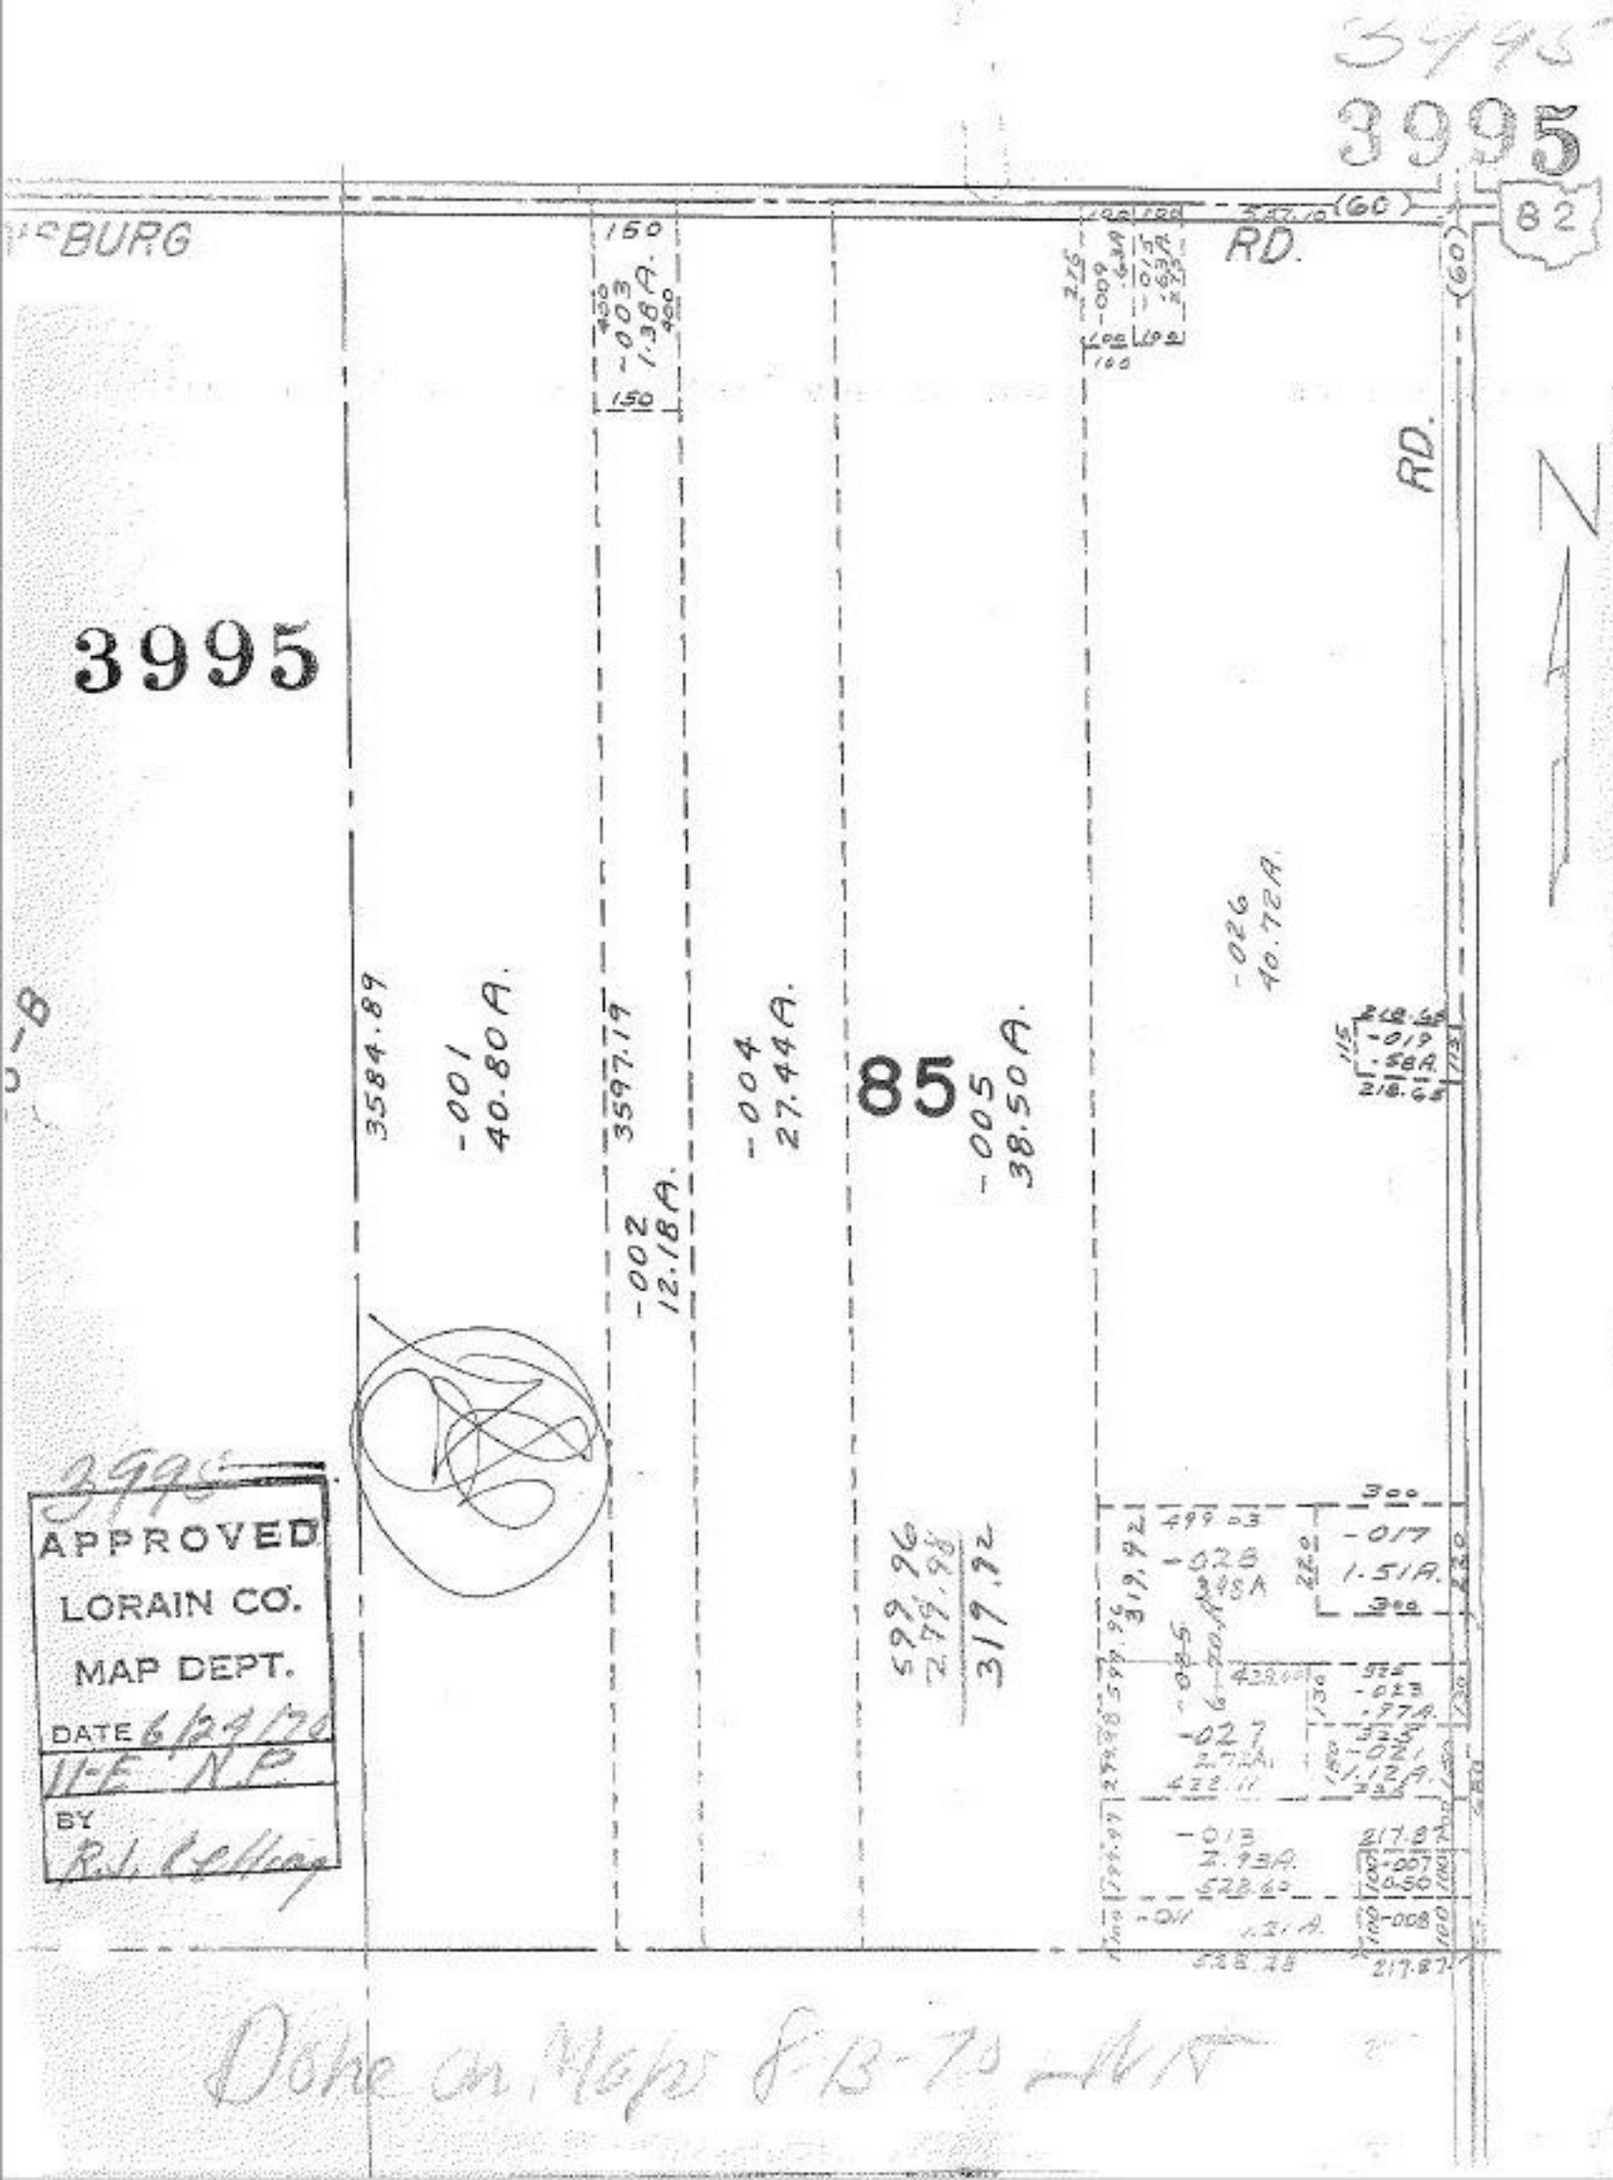
3995
3995
82
RD.
RD.
3995
-001
40.80 A.
-002
12.18A.
-004
27.44A.
85
-005
38.50A.
-026
40.72A.
-027
-017
1.51A.
APPROVED
LORAIN CO.
MAP DEPT.
DATE 6/27/20
11-E NP
BY
R.L. Collins
Done on Map f-13-75-MT