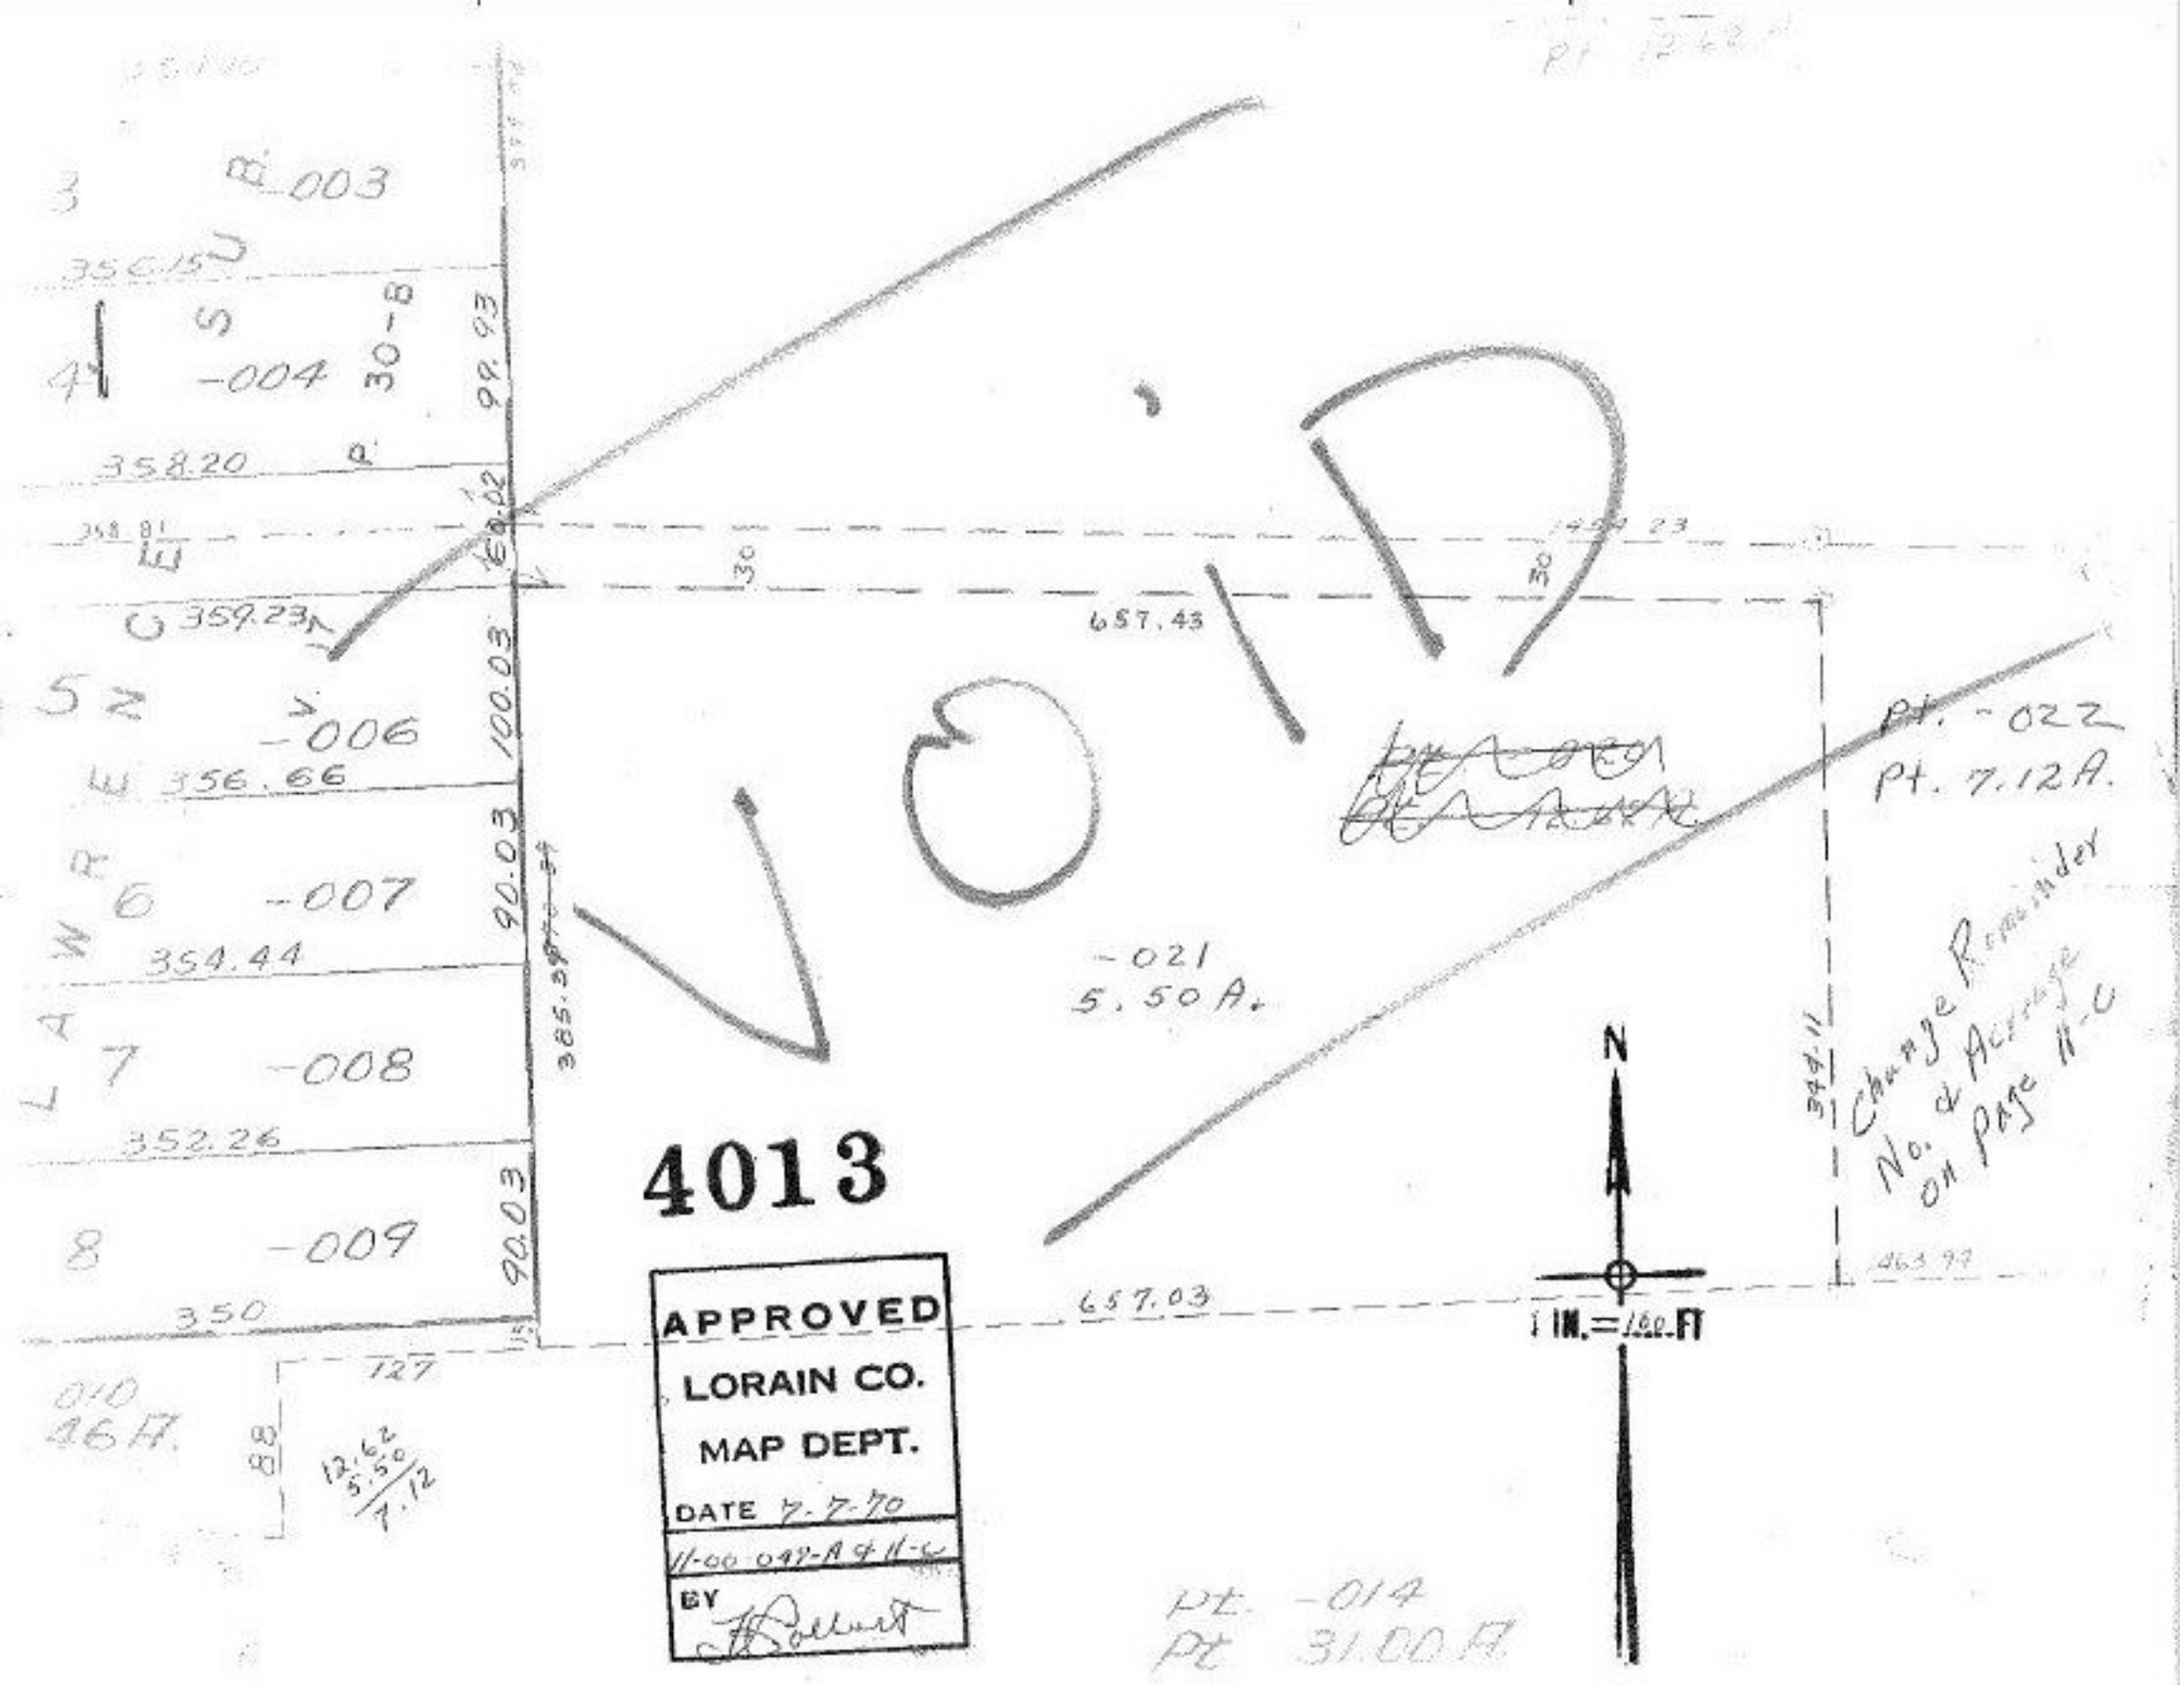
VOID
4013
APPROVED
LORAIN CO.
MAP DEPT.
DATE 7-7-70
11-00 049-A & 11-U
BY
N
1 IN. = 100 FT
Change Remainder
No. of Acreage
on Page 11-U
Pt. -022
Pt. 7.12A.
-021
5.50 A.
Pt. -014
Pt 31.00 FT
657.43
657.03
100.03
90.03
90.03
90.03
99.93
100.02
344.11
463.99
385.39
358.20
359.23
356.66
354.44
352.26
350
127
88
12.62
5.50
7.12
010
46 FT.