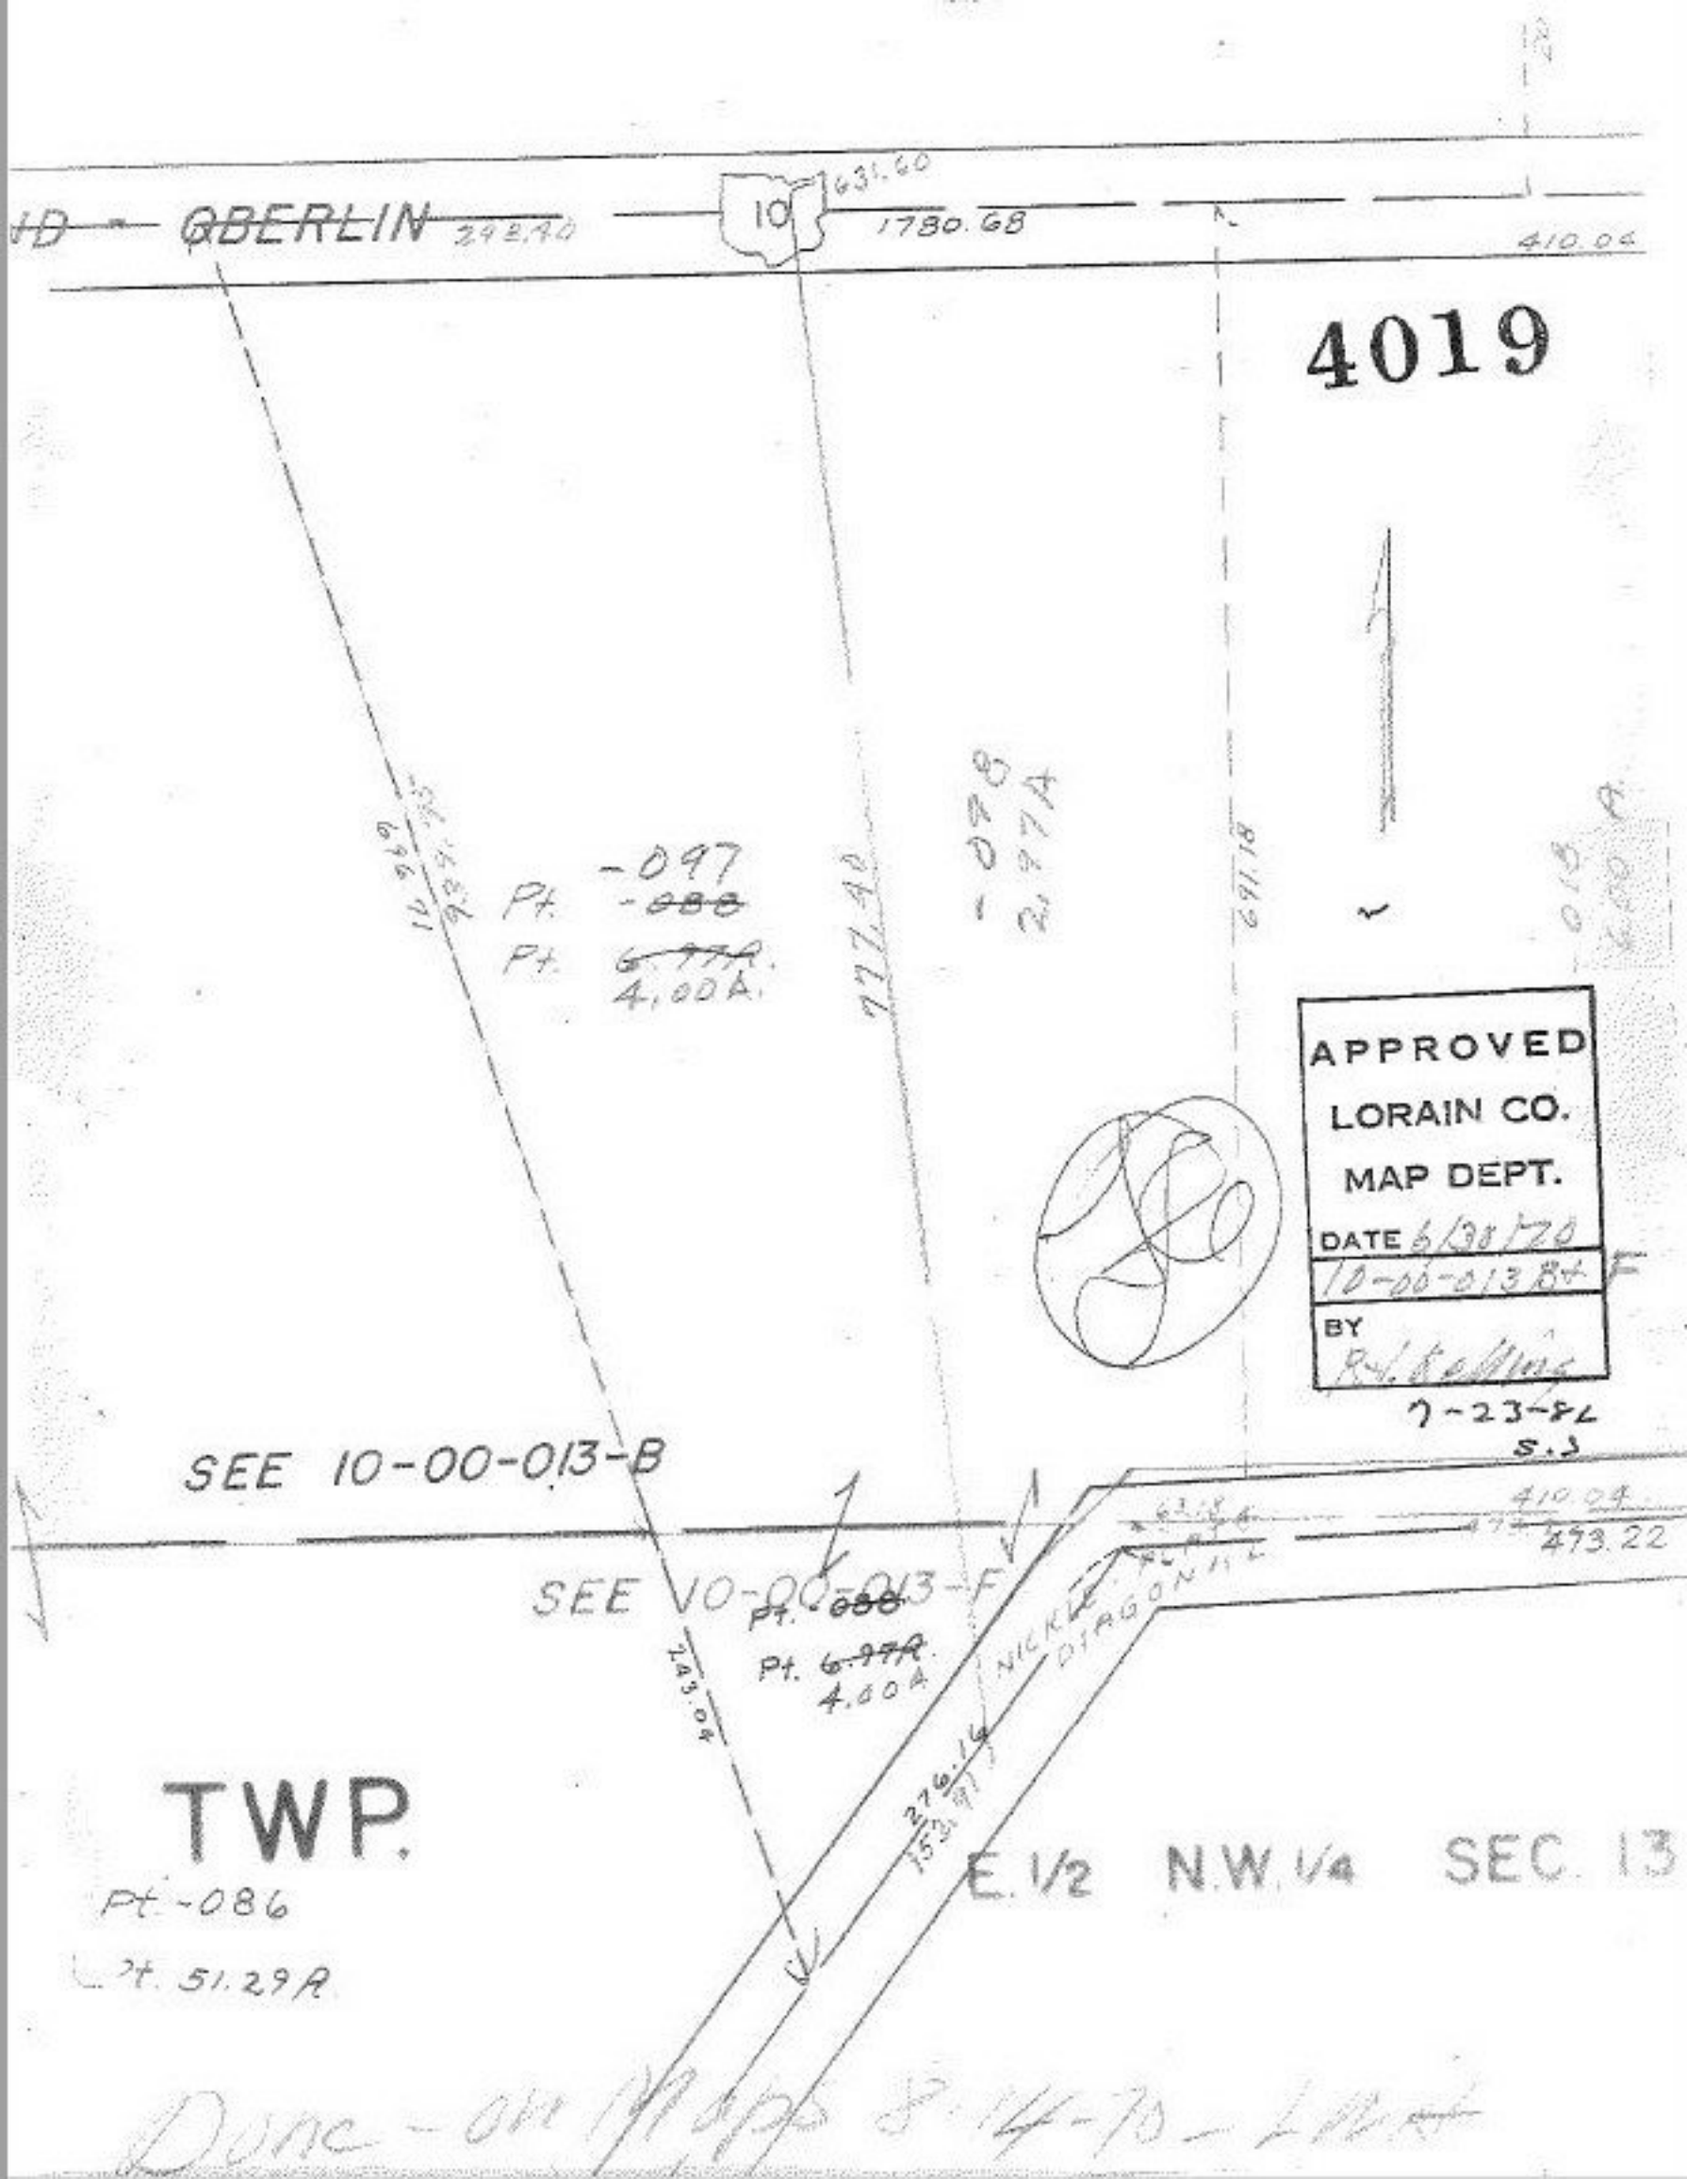
HD - OBERLIN
292.70
10
631.60
1780.68
410.04
4019
-097
Pt. -088
Pt. 6.77A.
4.00A.
277.40
-098
2.17A
691.18
APPROVED
LORAIN CO.
MAP DEPT.
DATE 6/30/70
10-00-013 B+ F
BY
7-23-71
S.J
SEE 10-00-013-B
410.09
473.22
SEE 10-00-013-F
Pt. -088
Pt. 6.77A.
4.00A
243.04
276.14
152.91
NICKEL PLATE DIAGONAL
TWP.
Pt. -086
Pt. 51.29A
E. 1/2 N.W. 1/4 SEC. 13
Dup - on Maps P. 14-70 - Lbl