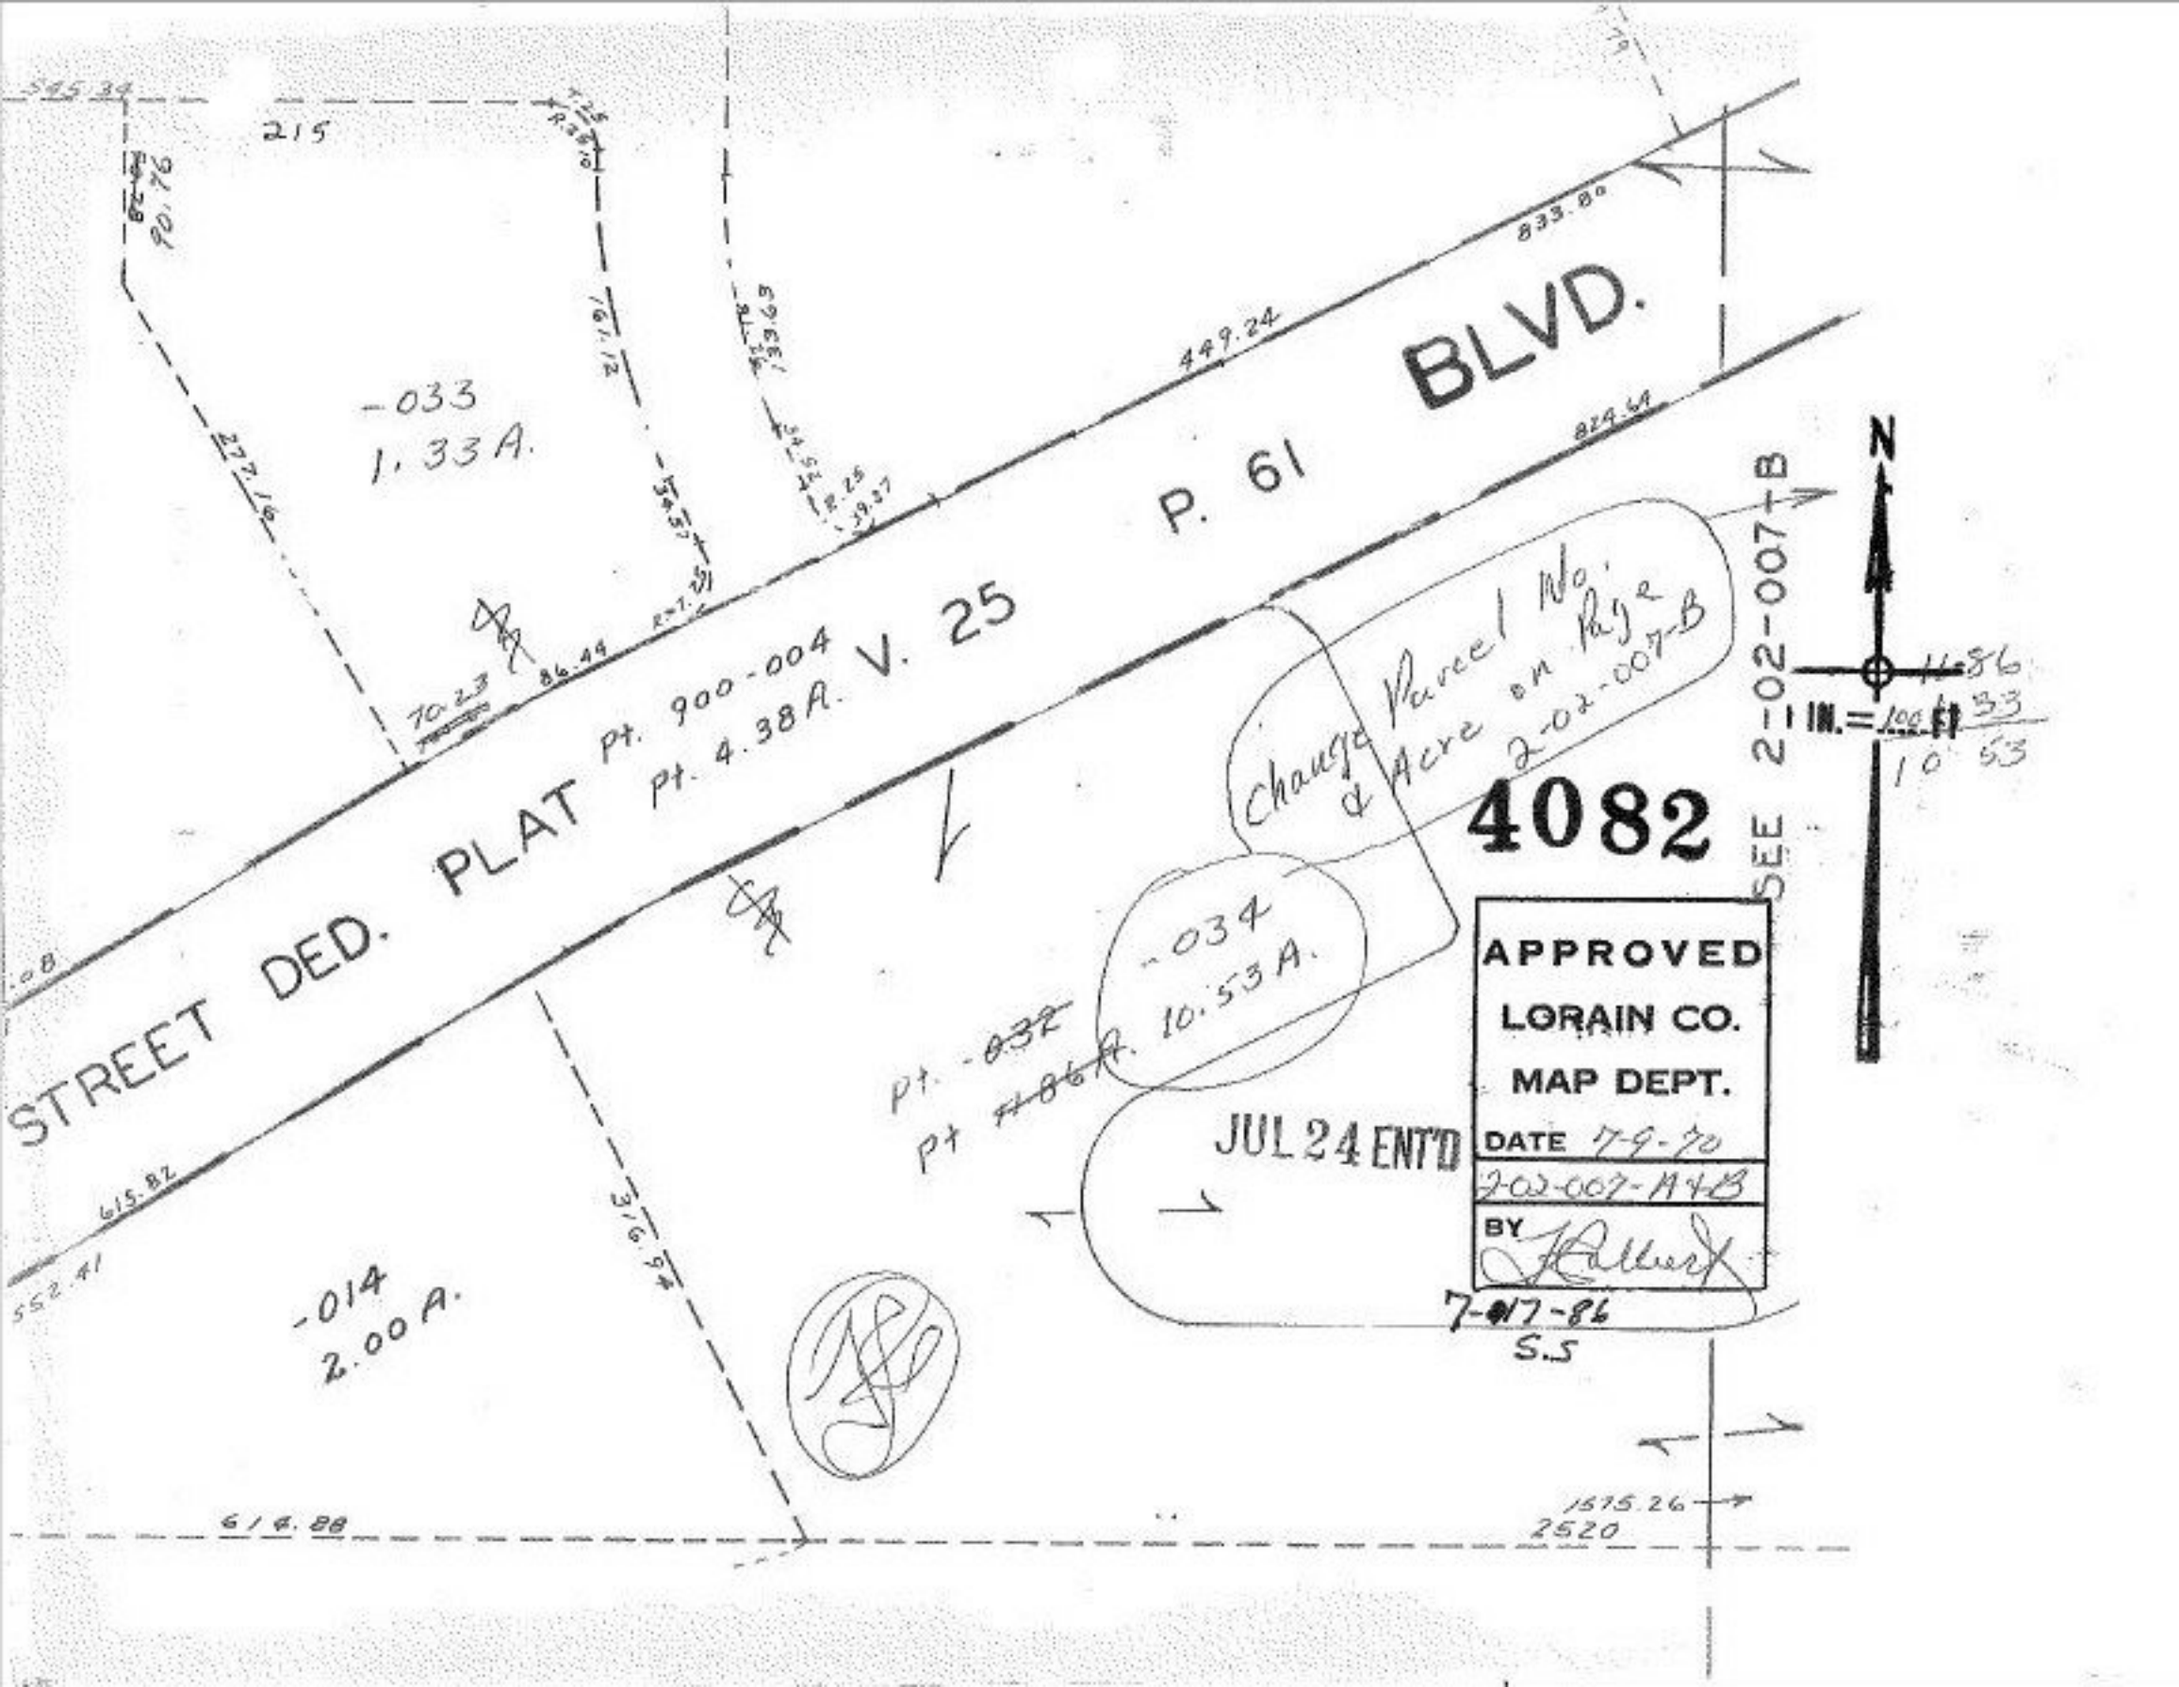

STREET DED. PLAT
V. 25
P. 61
BLVD.
Pt. 900-004
Pt. 4.38 A.
-033
1.33 A.
-014
2.00 A.
-034
10.53 A.
Pt. -032
Pt 11.86 A.
Change Parcel No. & Acre on Page 2-02-007-B
4082
SEE 2-02-007-B
N
1 IN. = 100 FT
APPROVED
LORAIN CO.
MAP DEPT.
DATE 7-9-70
2-02-007-A+B
BY
7-17-86
S.S
JUL 24 ENT'D
215
449.24
833.80
824.64
615.82
552.41
316.94
614.88
1575.26
2520