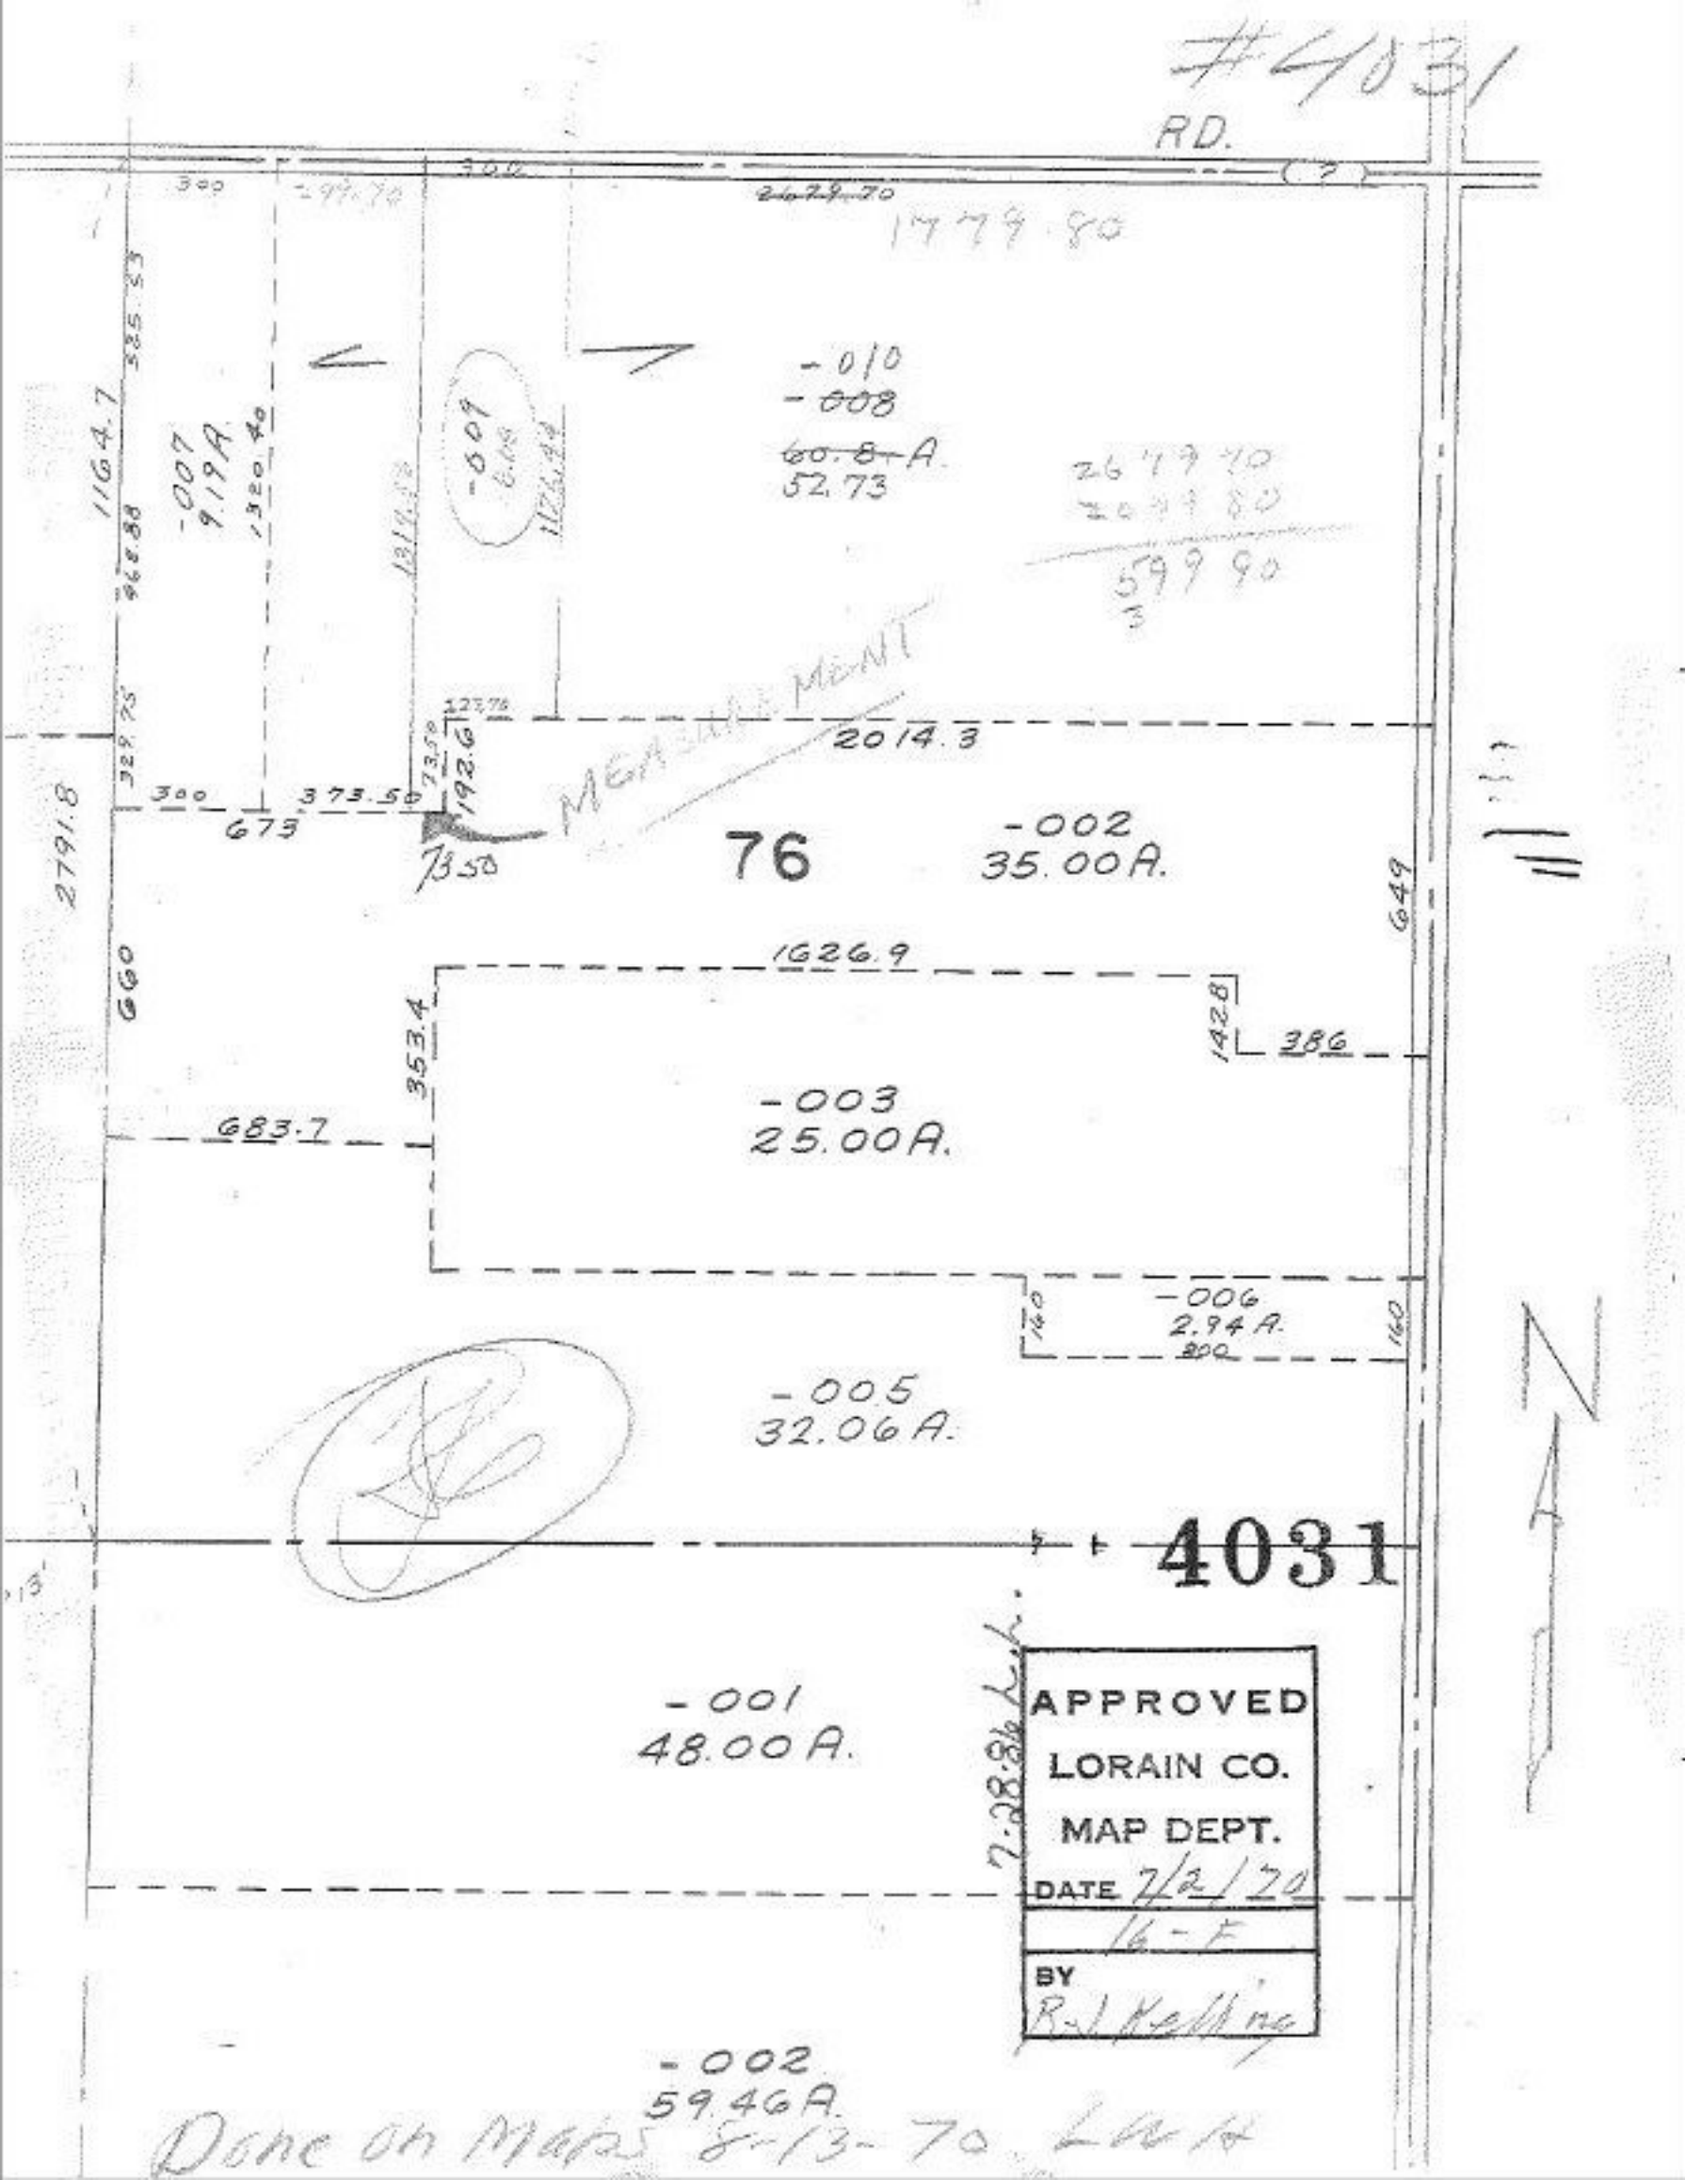
#4031
RD.
1779.80
-010
-008
60.8 A.
52.73
2679.70
2099.80
599.90
-007
9.19A.
1320.40
1164.7
MEASUREMENT
2014.3
373.50
673
73.50
192.6
76
-002
35.00A.
2791.8
649
660
1626.9
353.4
142.8
386
683.7
-003
25.00A.
-006
2.94 A.
-005
32.06 A.
4031
-001
48.00 A.
APPROVED
LORAIN CO.
MAP DEPT.
DATE 7/2/70
16-F
BY
R.J. Kelling
-002
59.46A.
Done on Maps 8-13-70 LWH