HENRIETTA TWP.

SCALE: 1" = 400'

Copyright 1964

8-E

Revised 6-22-70

AUG 14 ENT'D

Done on Maps

4052

APPROVED
LORAIN CO.
MAP DEPT.
DATE 7-6-70
8-E
BY
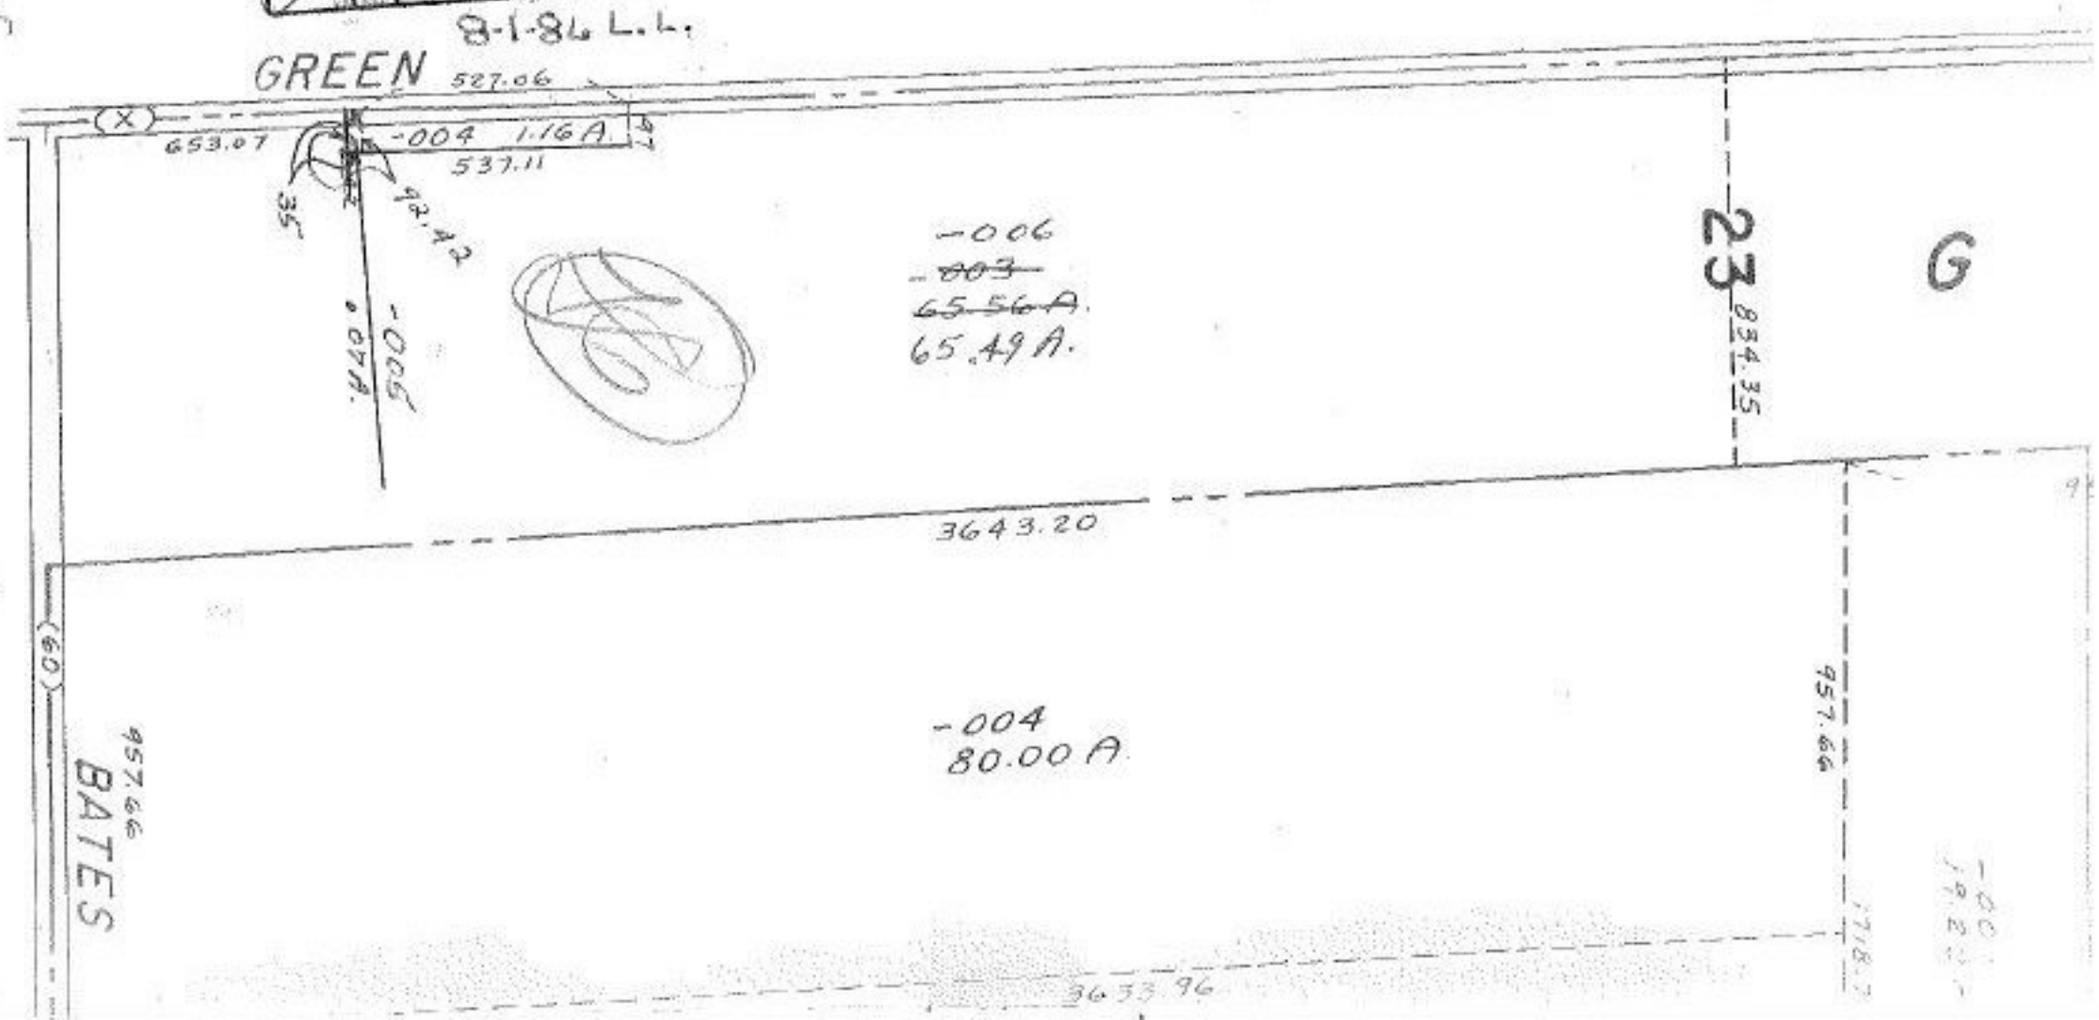
8-1-86 L.L.