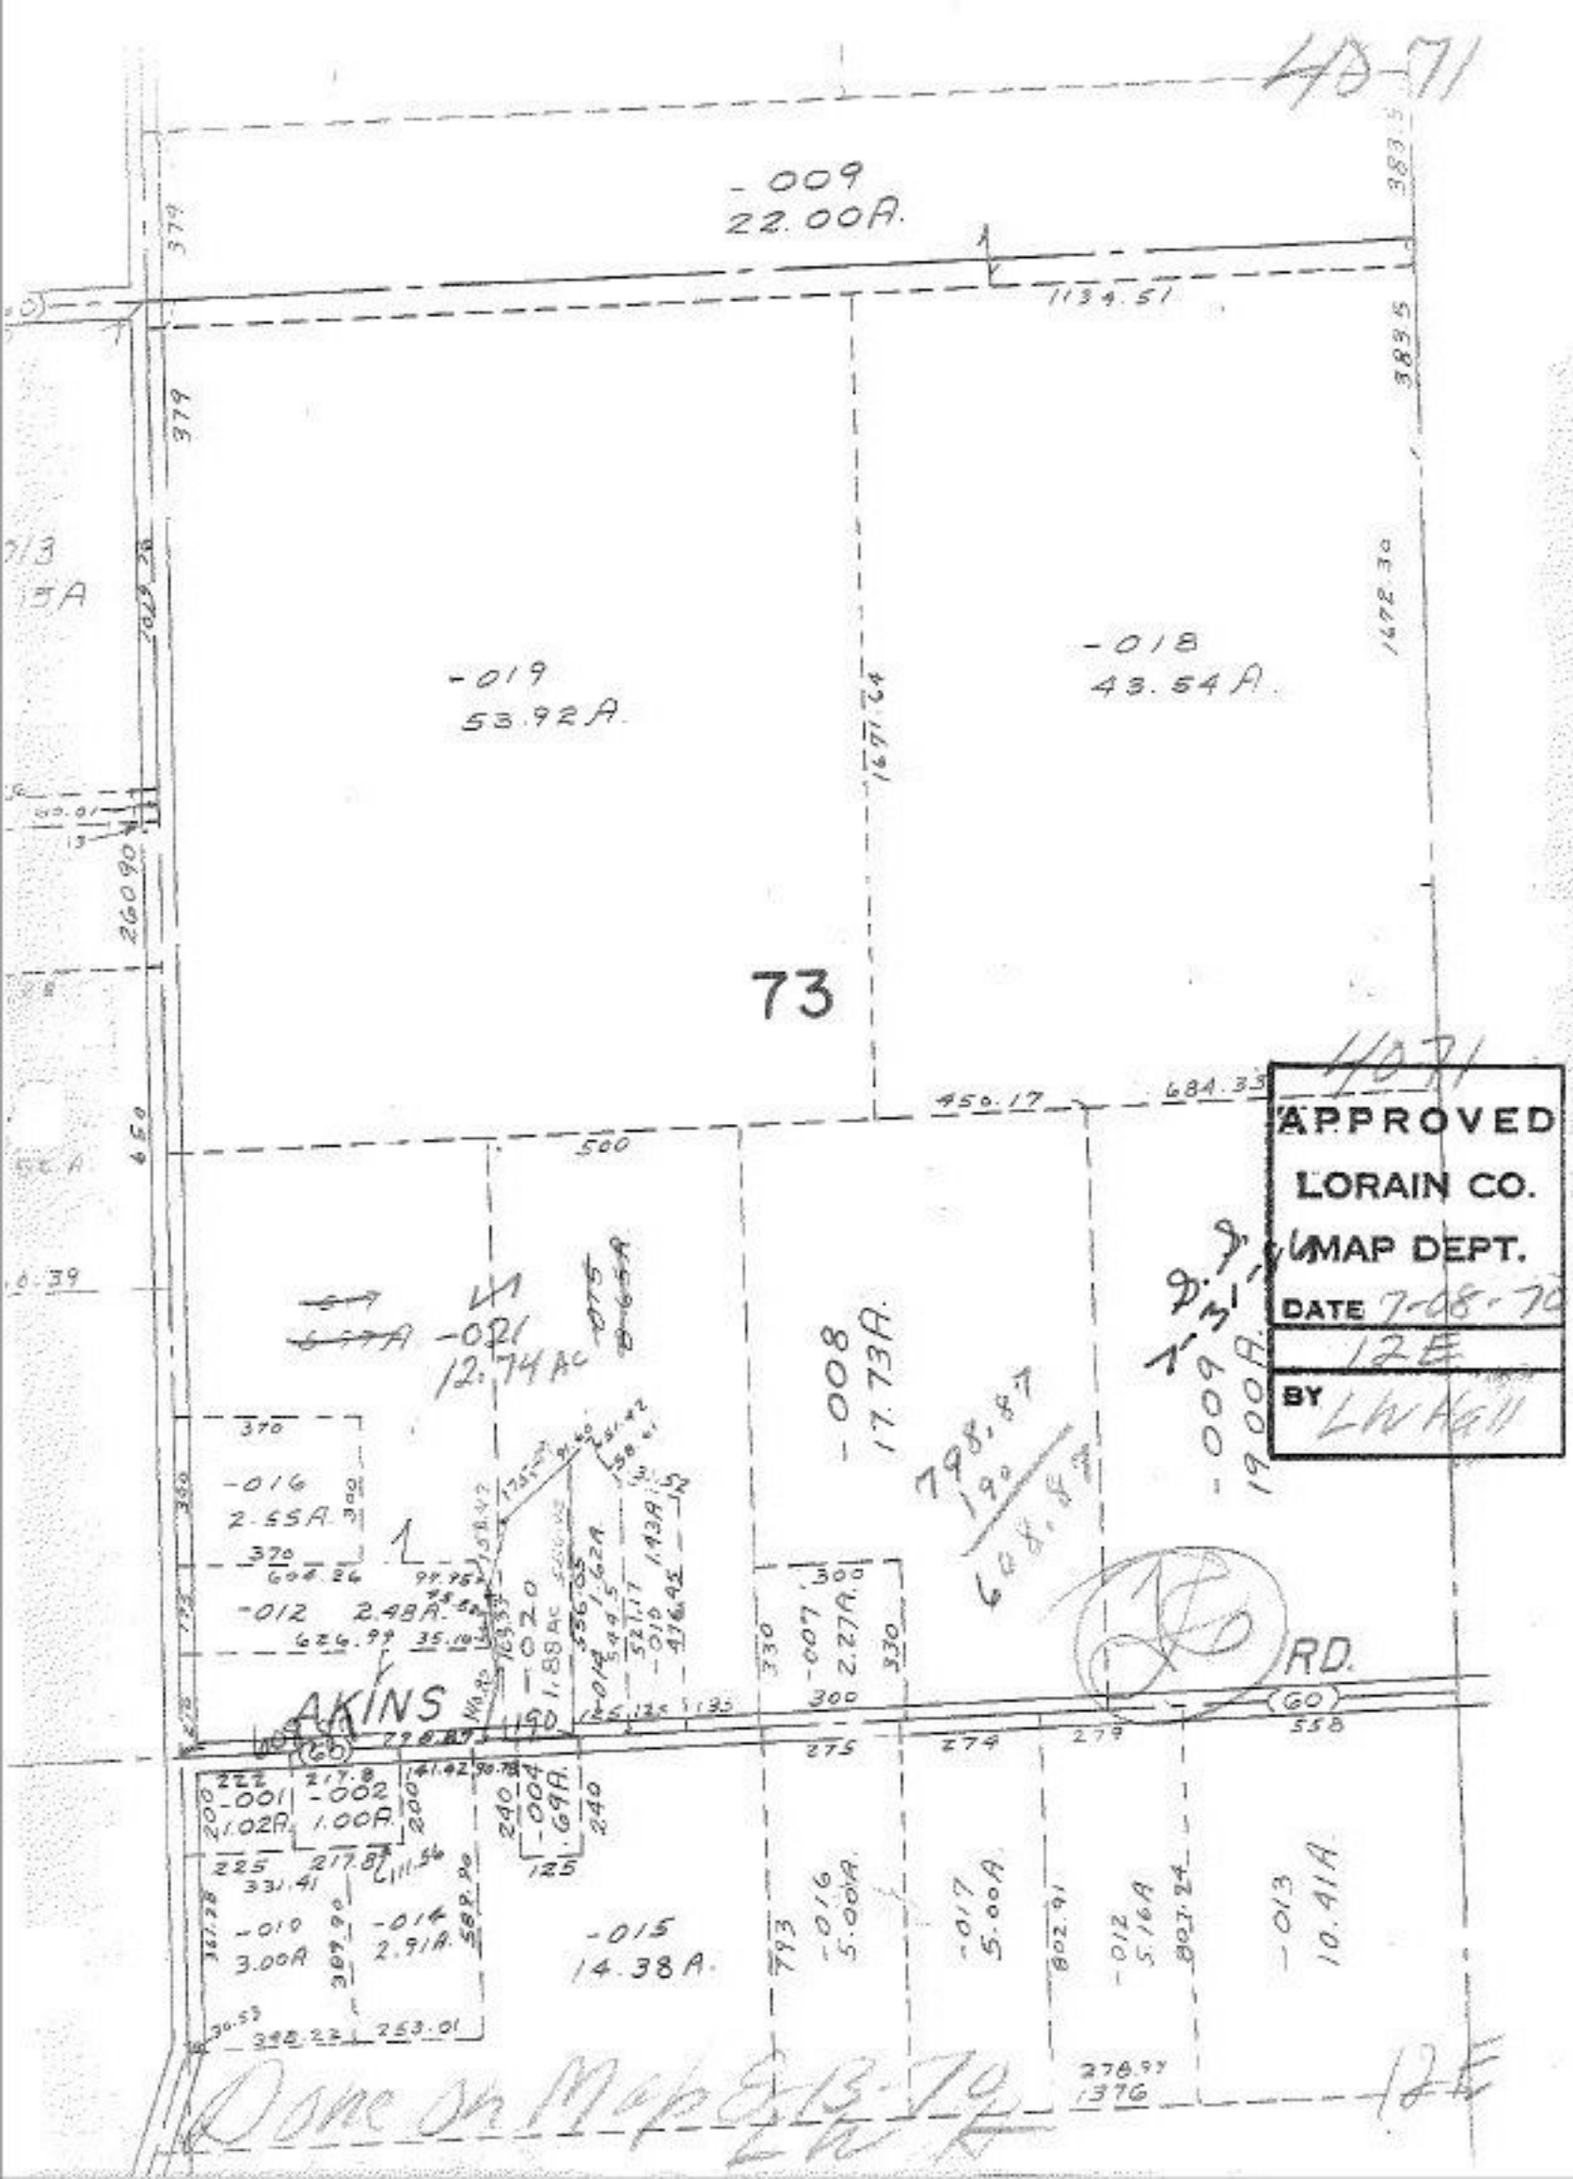
-009
22.00A.
1134.51
-019
53.92A.
-018
43.54A.
1671.64
73
450.17
684.35
APPROVED
LORAIN CO.
MAP DEPT.
DATE 7-08-70
12E
BY LWKell
-021
12.74AC
-008
17.73A.
-009
19.00A.
-016
2.55A.
-012
2.48A.
-020
1.88AC
-007
2.27A.
AKINS RD.
-001
1.02A.
-002
1.00A.
-004
.69A.
-010
3.00A
-014
2.91A.
-015
14.38A.
-016
5.00A.
-017
5.00A.
-012
5.16A
-013
10.41A.
Done on Map 8-13-70
12E