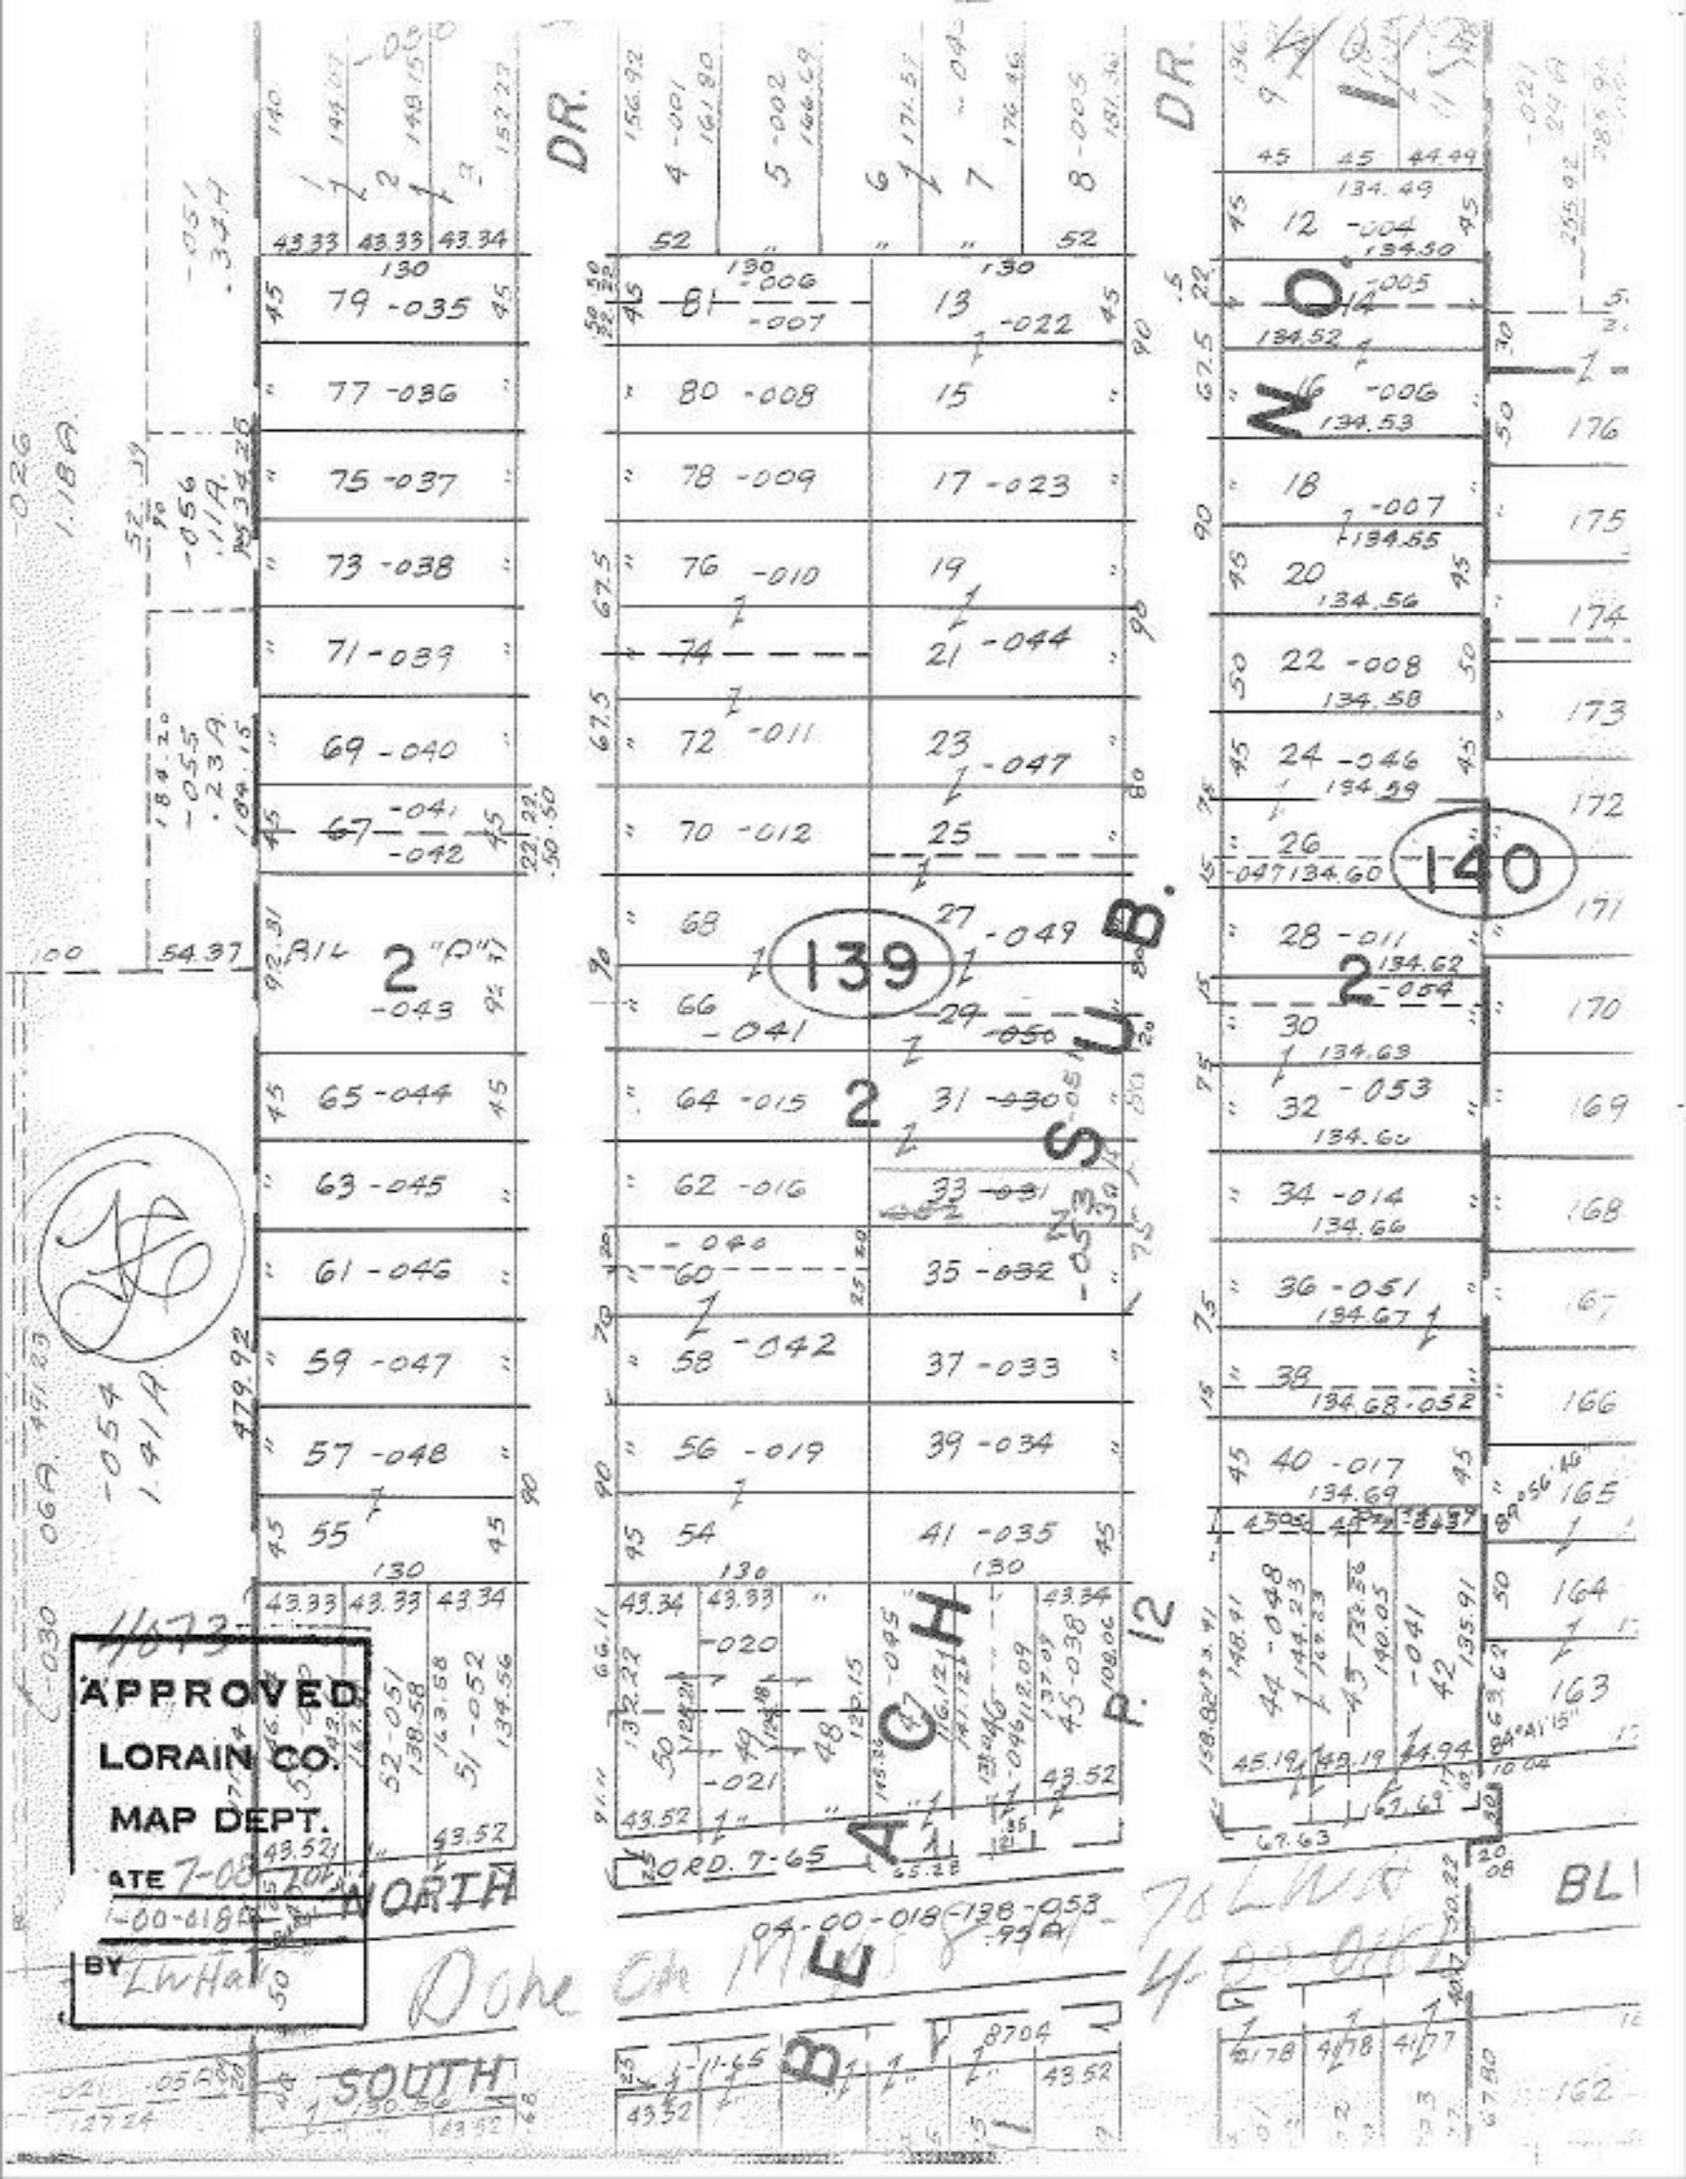
DR.
DR.
NO.
1
2
SUB.
139
140
BEACH
APPROVED
LORAIN CO.
MAP DEPT.
DATE 7-08
BY LWH
SOUTH
NORTH
P. 12
04-00-018-138-053
79 -035
77 -036
75 -037
73 -038
71 -039
69 -040
67 -041
-042
65 -044
63 -045
61 -046
59 -047
57 -048
55
81 -006
-007
80 -008
78 -009
76 -010
74
72 -011
70 -012
68
66 -041
64 -015
62 -016
60 -040
58 -042
56 -019
54
13 -022
15
17 -023
19
21 -044
23 -047
25
27 -049
29 -050
31 -030
33 -031
35 -032
37 -033
39 -034
41 -035
12 -004
14 -005
16 -006
18 -007
20
22 -008
24 -046
26 -047
28 -011
-054
30
32 -053
34 -014
36 -051
38 -052
40 -017
44 -048
-045
42 -041
43 -038
-046
-020
-021
48
49
52 -051
51 -052
-054
-055
-056
-026
-027
-030
-031
-033
-034
