4102

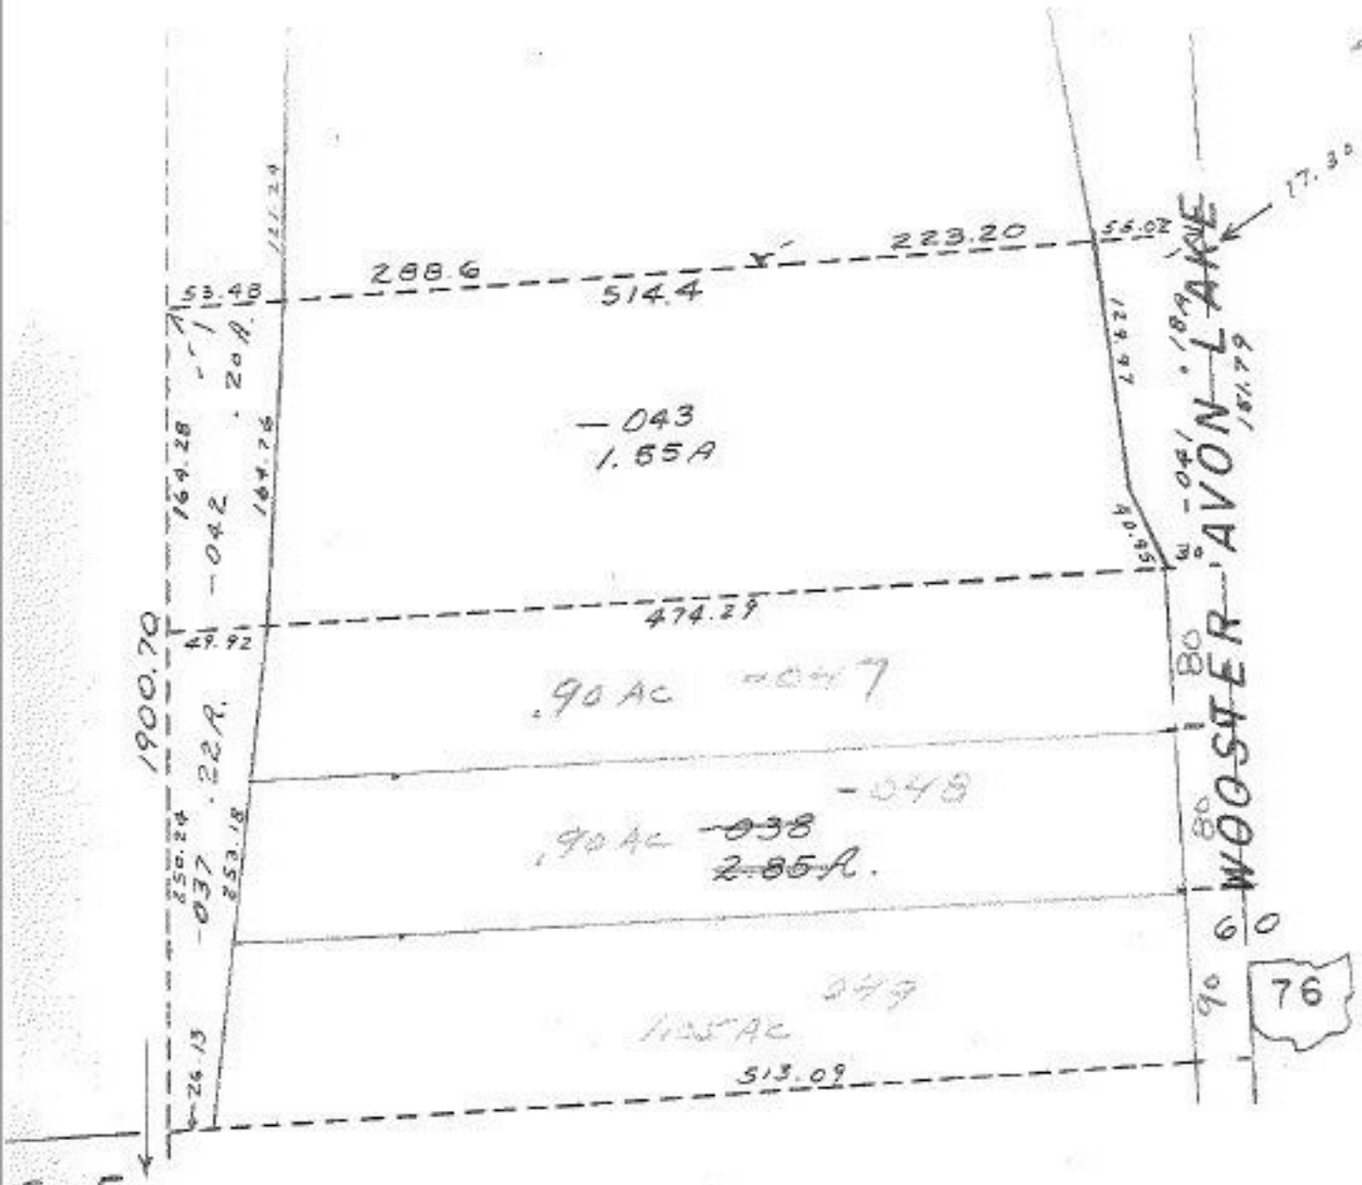


5-F

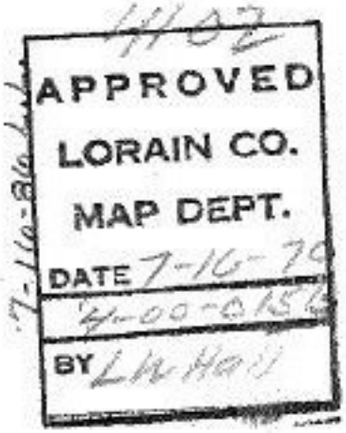


Done On Maps 8-10-79 LH

4-00-015B

E 1/2 NW 1/4 SEC. 15