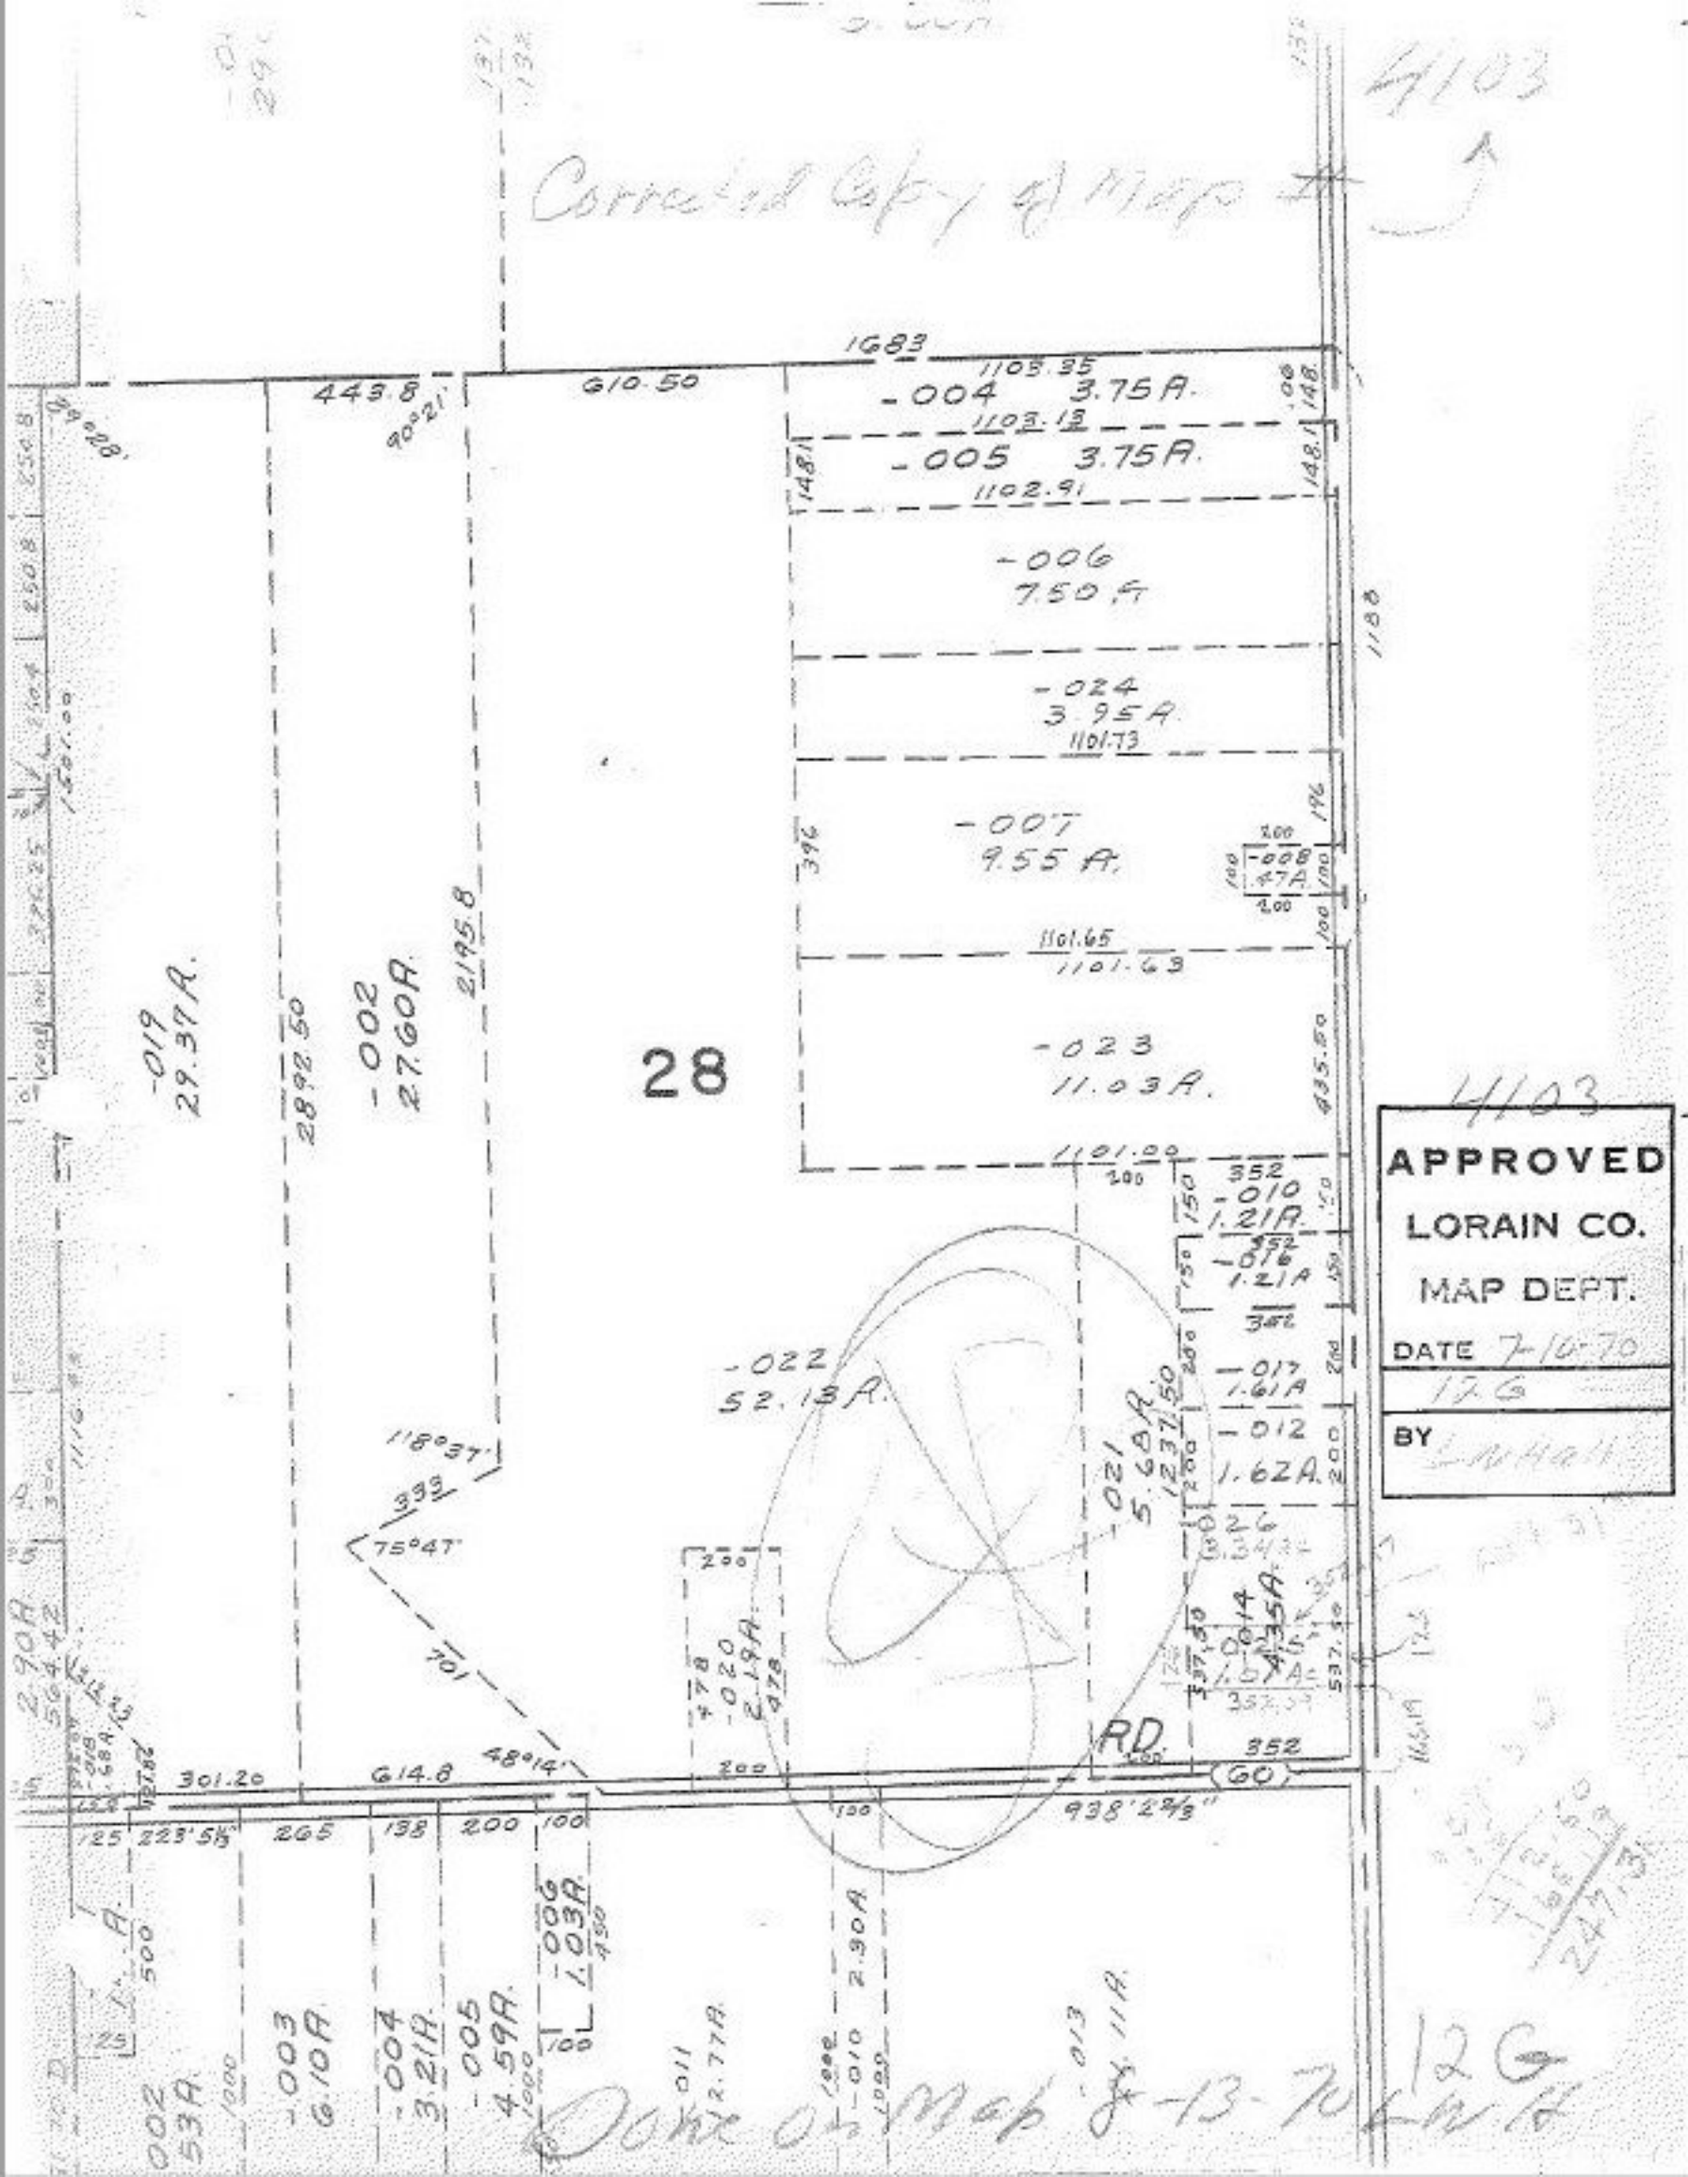

4103
Corrected Copy of Map #
1683
443.8
610.50
-004 3.75A.
-005 3.75A.
-006 7.50A
-024 3.95A.
-007 9.55A.
-008 .47A.
-023 11.03A.
-019 29.37A.
-002 27.60A.
28
-010 1.21A.
-016 1.21A
-017 1.61A
-012 1.62A.
-022 52.13A.
-021 5.68A.
-014 4.35A.
-020 2.19A.
RD.
60
301.20
614.8
938'2 2/3"
-006 1.03A.
-003 6.10A.
-004 3.21A.
-005 4.59A.
APPROVED
LORAIN CO.
MAP DEPT.
DATE 7-10-70
12G
BY
Done on Map 8-13-70
12G