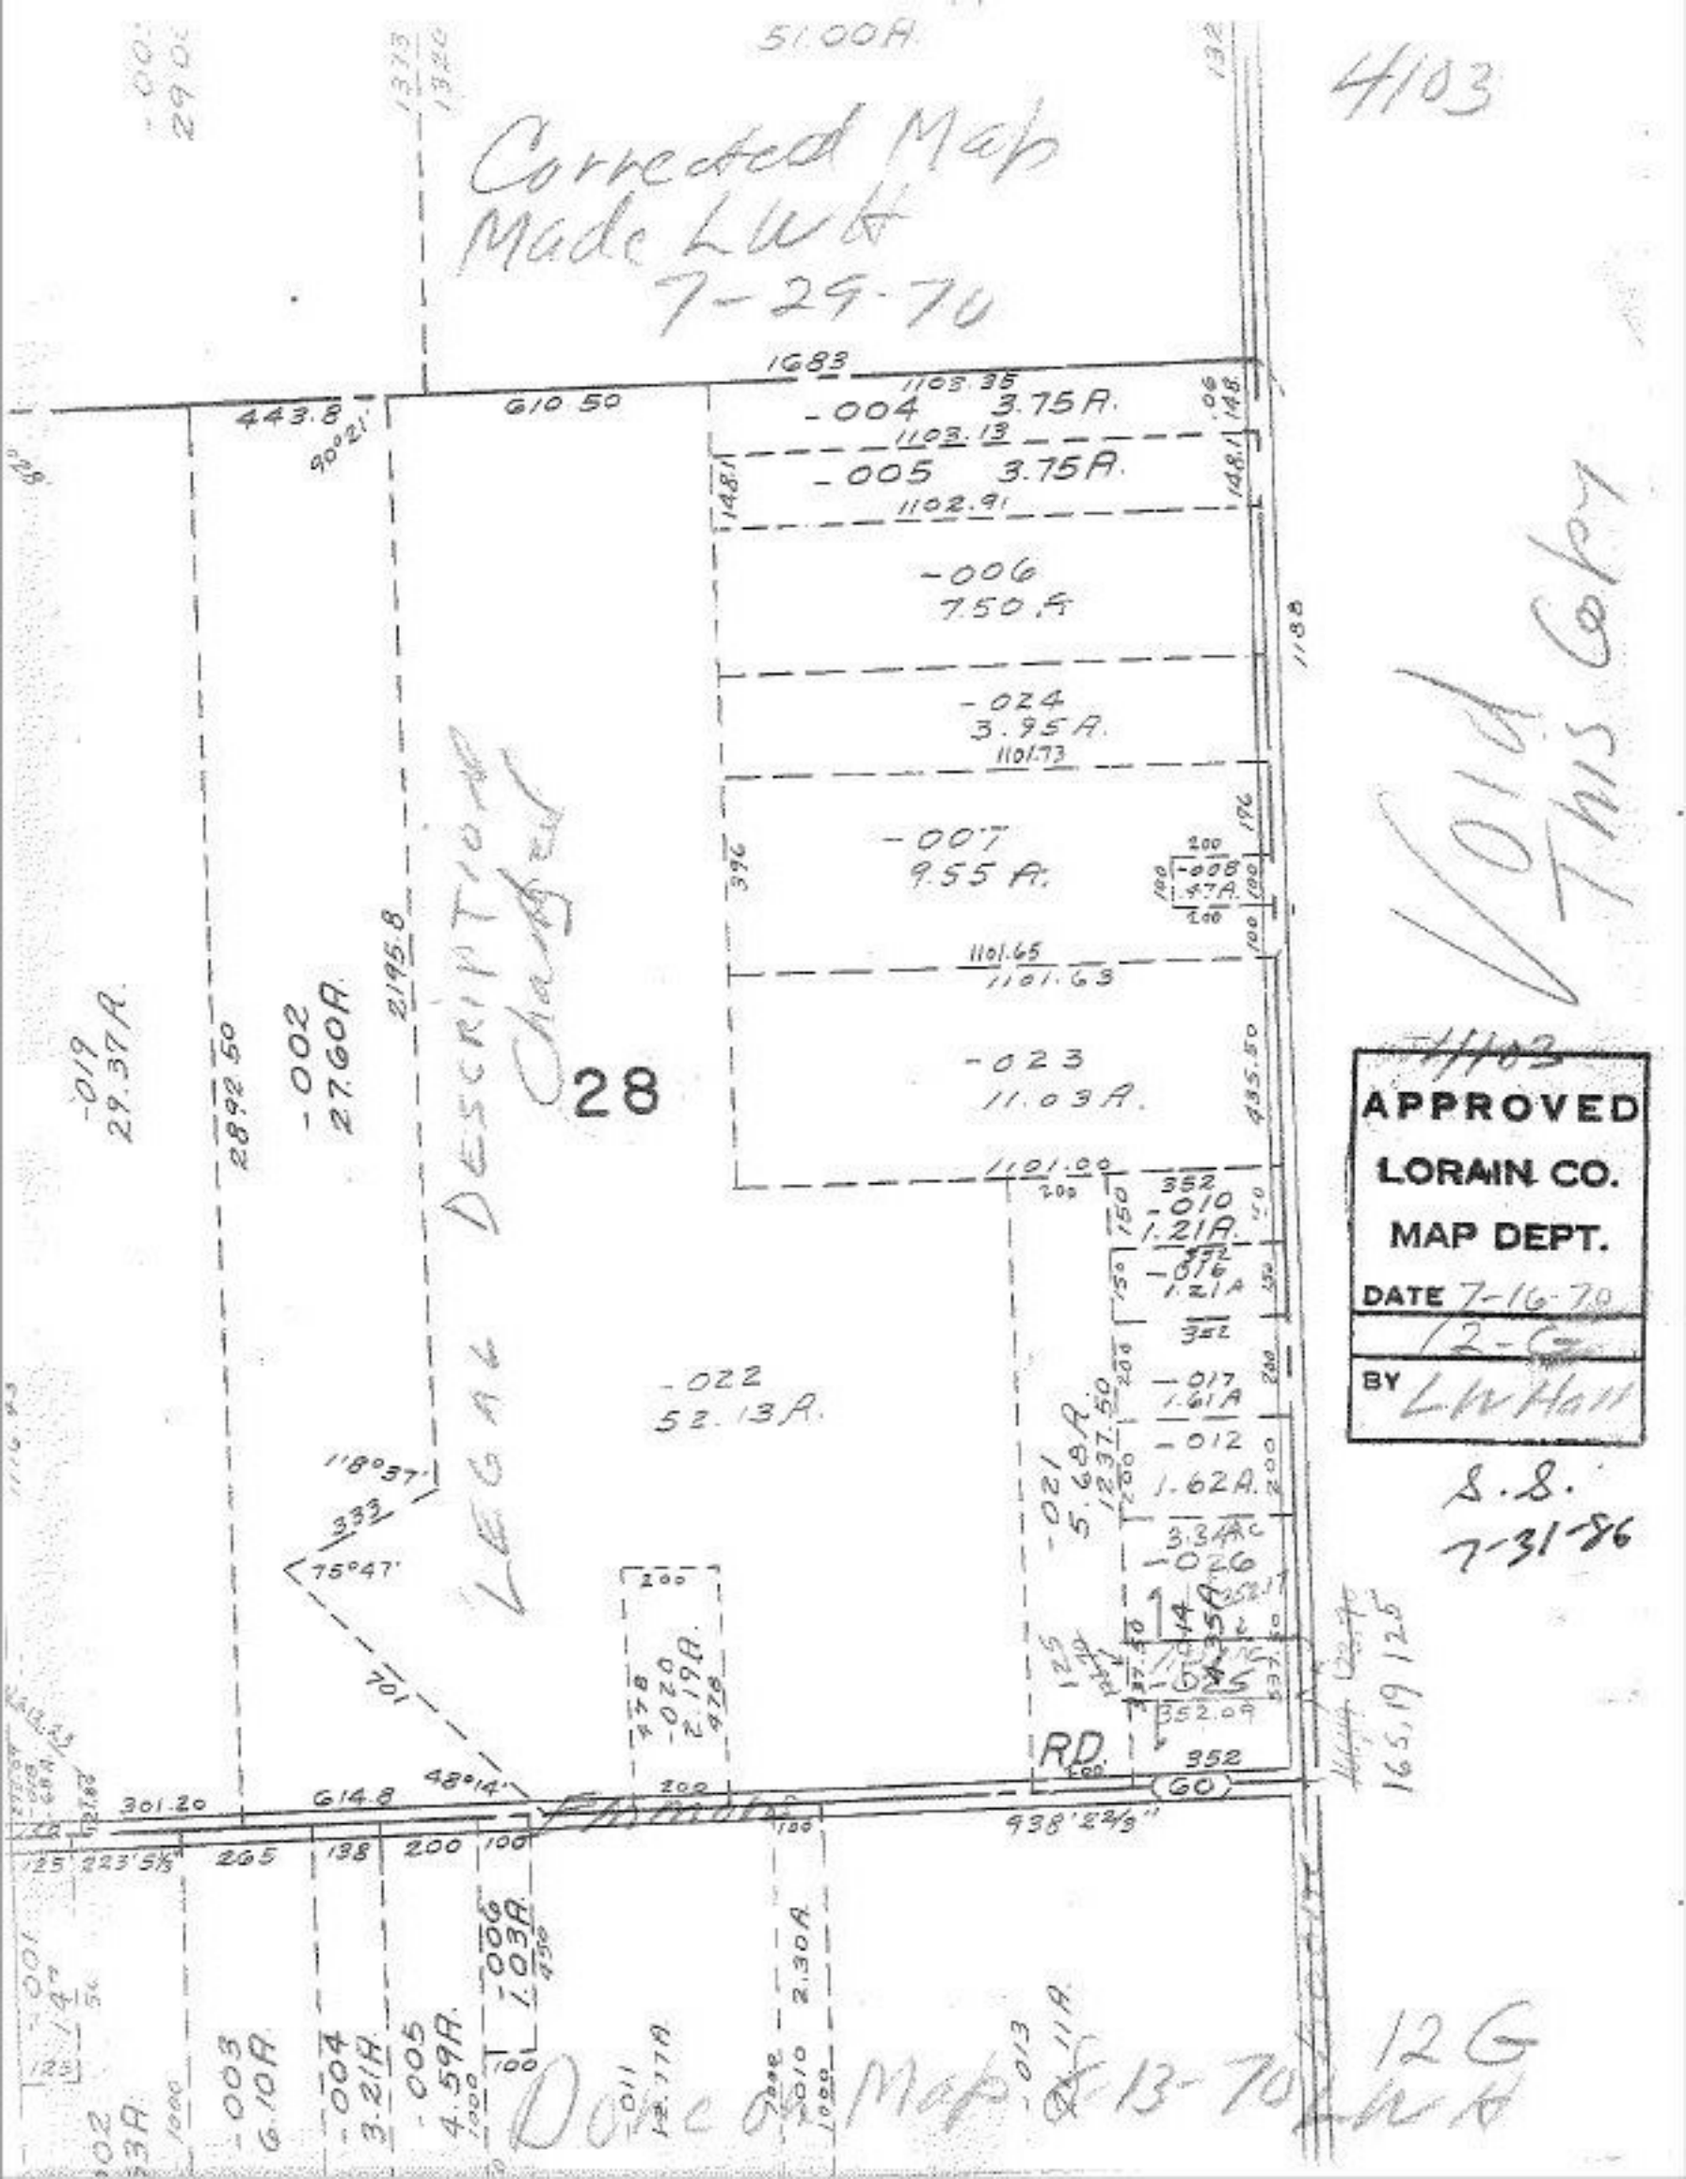
51.00A.
4103
Corrected Map
Made L.W.H.
7-29-70
1683
1105.35
-004 3.75A.
1103.13
-005 3.75A.
1102.91
-006
7.50A.
-024
3.95A.
1101.73
-007
9.55A.
-008
1.47A.
1101.65
1101.63
-023
11.03A.
1101.00
-010
1.21A.
-016
1.21A.
-017
1.61A.
-012
1.62A.
-026
3.35A.
-025
352.09
352
-021
5.68A.
1237.50
-022
52.13A.
28
-019
29.37A.
-002
27.60A.
2195.8
2892.50
443.8
610.50
90°21'
1188
435.50
396
148.1
148.1
118°37'
333
75°47'
101'
48°14'
614.8
301.20
938'22½"
RD.
60
-020
2.19A.
478
428
200
100
-003
6.10A.
-004
3.21A.
-005
4.59A.
-006
1.03A.
-011
12.17A.
-013
2.30A.
Void This Cert
APPROVED
LORAIN CO.
MAP DEPT.
DATE 7-16-70
BY L.W.Hall
4103
S.S.
7-31-86
Corrected Map Made 7-13-70 L.W.H.
12G