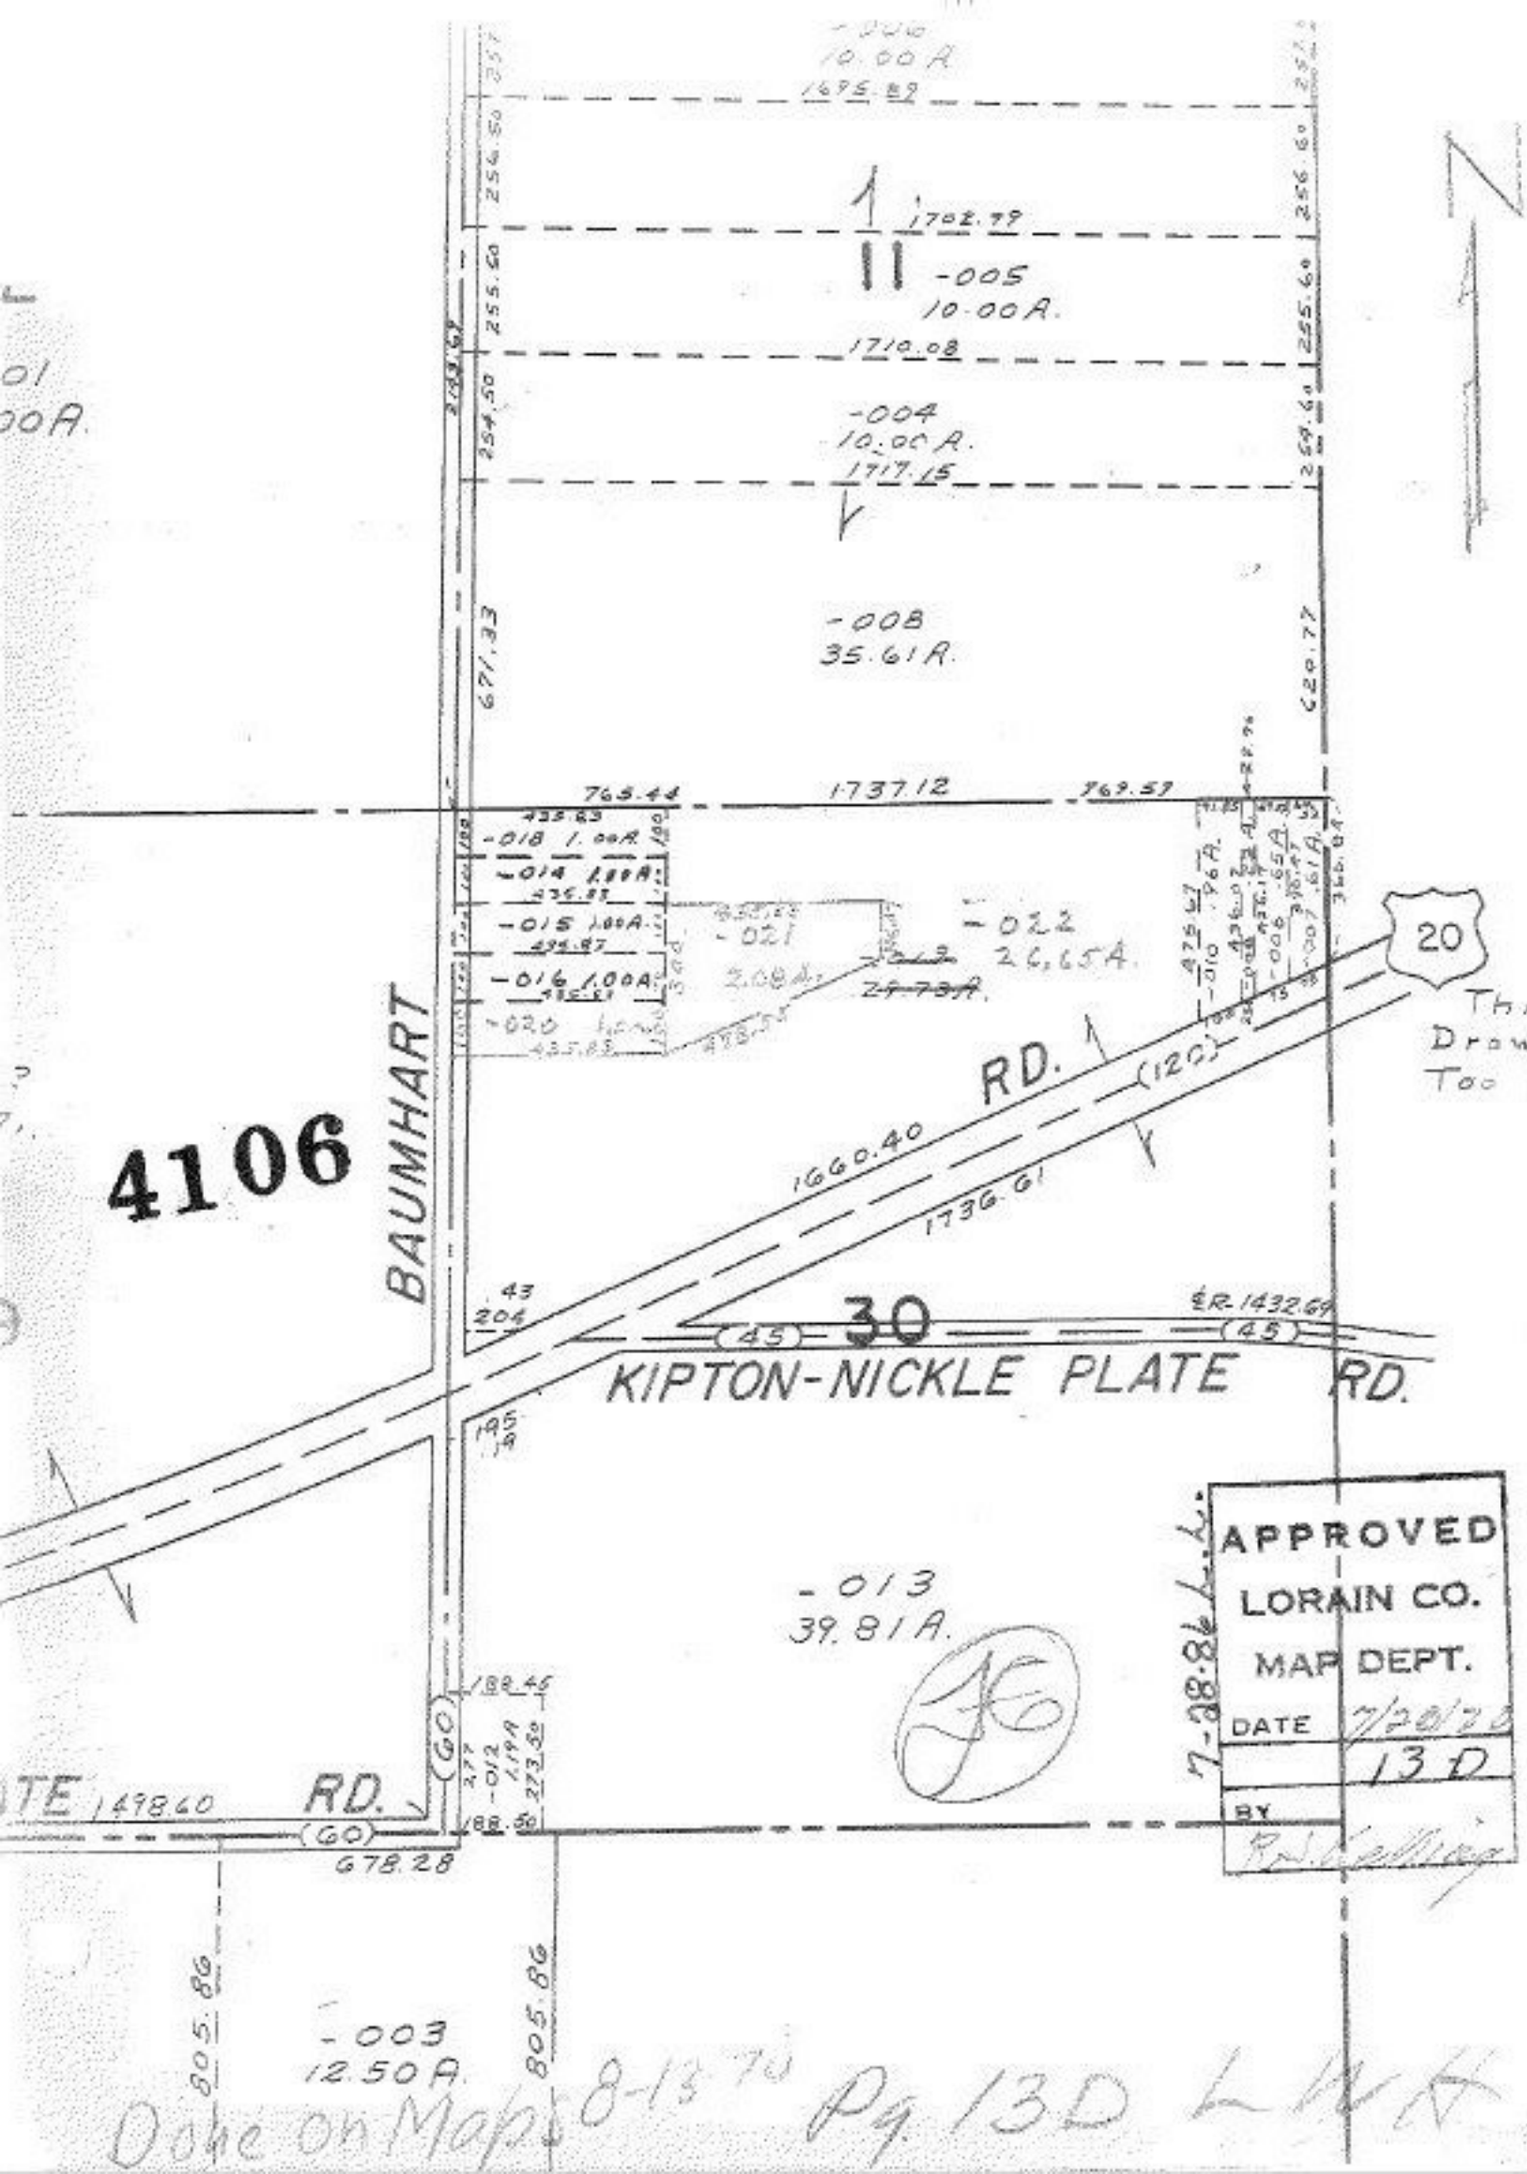

10.00 A
1695.89
1702.79
-005
10.00 A.
1710.08
-004
10.00 A.
1717.15
-008
35.61 A.
671.33
620.77
765.44
1737.12
769.57
-018 1.00A
-014 1.00A
-015 1.00A
-016 1.00A
-020
-021
2.08A
-022
26.65A
20
This Hi
Drawn A
Too Far
4106
BAUMHART
RD.
(120)
1660.40
1736.61
30
(45)
KIPTON-NICKLE PLATE RD.
-013
39.81 A.
APPROVED
LORAIN CO.
MAP DEPT.
DATE 7/20/70
13 D
BY
7-28-86 L.L.
RD.
(60)
678.28
805.86
-003
12.50 A.
Done on Maps 8-13-70 Pg 13D LWH