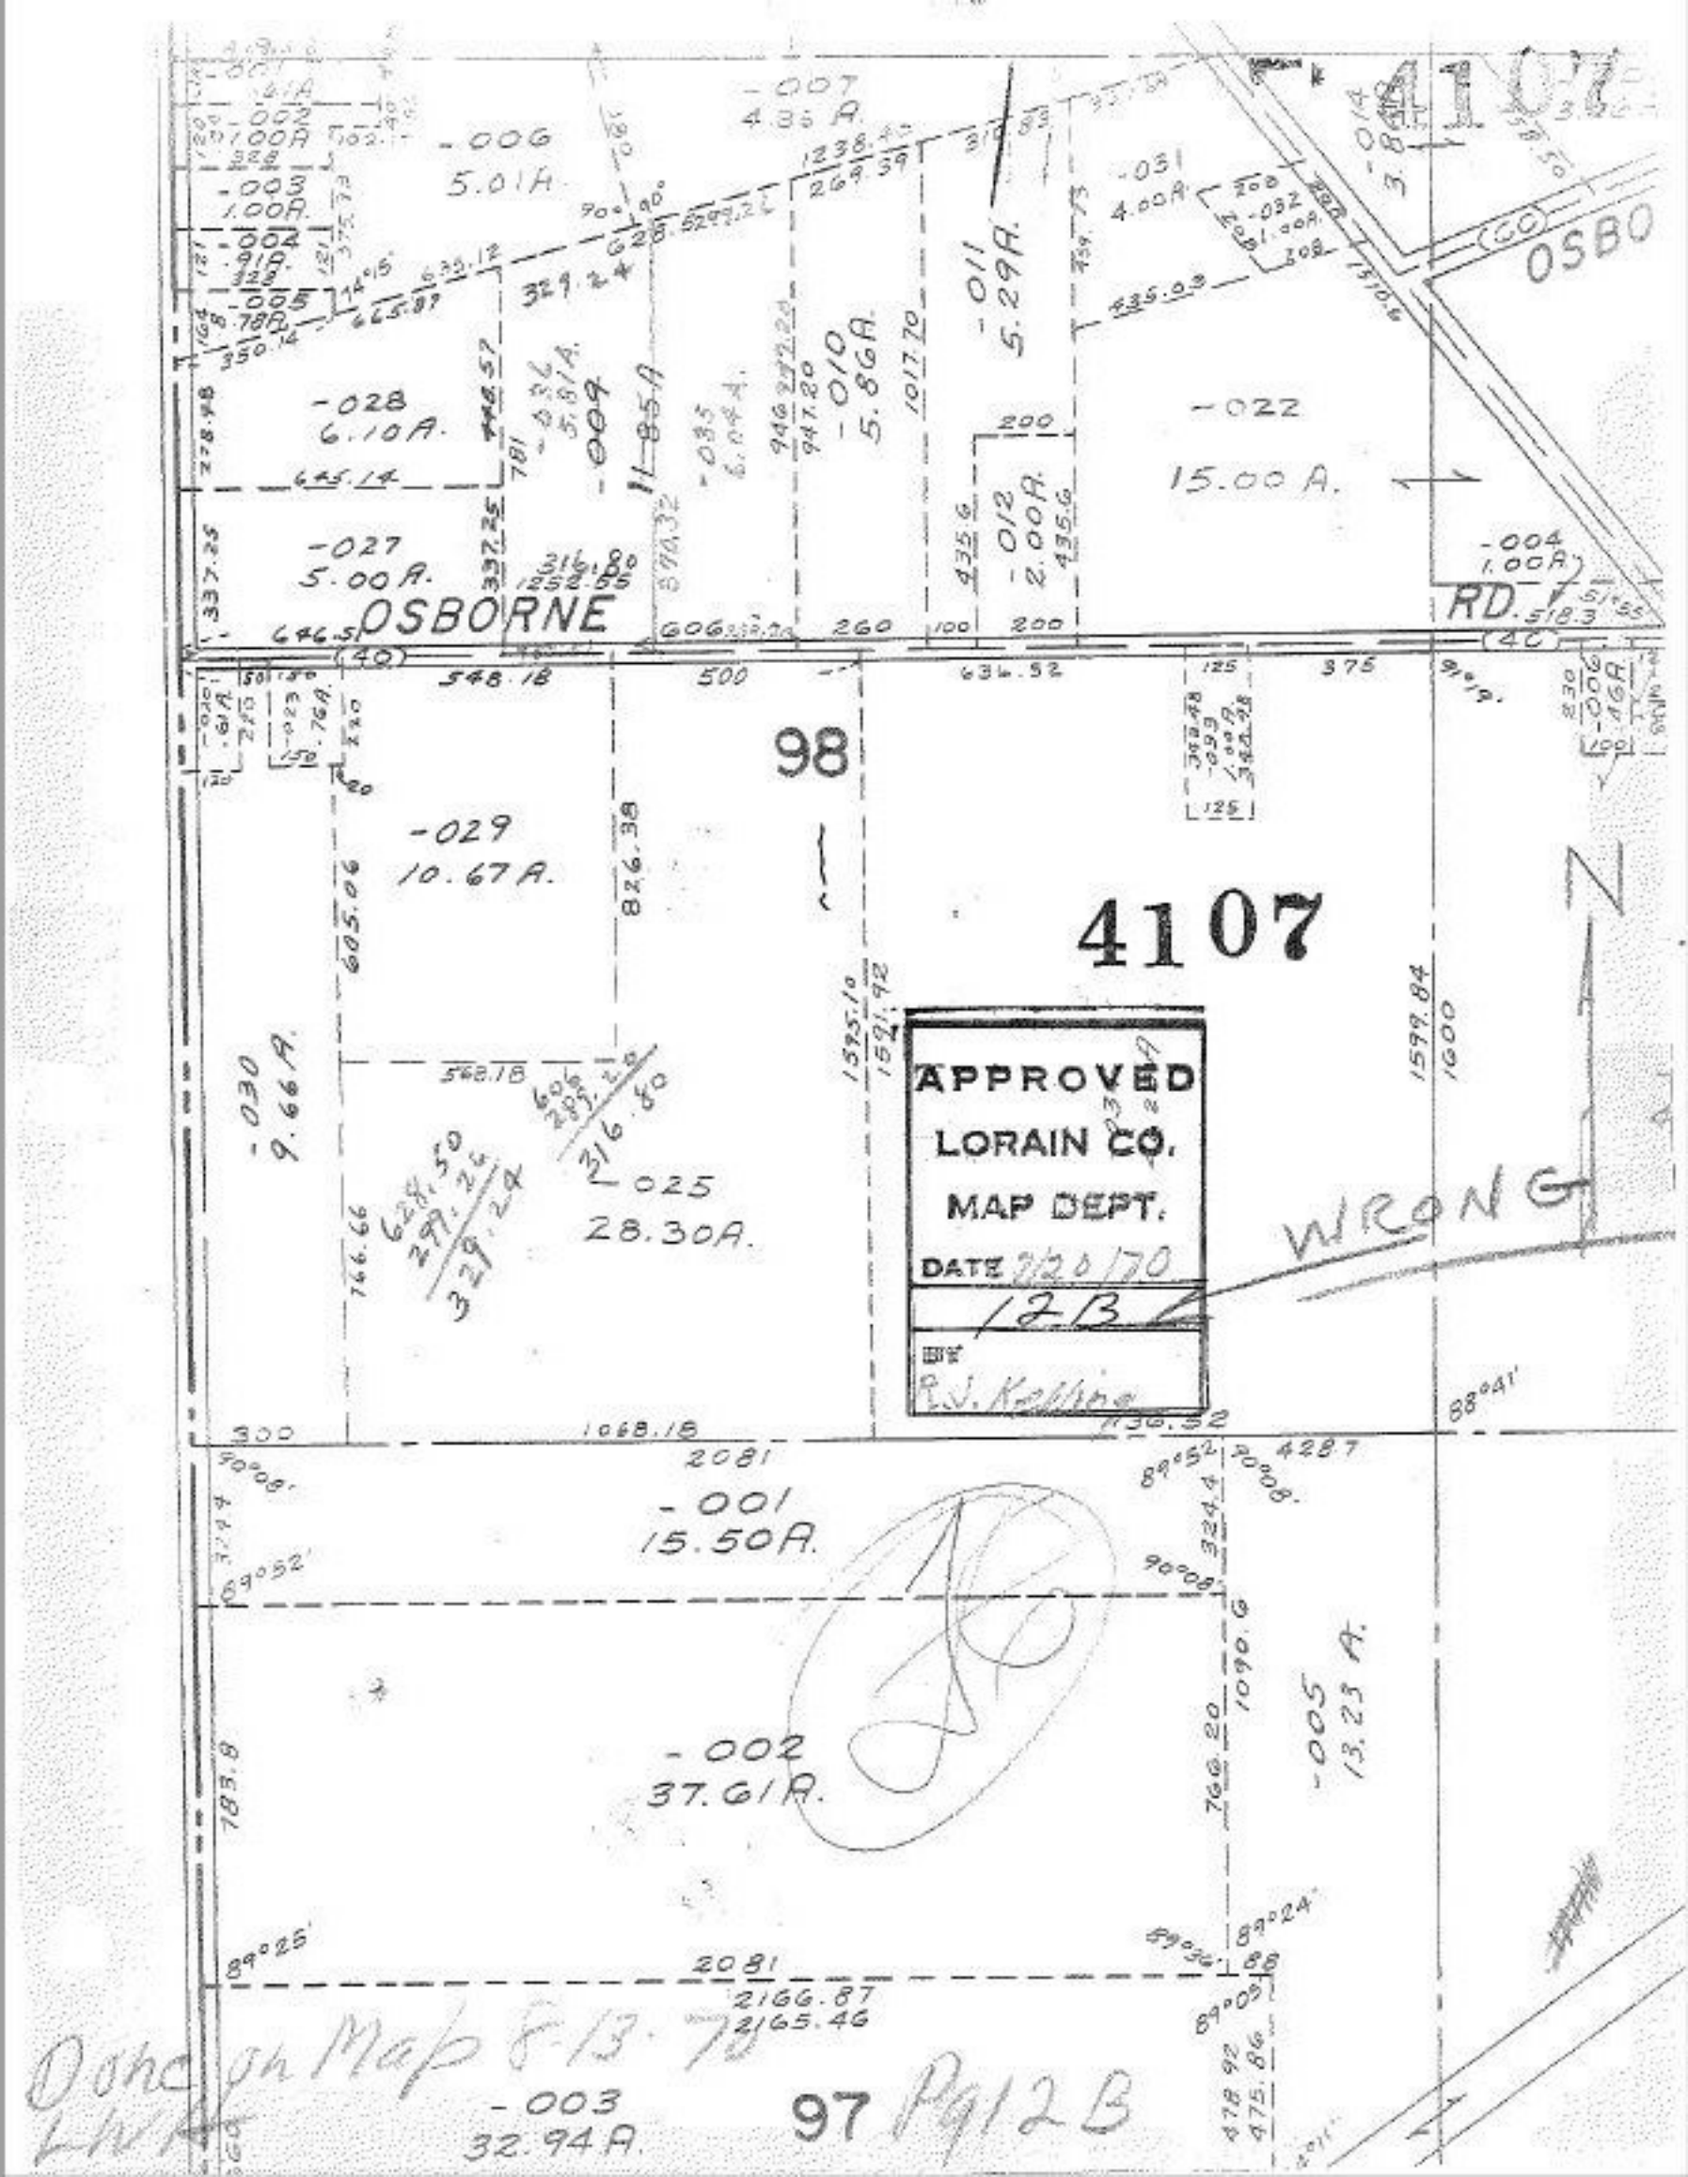
4107
OSBORNE
RD.
OSBO
98
97
-001
15.50A.
-002
37.61A.
-003
32.94A.
-004
1.00A.
-005
13.23 A.
-006
5.01A.
-007
4.35 A.
-009
5.81A.
-010
5.86A.
-011
5.29A.
-012
2.00A.
-022
15.00 A.
-027
5.00 A.
-028
6.10A.
-029
10.67 A.
-030
9.66A.
-031
4.00A.
-032
1.00A.
-033
6.04A.
-035
6.04A.
APPROVED
LORAIN CO.
MAP DEPT.
DATE 2/20/70
12B
BY R.J. Kelling
WRONG
Pg 12B