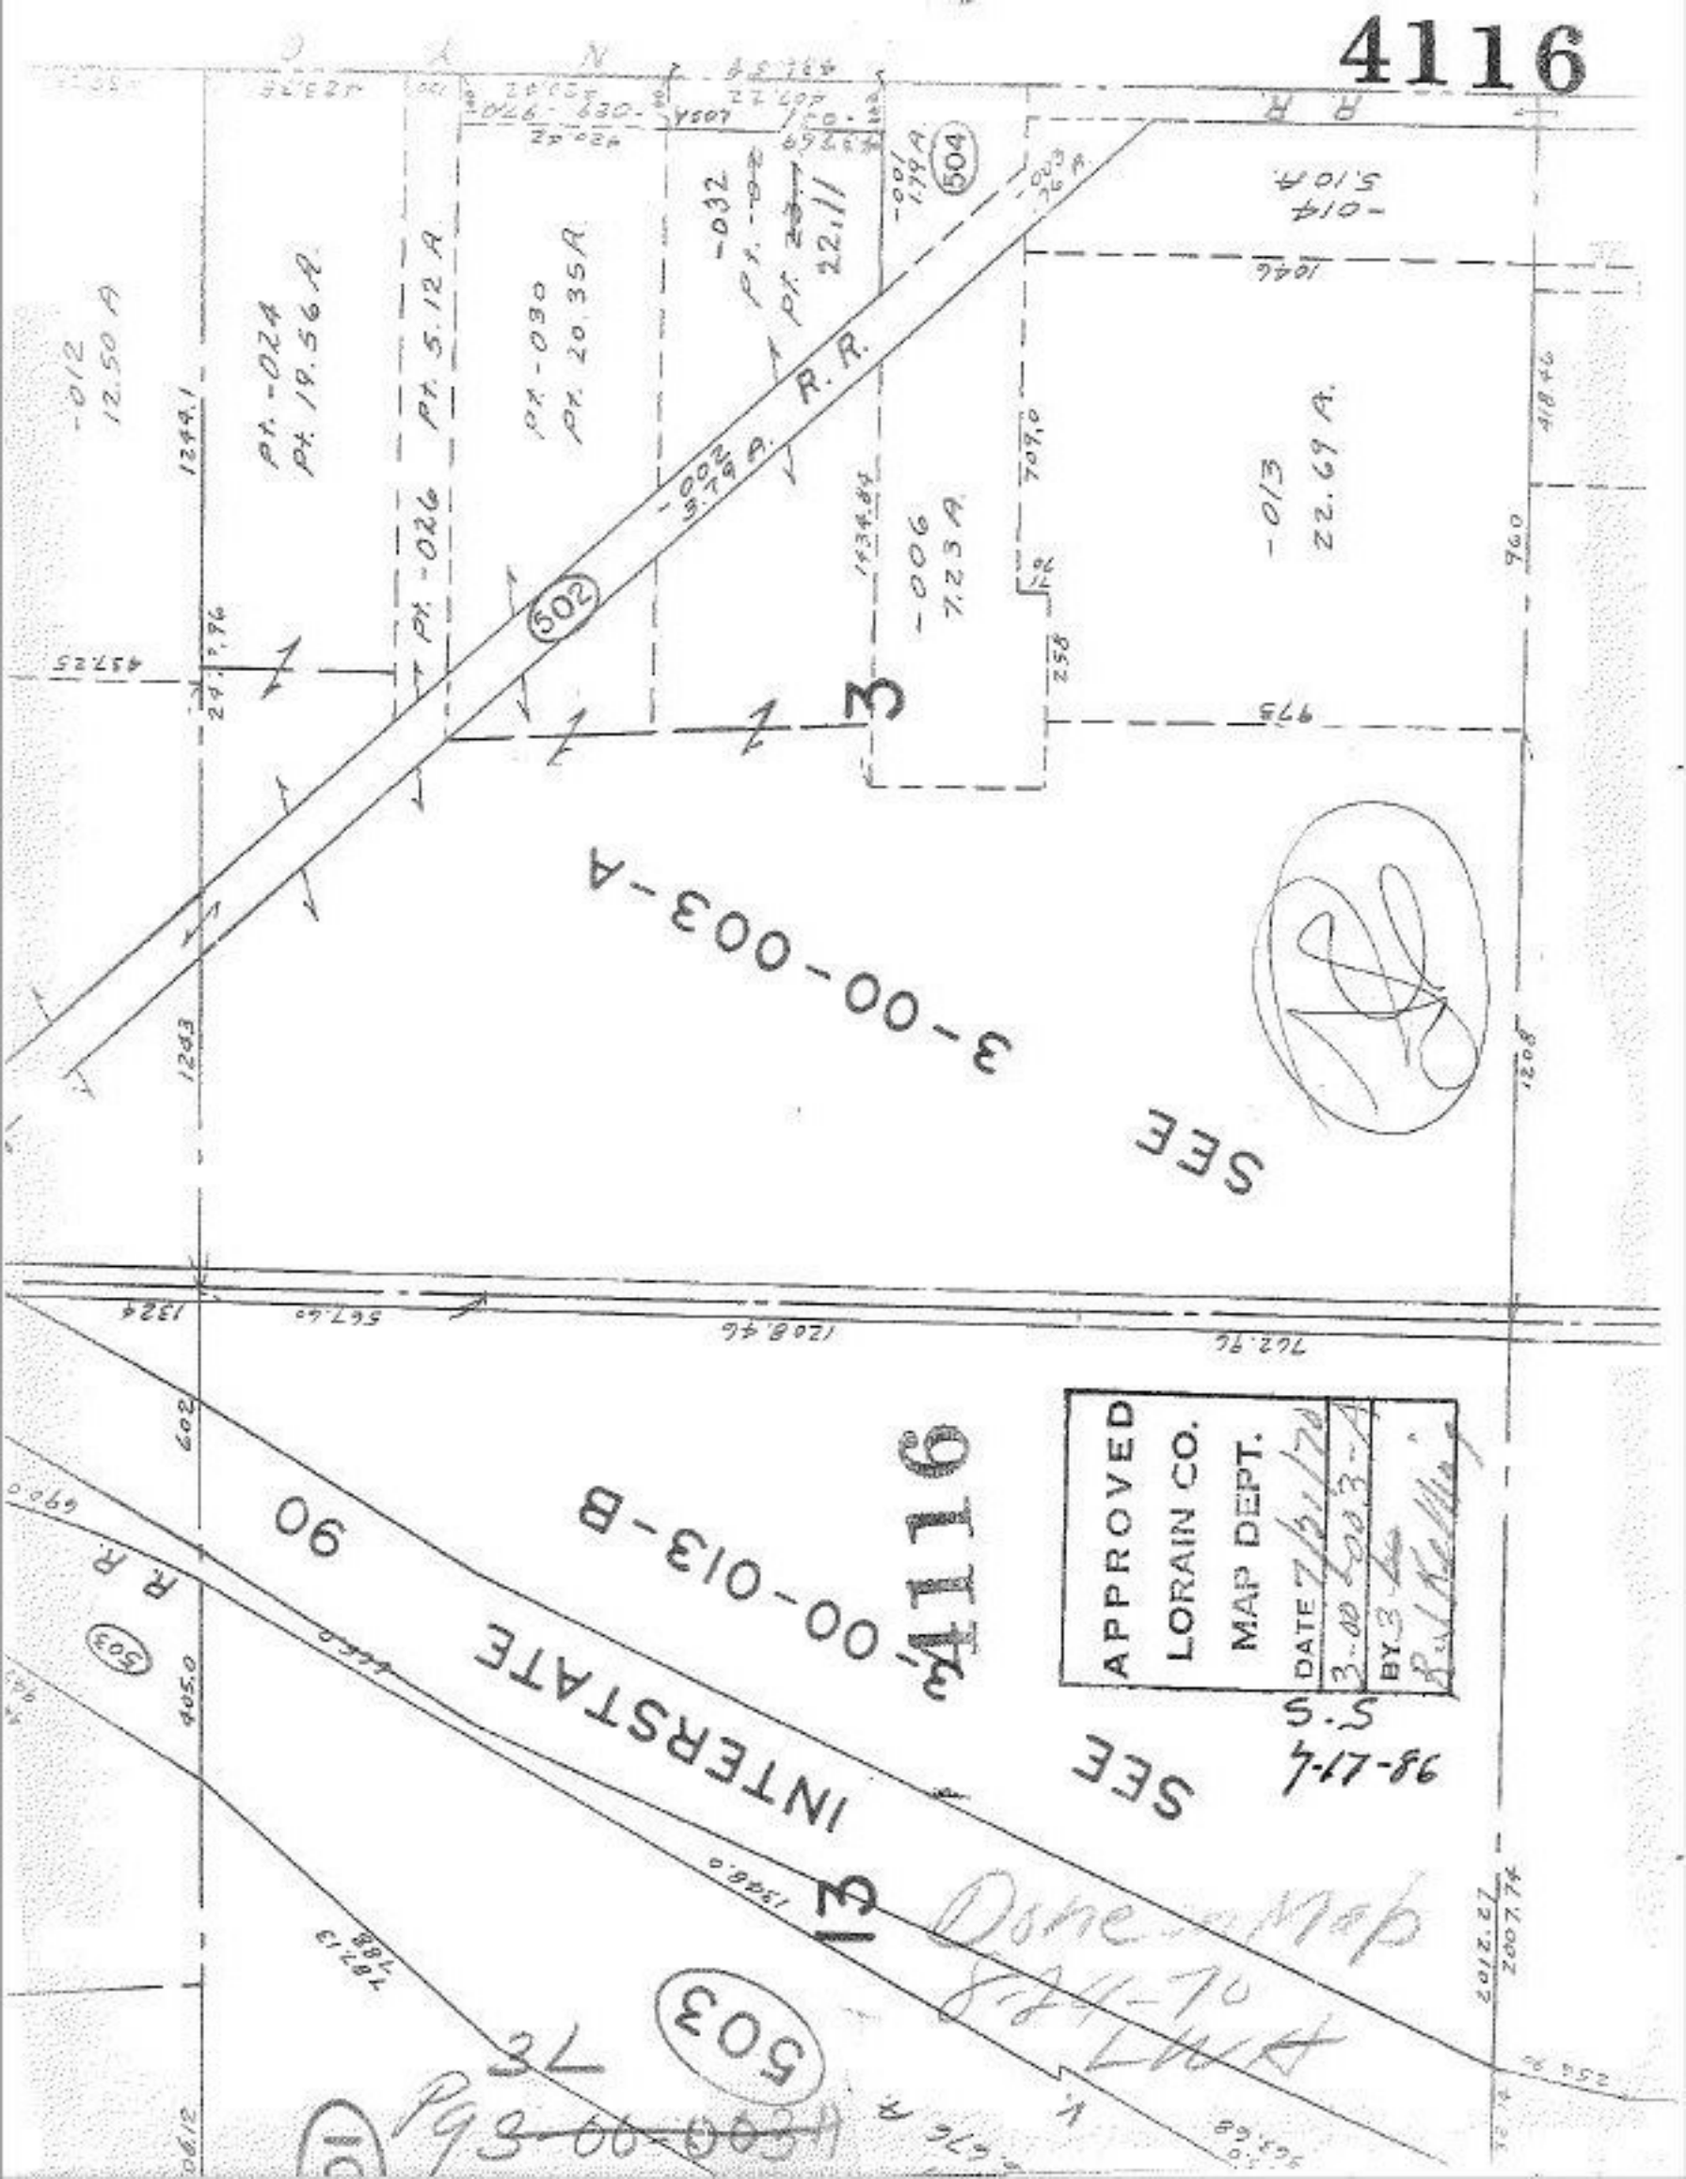
4116
SEE 3-00-003-A
SEE 3-00-013-B
INTERSTATE 90
R.R.
502
503
504
3
13
-012 12.50 A
Pt. -024 Pt. 19.56 A.
Pt. -026 Pt. 5.12 A
Pt. -030 Pt. 20.35 A
-032 Pt. 22.11
-002 3.79 A.
-006 7.23 A.
-013 22.69 A.
-014 5.10 A.
APPROVED
LORAIN CO.
MAP DEPT.
DATE 7/31/70
3-00-003-A
BY 3
S.S
7-17-86
Done on Map
8-24-70
LWH
3L
Pg 3-00-003A