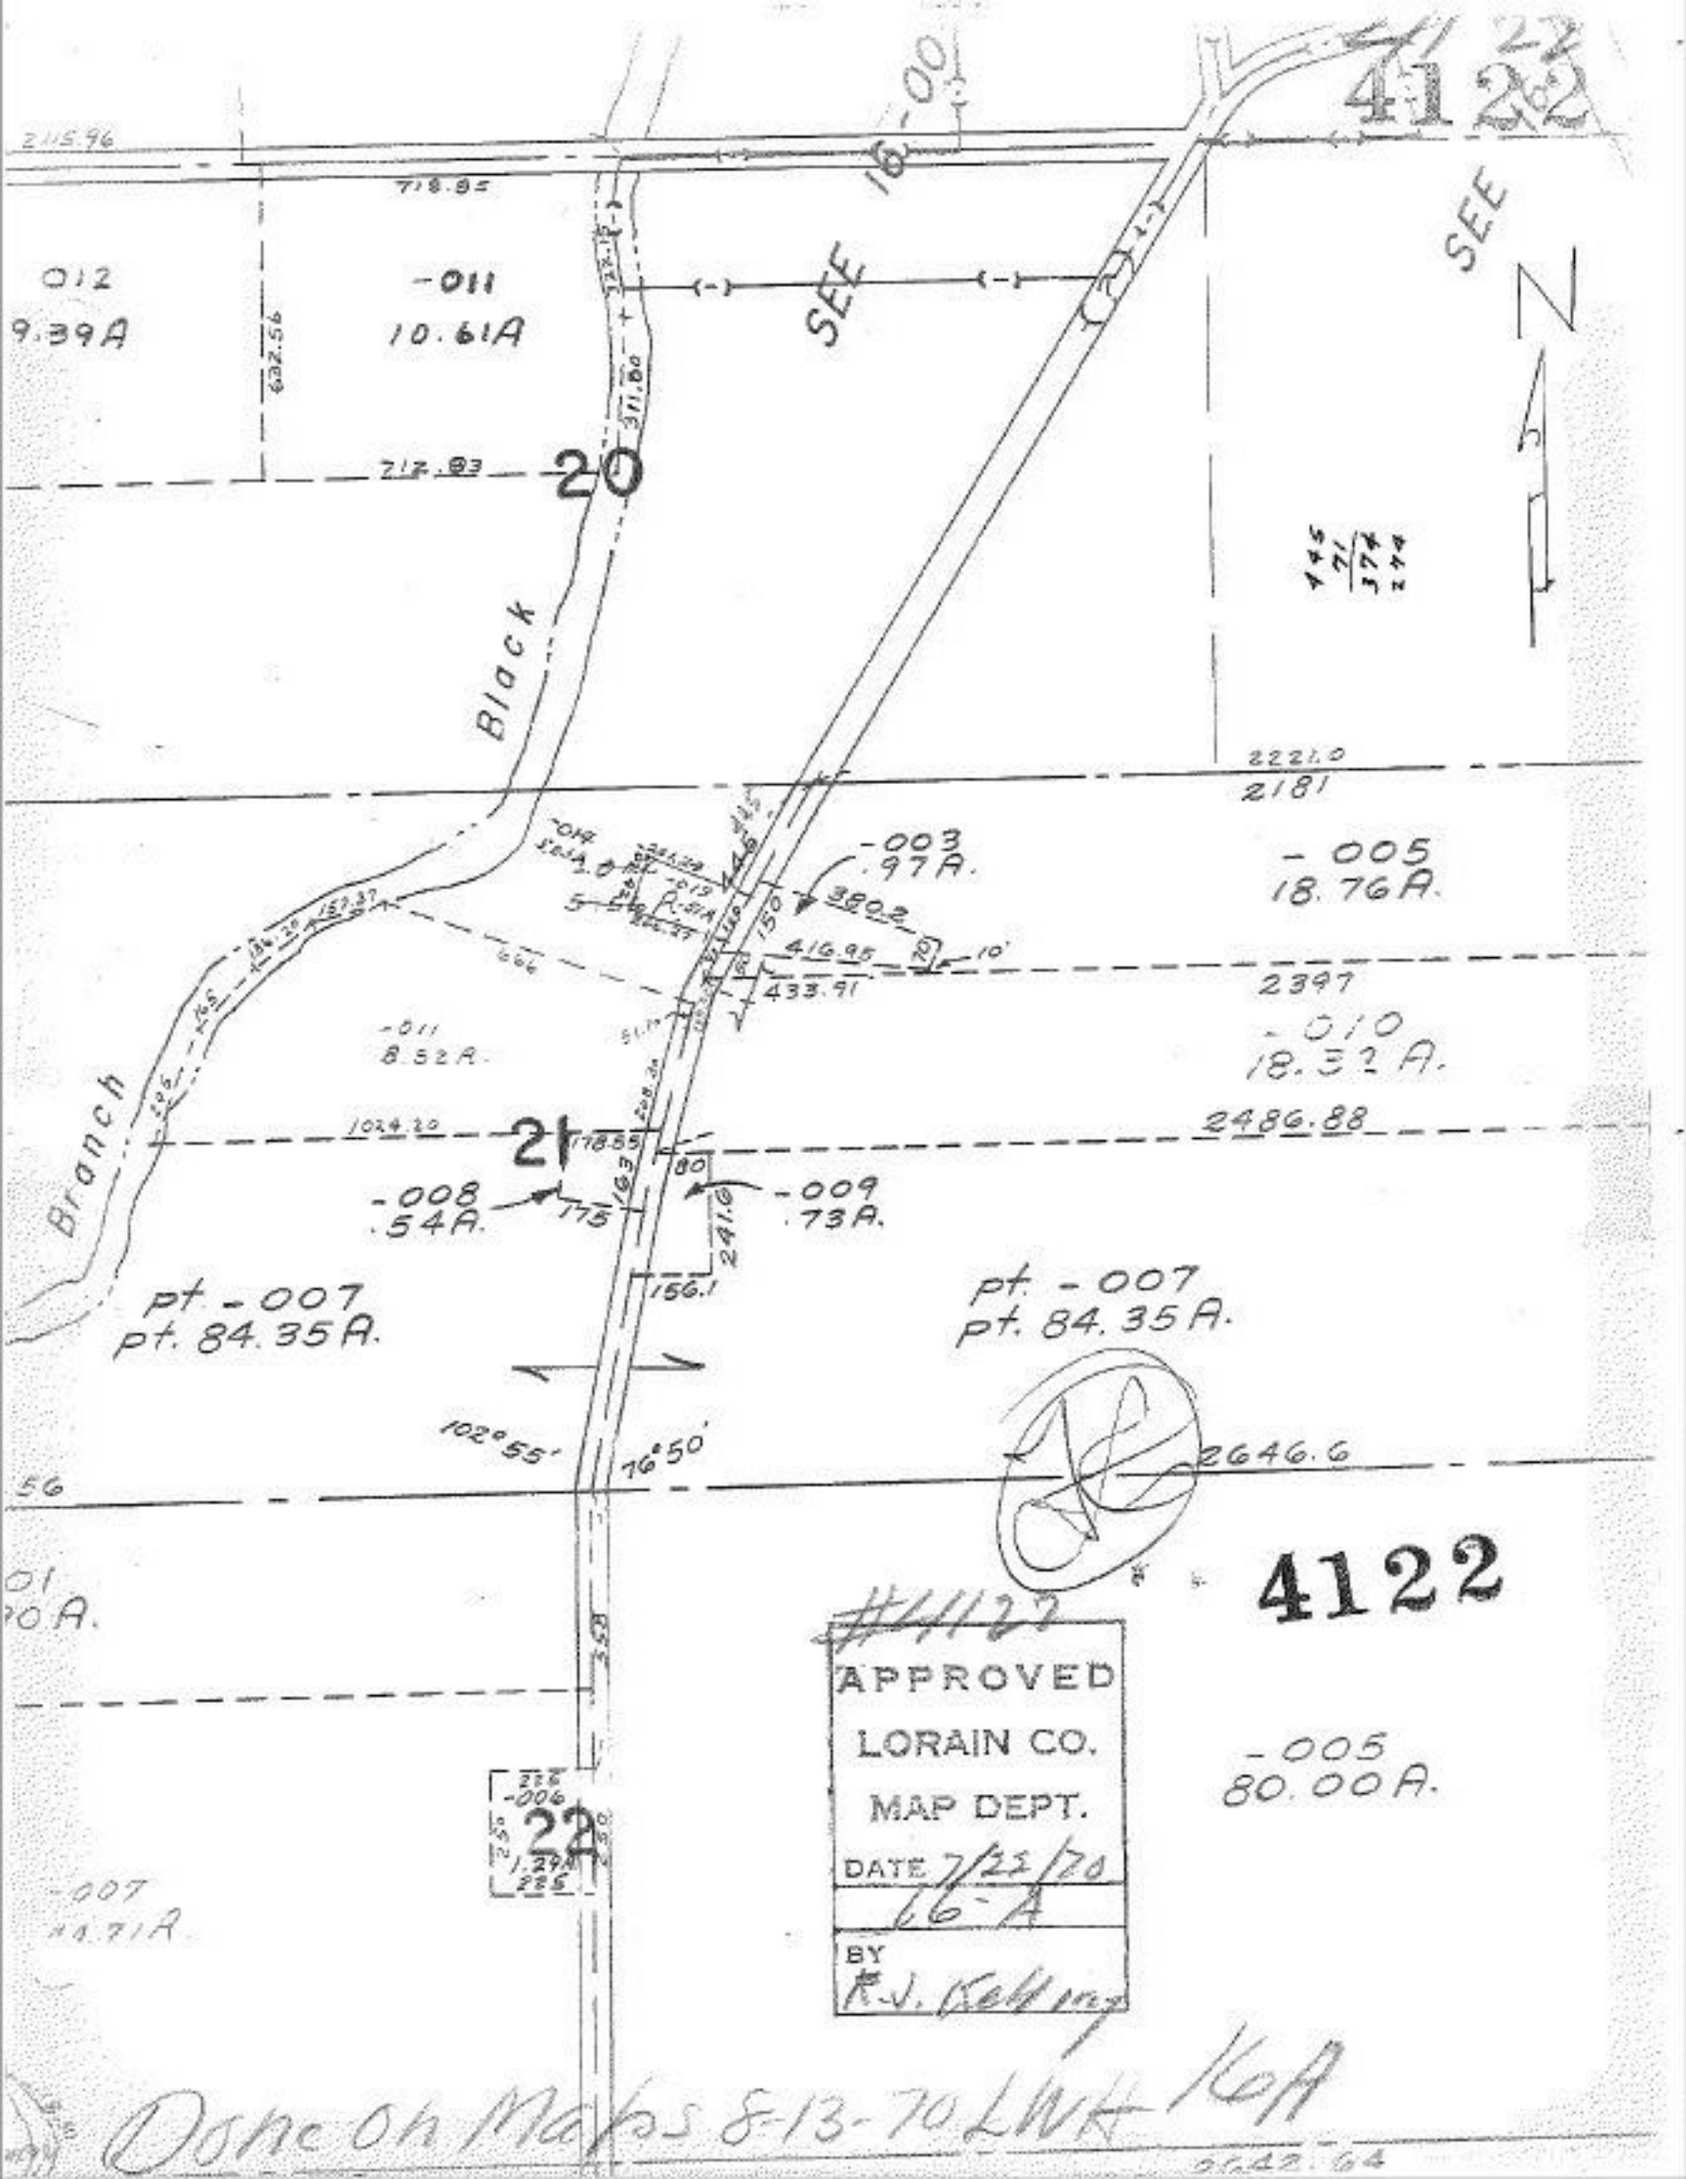
4122
SEE 16-00
SEE
N
2115.96
718.85
012
9.39A
-011
10.61A
632.56
311.80
712.83
20
Black
Branch
2221.0
2181
-003
.97A.
380.2
416.95
433.91
-005
18.76A.
2397
-010
18.32A.
-011
8.52A.
1024.20
21
2486.88
-008
.54A.
-009
.73A.
156.1
pt. -007
pt. 84.35A.
pt. -007
pt. 84.35A.
102°55'
76°50'
2646.6
4122
#4122
APPROVED
LORAIN CO.
MAP DEPT.
DATE 7/22/70
16-A
BY
R.J. Kelling
-005
80.00A.
22
-007
Done on Maps 8-13-70 LWH 16A