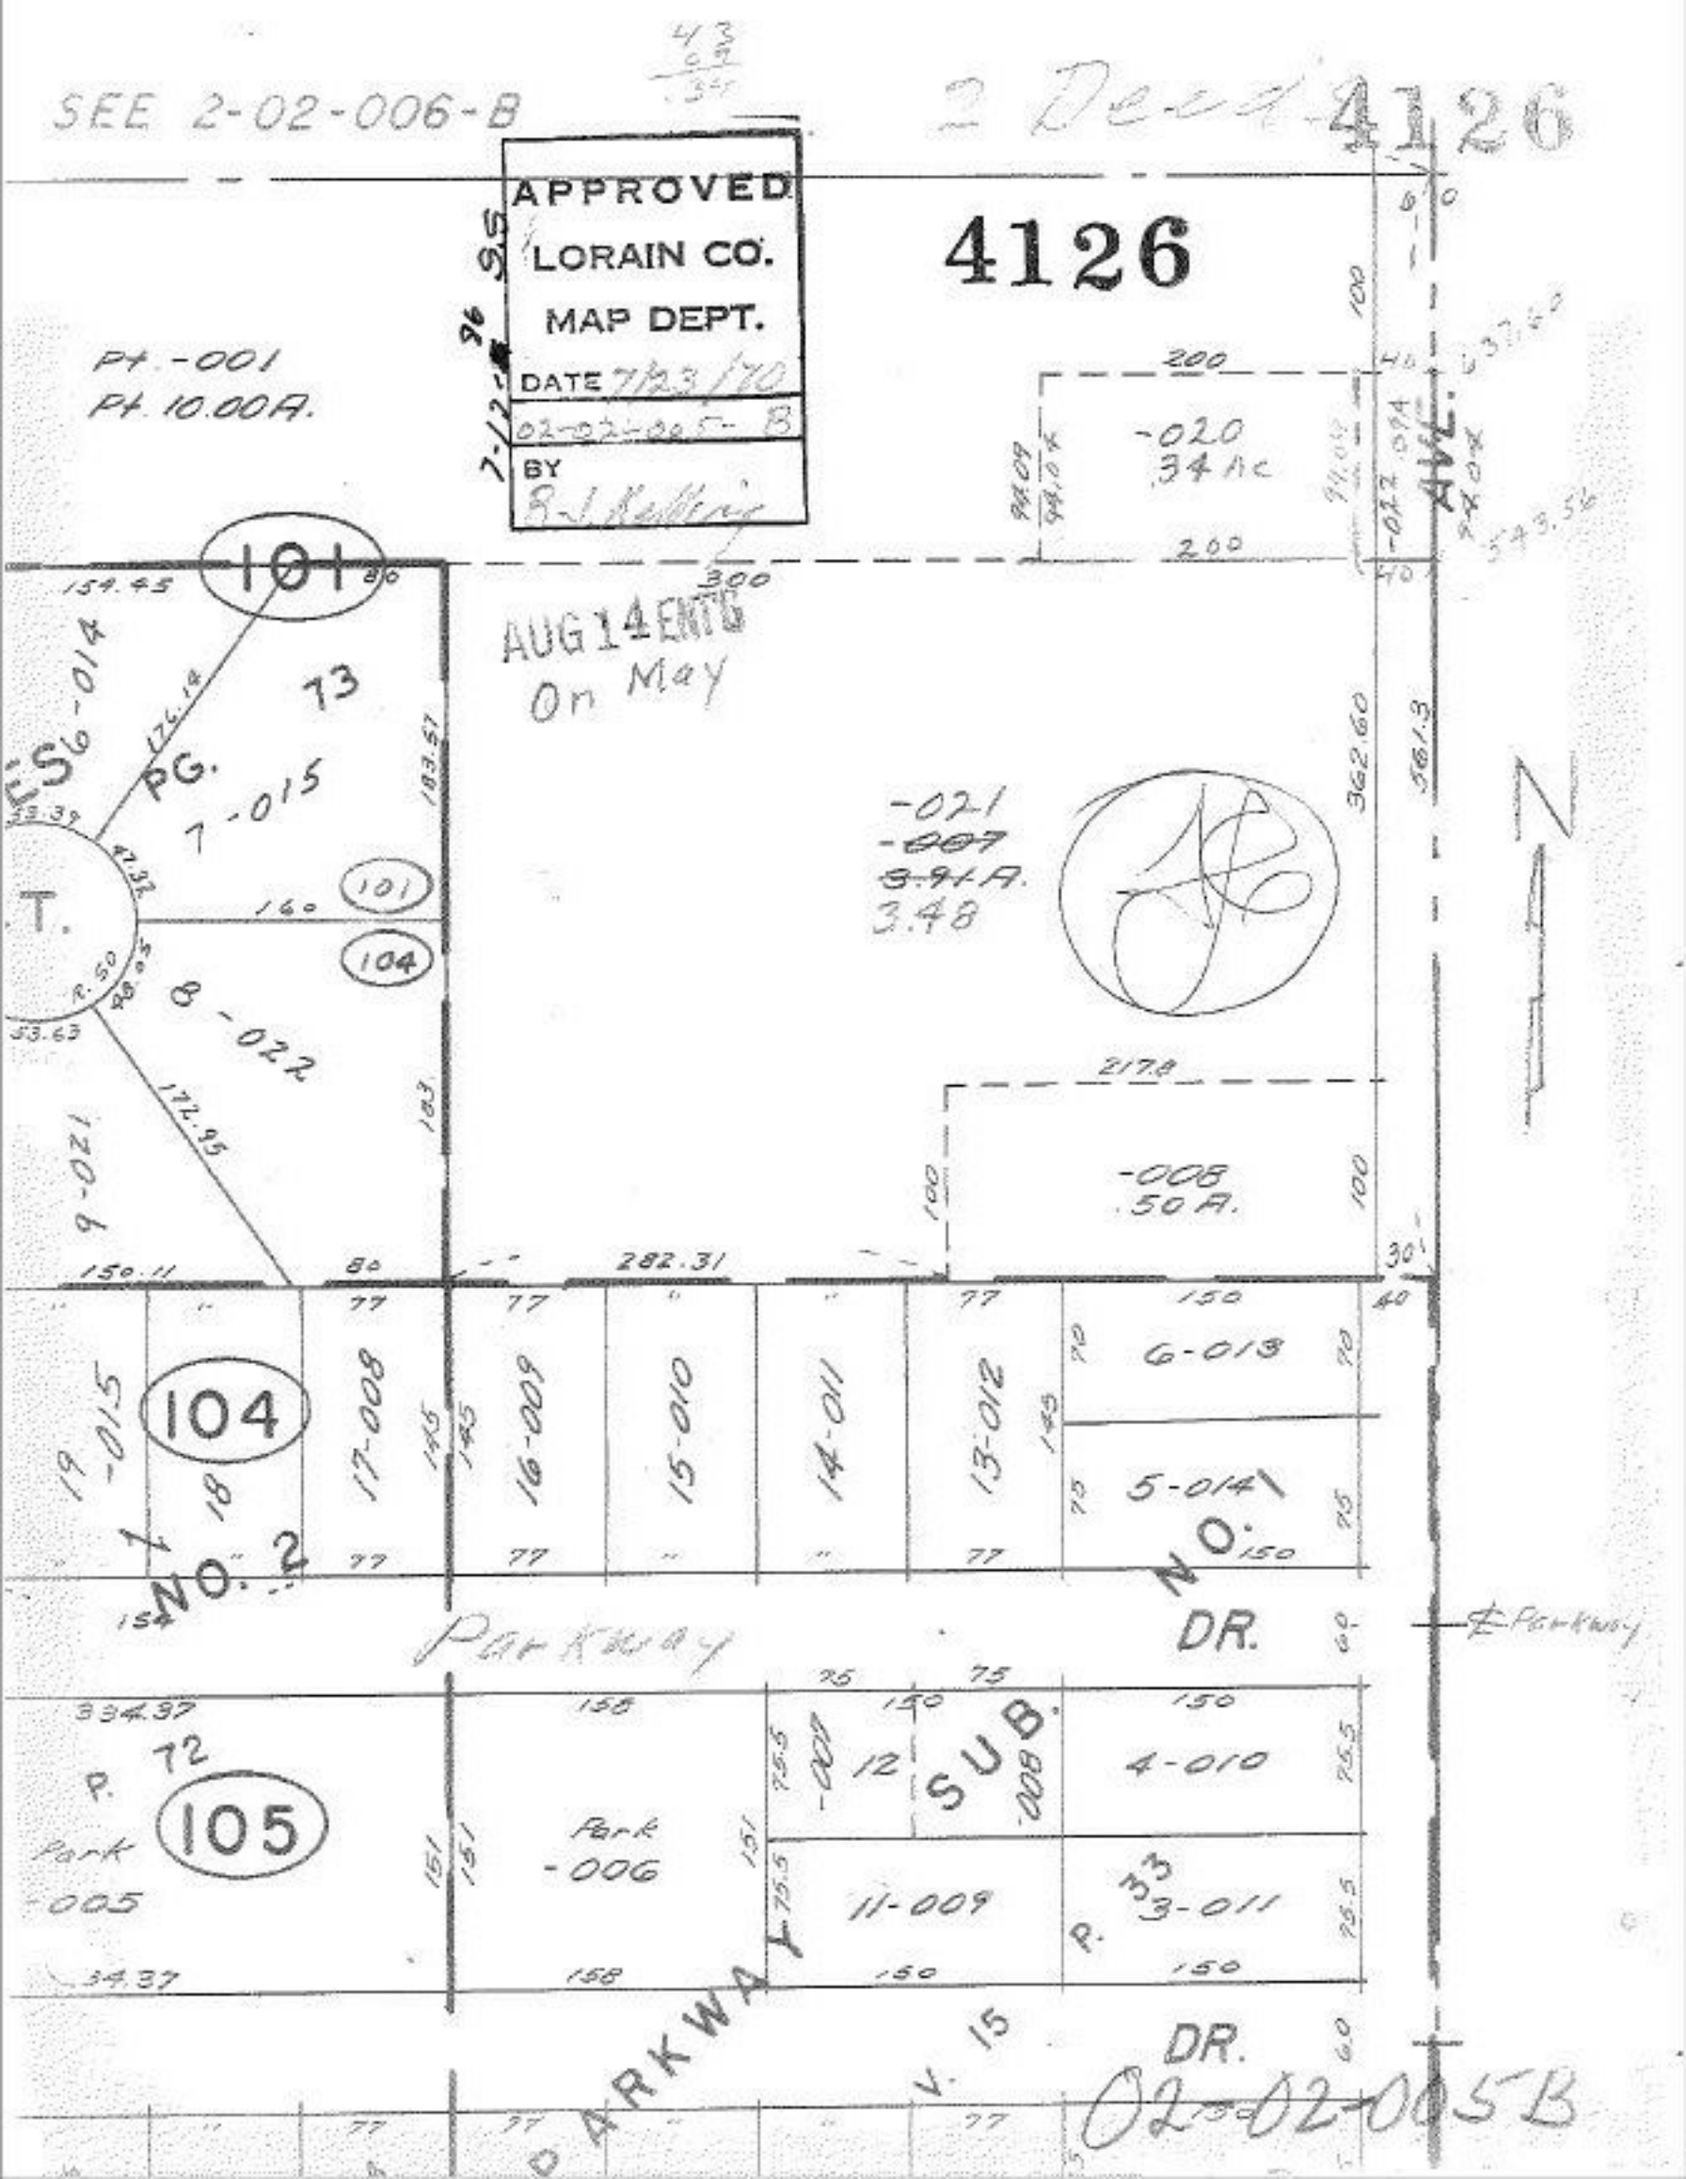
SEE 2-02-006-B
2 Deed
4126
APPROVED
LORAIN CO.
MAP DEPT.
DATE 7/23/70
02-02-005-B
BY
4126
Pt.-001
Pt. 10.00A.
-020
.34 Ac
AVE.
101
AUG 14 ENTG
On May
PG.
73
7-015
-021
3.48
101
104
8-022
-008
.50 A.
104
NO. 2
NO. 1
DR.
Parkway
105
Park
-005
Park
-006
SUB.
4-010
11-009
3-011
PARKWAY
DR.
02-02-005B