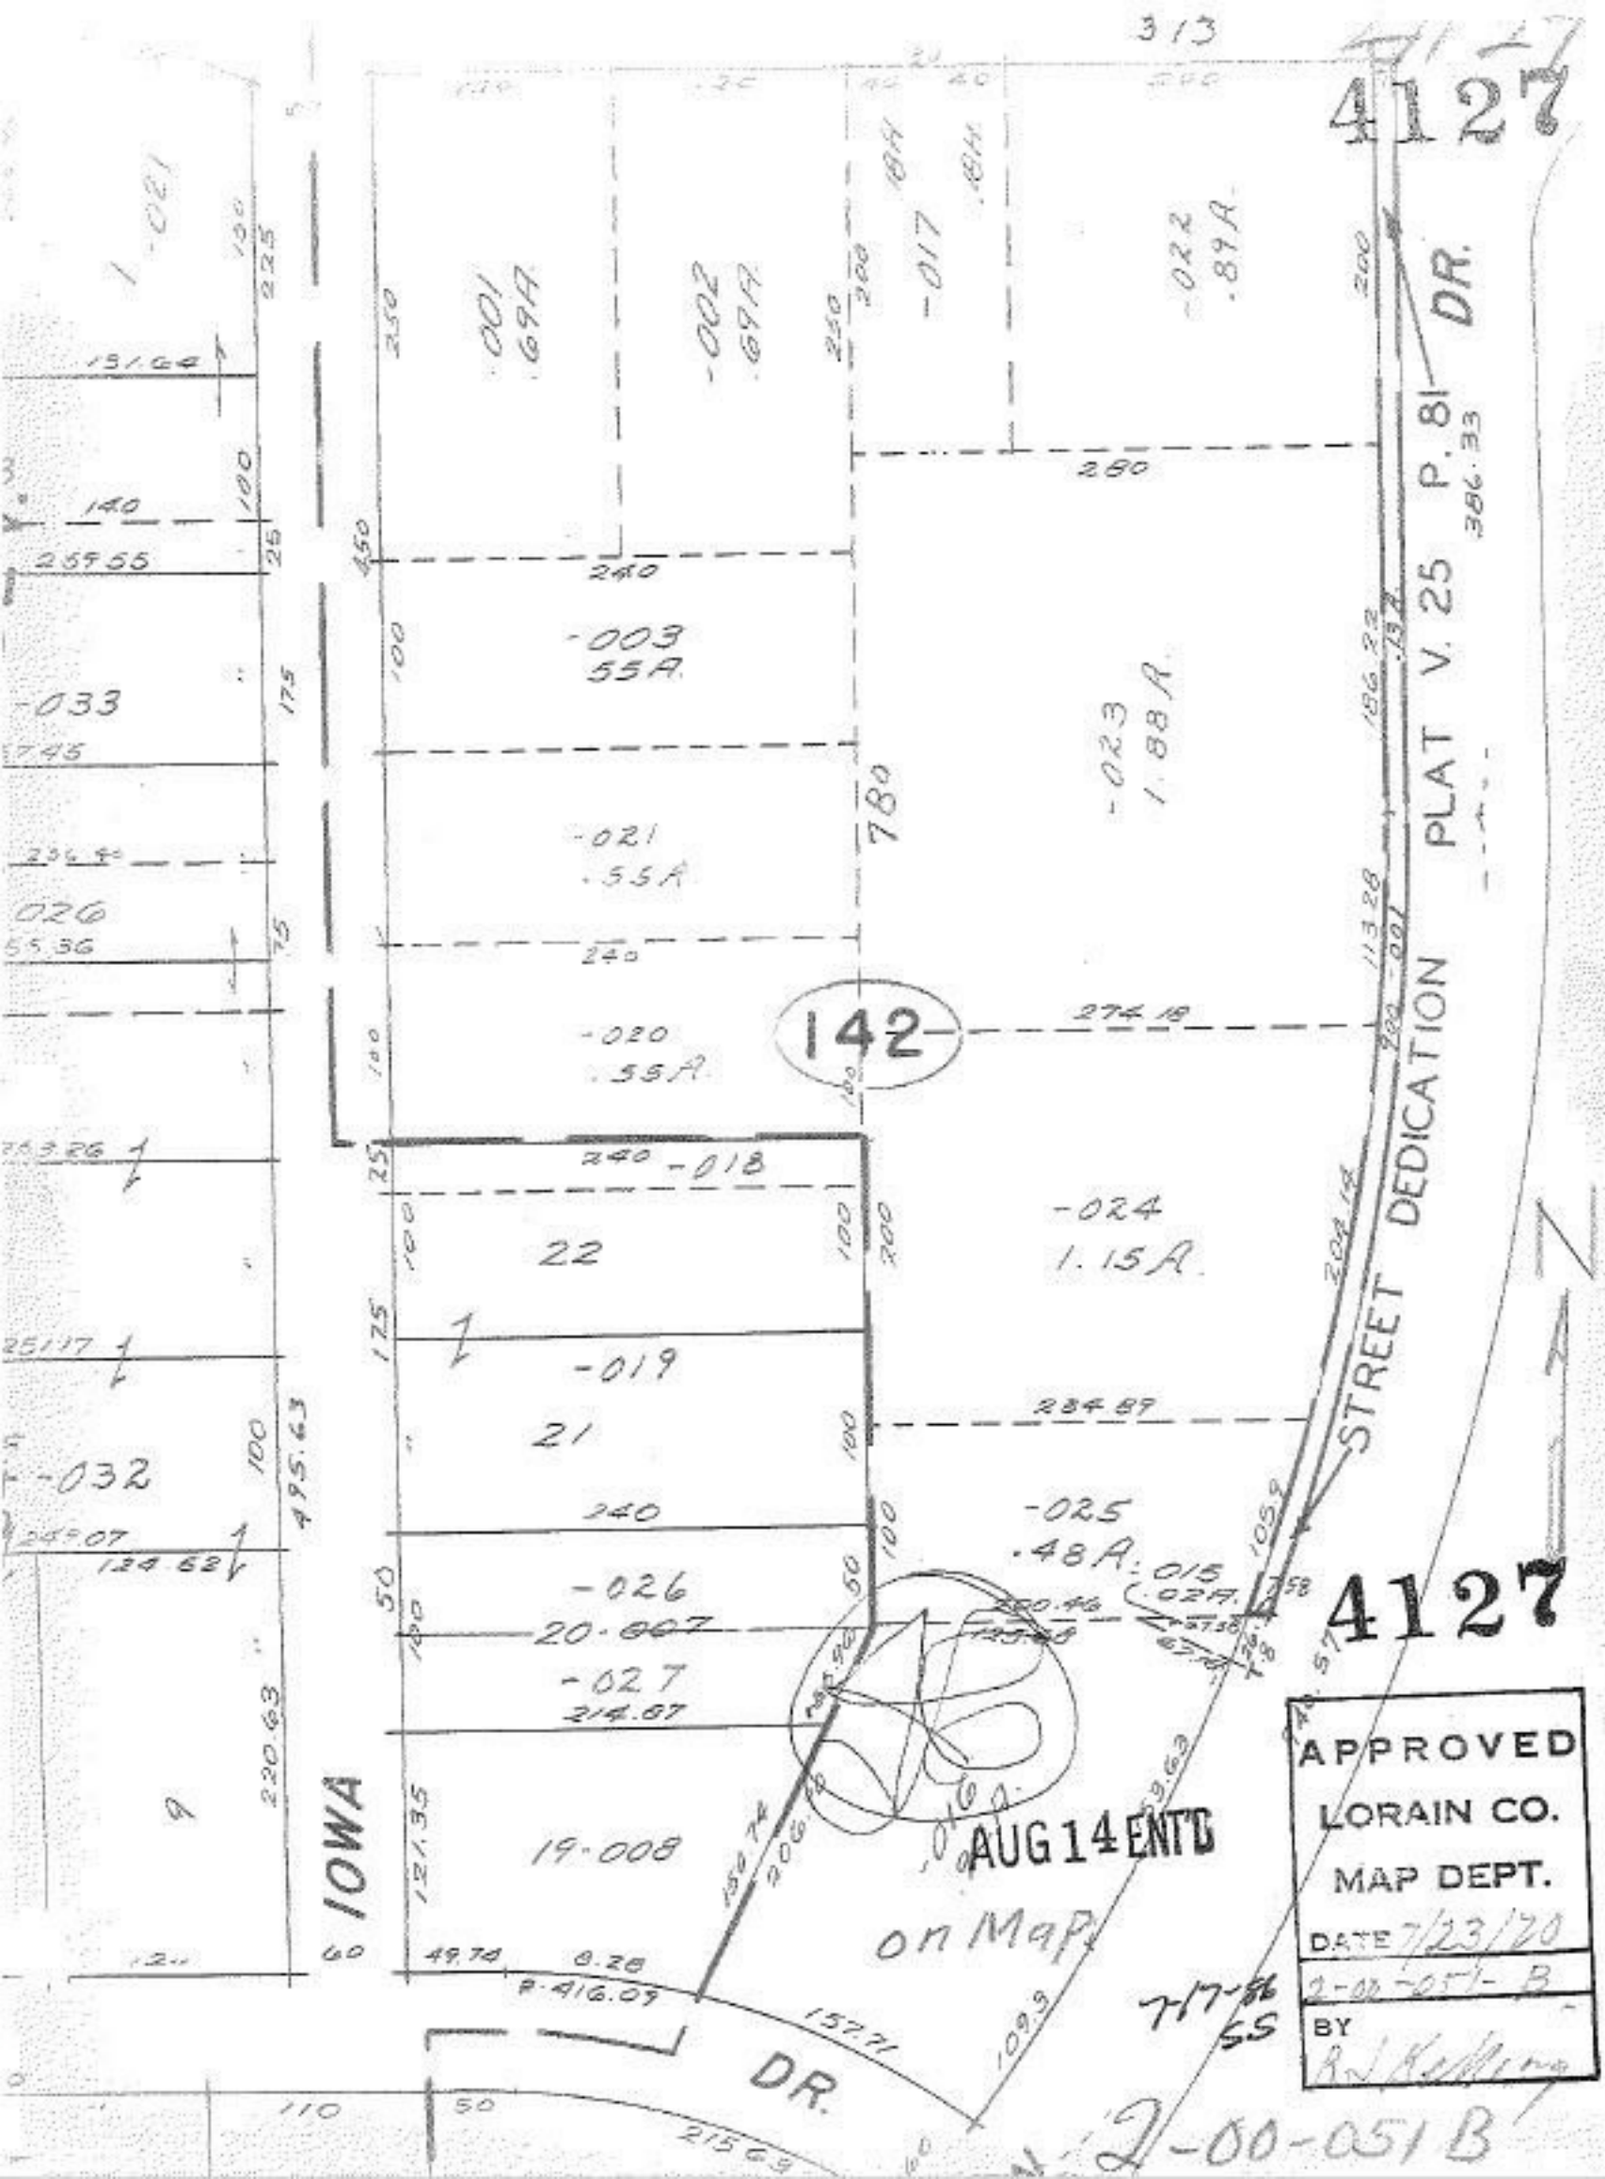
313
4127
-001 .69A
-002 .69A
-017 .18A
-022 .89A
-003 .55A
-023 1.88A
-021 .55A
-020 .55A
142
-018
22
-019
21
-024 1.15A
-025 .48A
-026
20.667
-027
214.07
19.008
-032
-033
1-021
STREET DEDICATION PLAT V. 25 P. 81
DR.
IOWA
DR.
AUG 14 ENTD
on Map
APPROVED
LORAIN CO.
MAP DEPT.
DATE 7/23/20
2-00-051-B
BY R.J. Kellum
7-17-86
S.S.
2-00-051 B