4128

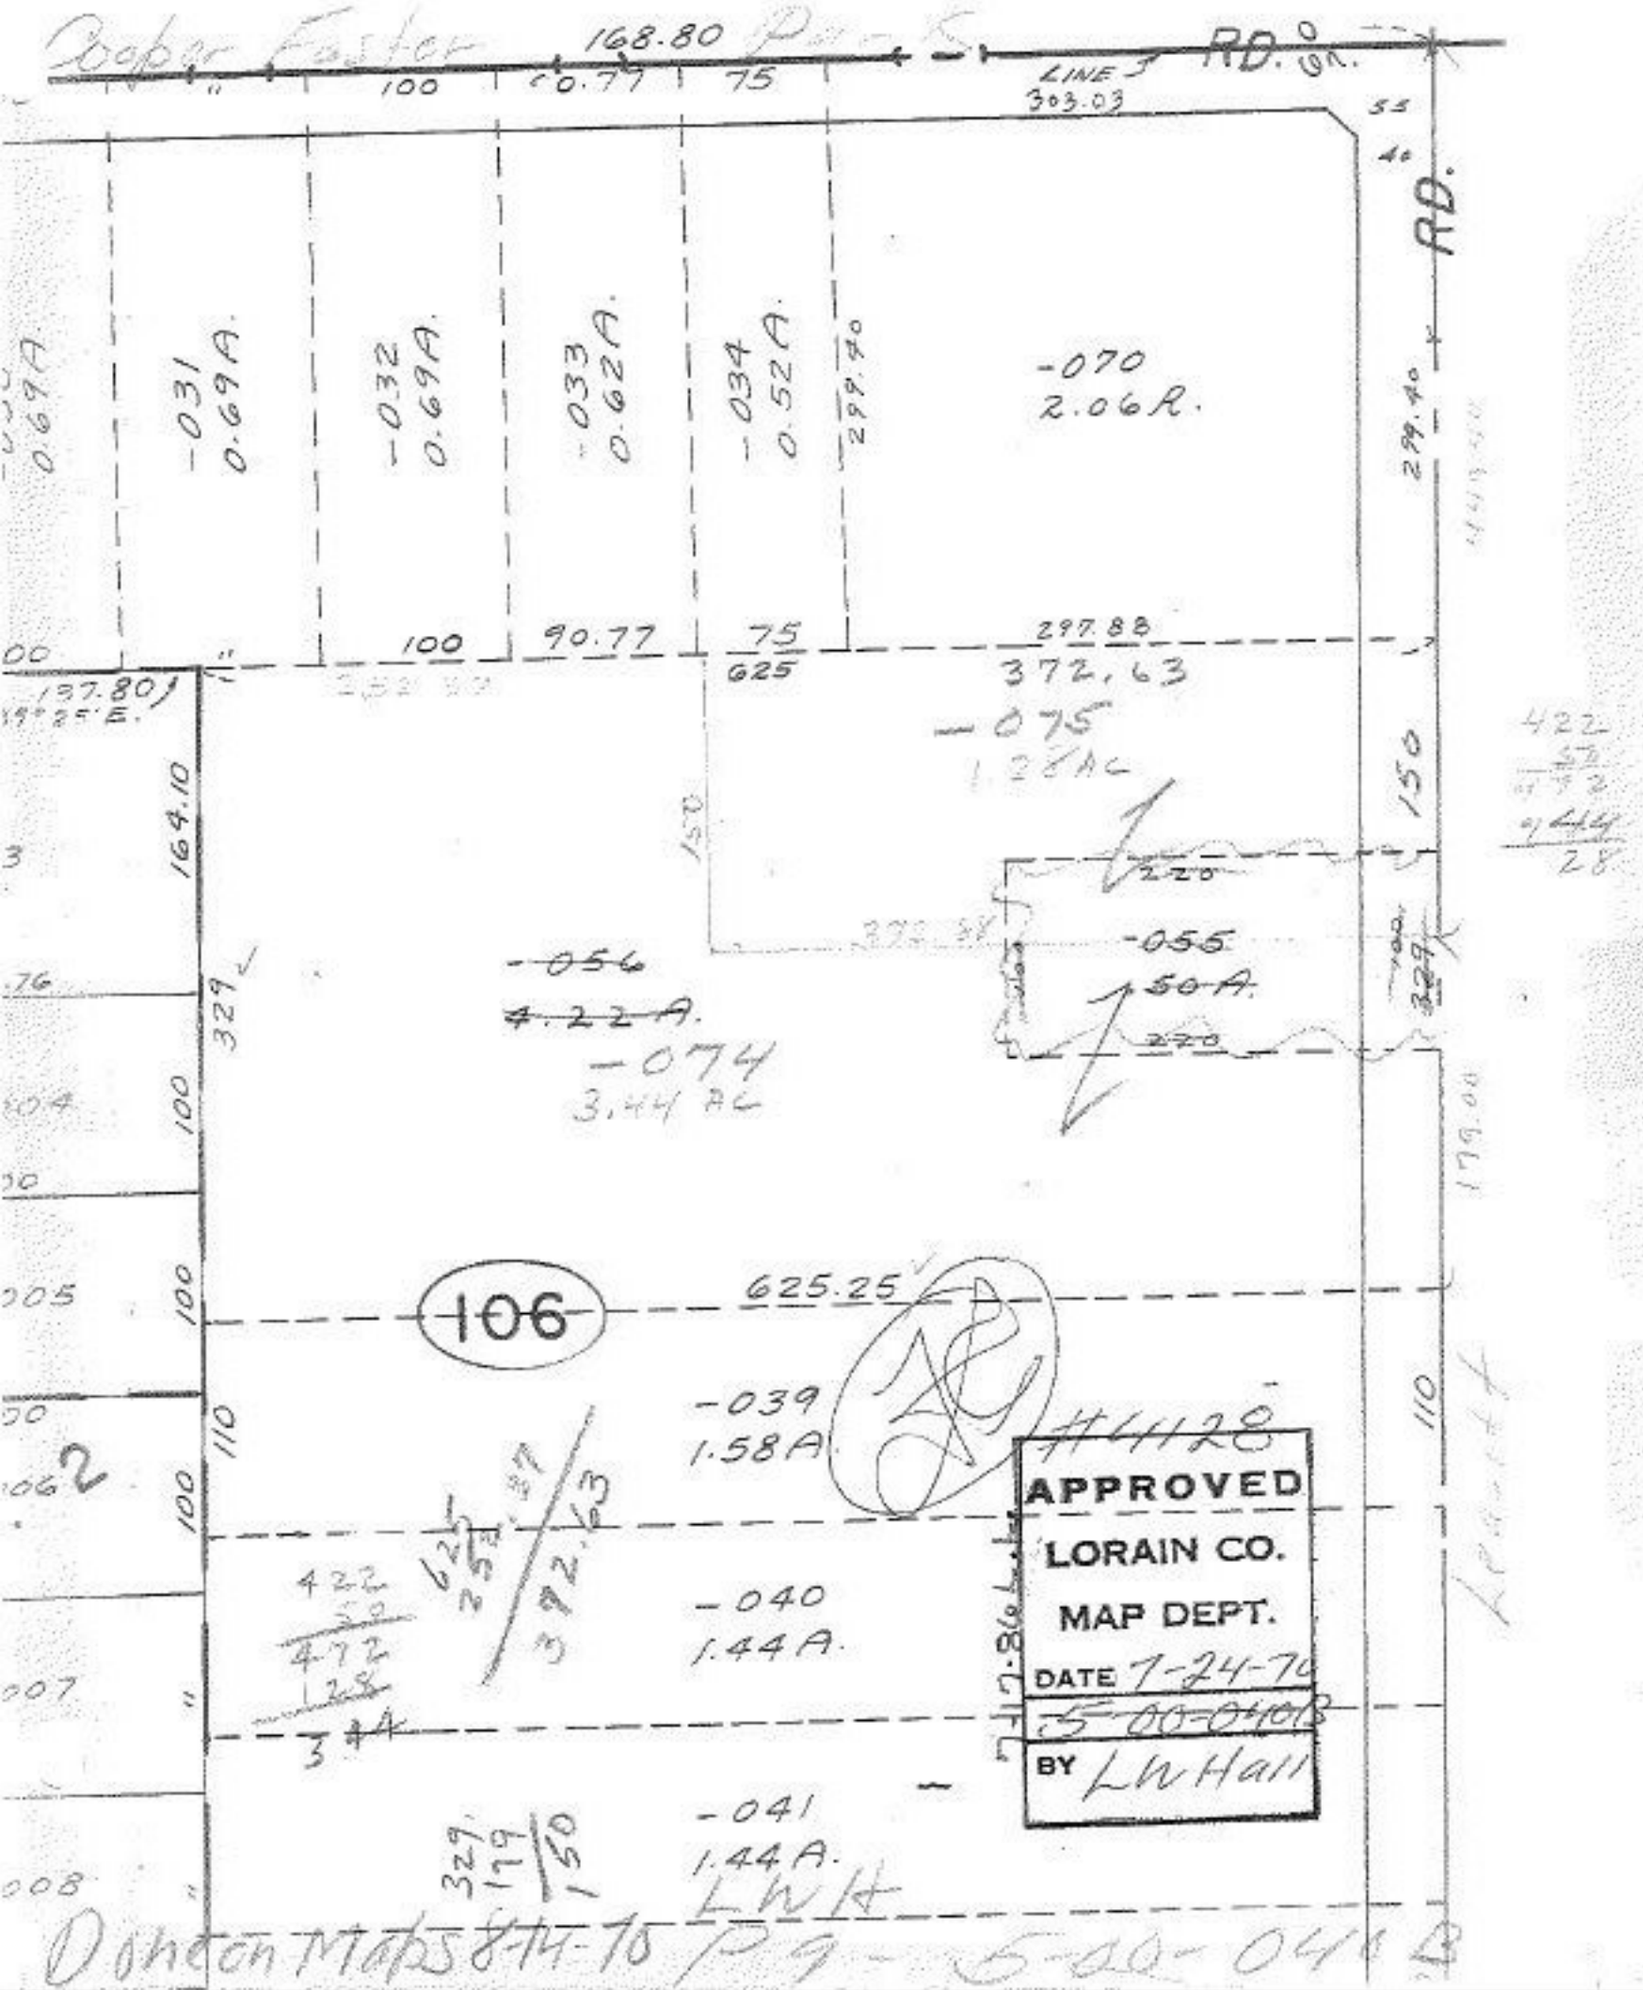

Cooper Foster Park
168.80
RD.
LINE
303.03
100
90.77
75
-031
0.69A.
-032
0.69A.
-033
0.62A.
-034
0.52A.
299.40
-070
2.06A.
100
90.77
75
625
297.88
372.63
-075
1.28AC
137.80
164.10
150
220
-056
4.22A.
-055
50A.
-074
3.44 AC
329
179.00
106
625.25
-039
1.58A.
#4128
APPROVED
LORAIN CO.
MAP DEPT.
DATE 7-24-70
5-00-040B
BY LW Hall
-040
1.44A.
422
50
472
128
344
-041
1.44A.
329
179
150
LWH
Donecon Maps 8-14-70 Pg - 5-00-040B