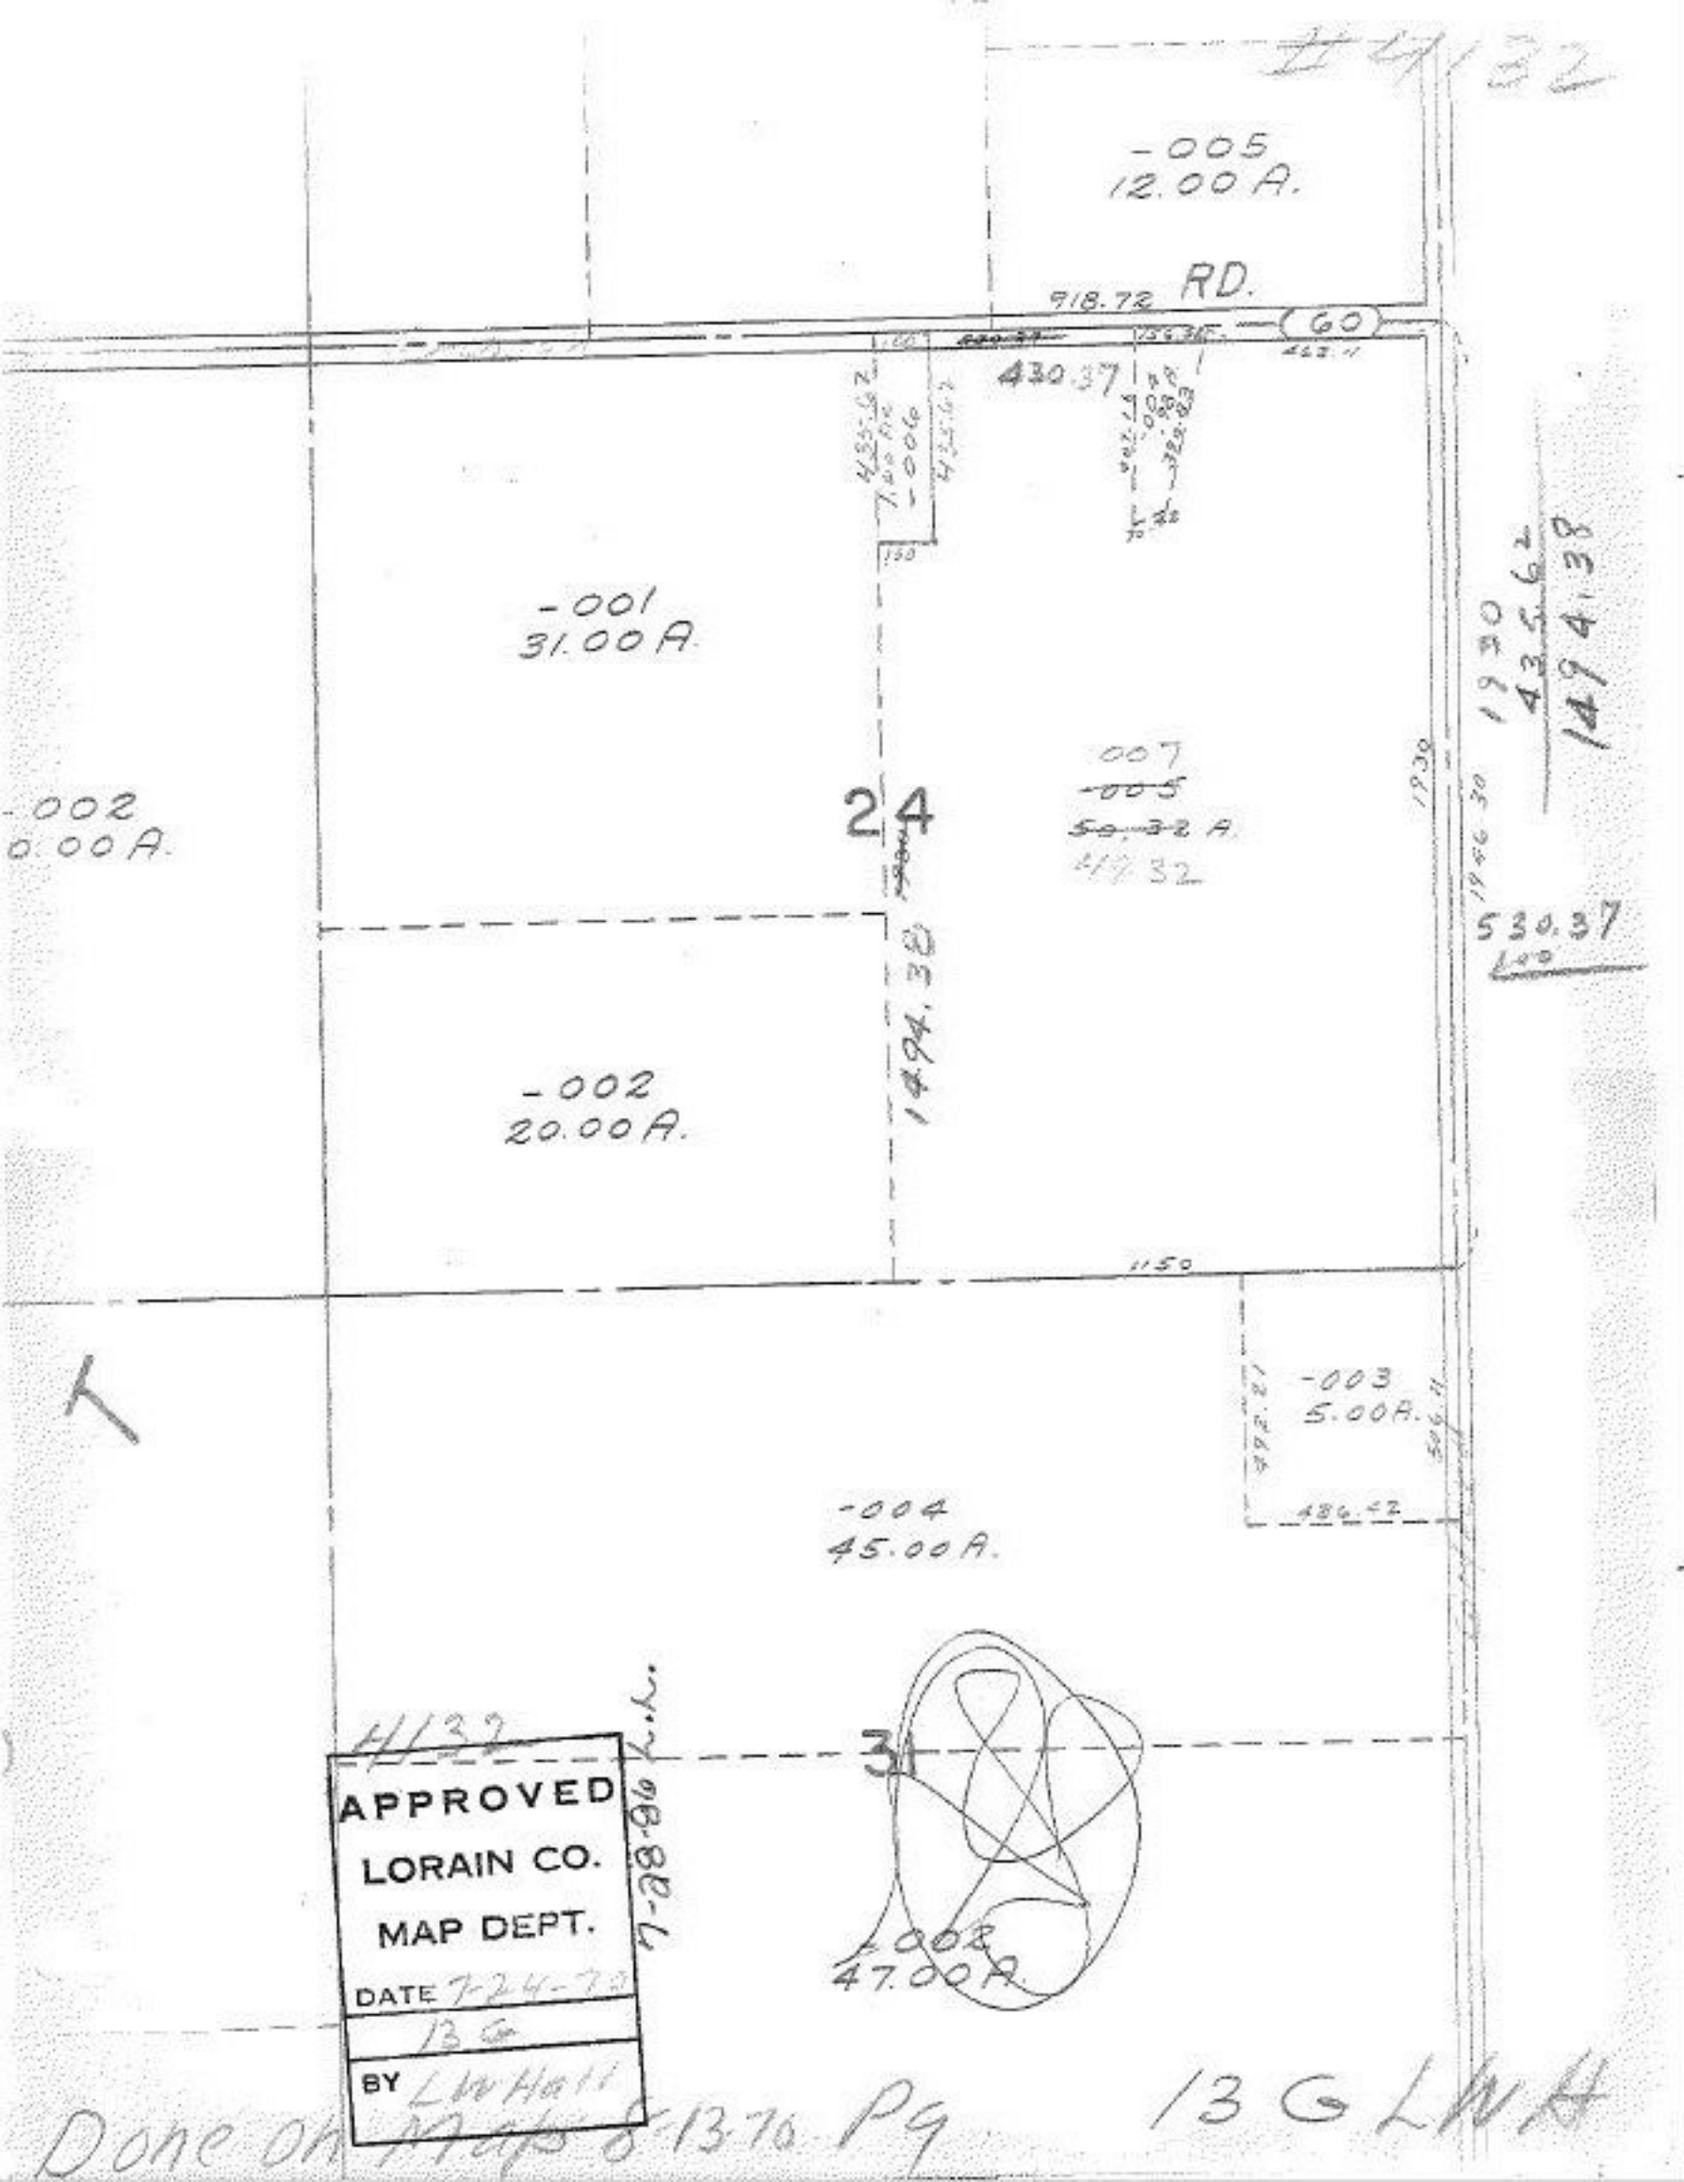

#4132
-005
12.00 A.
RD.
918.72
60
430.37
-001
31.00 A.
-002
0.00 A.
24
007
-005
50.32 A.
49.32
1494.38
530.37
-002
20.00 A.
1150
-003
5.00 A.
-004
45.00 A.
4132
31
-002
47.00 A.
APPROVED
LORAIN CO.
MAP DEPT.
DATE 7-24-70
13 G
BY LW Hall
7-28-86 L.L.
Done on Map 8-13-70 Pg
13 G LWH