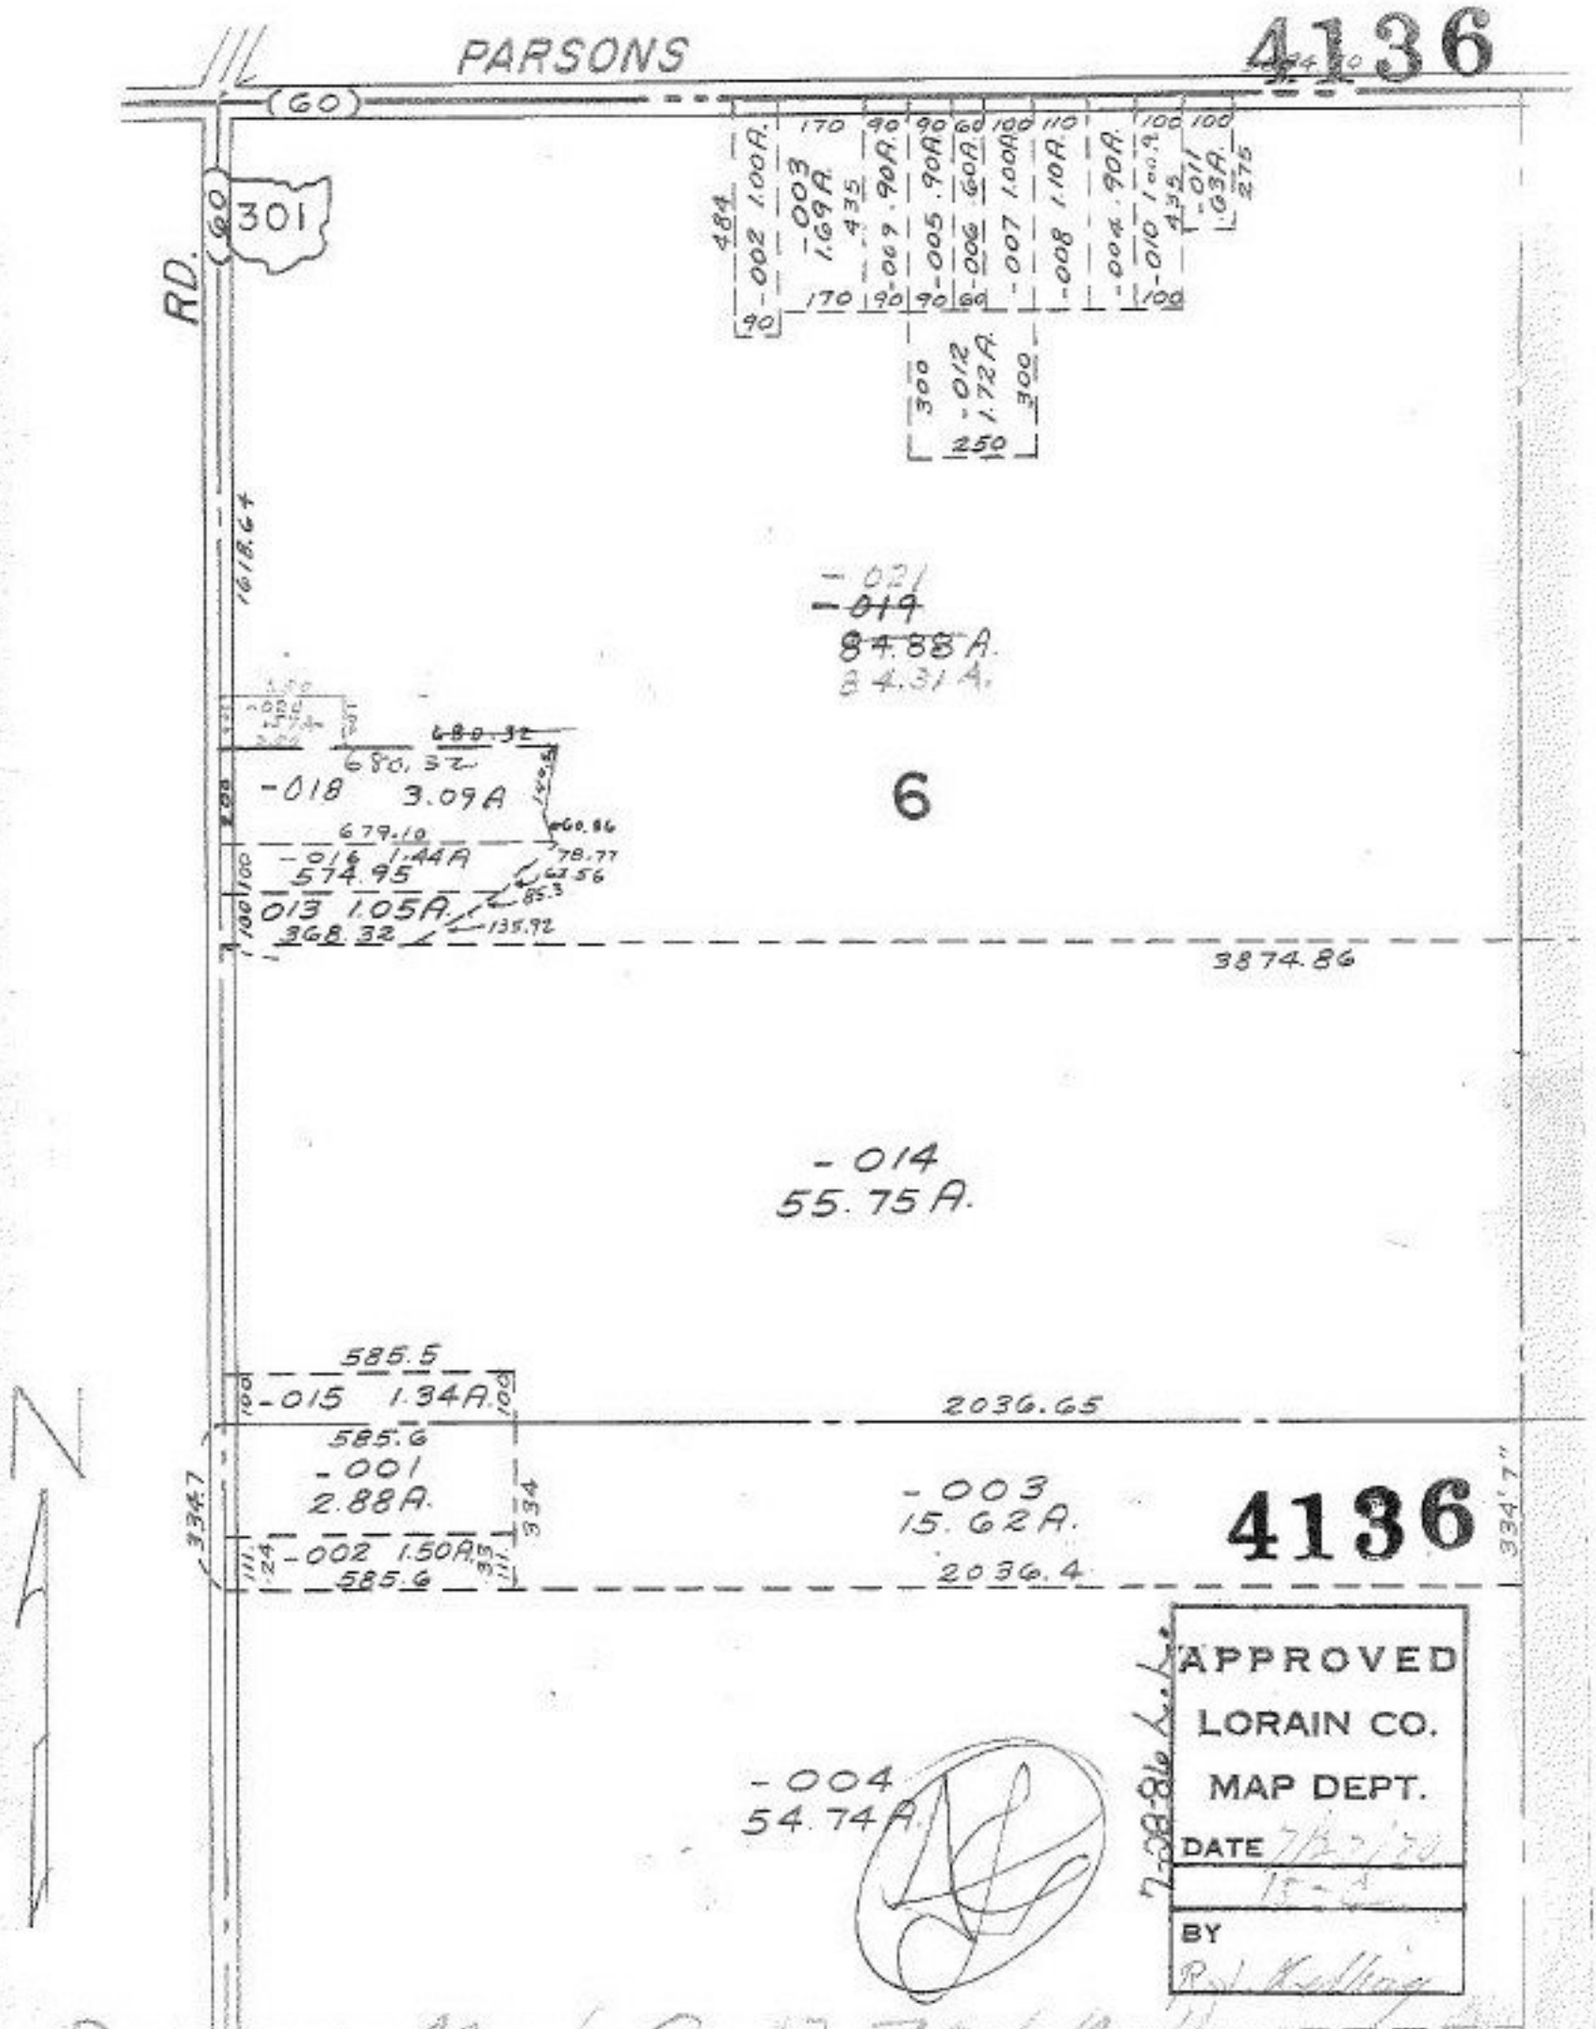
PARSONS
4136
(60)
301
RD.
(60)
1618.64
-002 1.00A.
-003 1.69A.
-004 .90A.
-005 .90A.
-006 .60A.
-007 1.00A.
-008 1.10A.
-009 .90A.
-010 1.00A.
-011 1.63A.
-012 1.72A.
-021
-019
84.88A.
84.31A.
6
680.32
-018 3.09A
679.10
-016 1.44A
574.95
013 1.05A.
368.32
3874.86
-014
55.75A.
585.5
-015 1.34A.
585.6
-001
2.88A.
-002 1.50A.
585.6
2036.65
-003
15.62A.
2036.4
4136
334.7"
334.7
-004
54.74A.
APPROVED
LORAIN CO.
MAP DEPT.
DATE 7/22/70
BY
7-28-81 Lot Split
Duncan Map 8-15-70 Lot 4