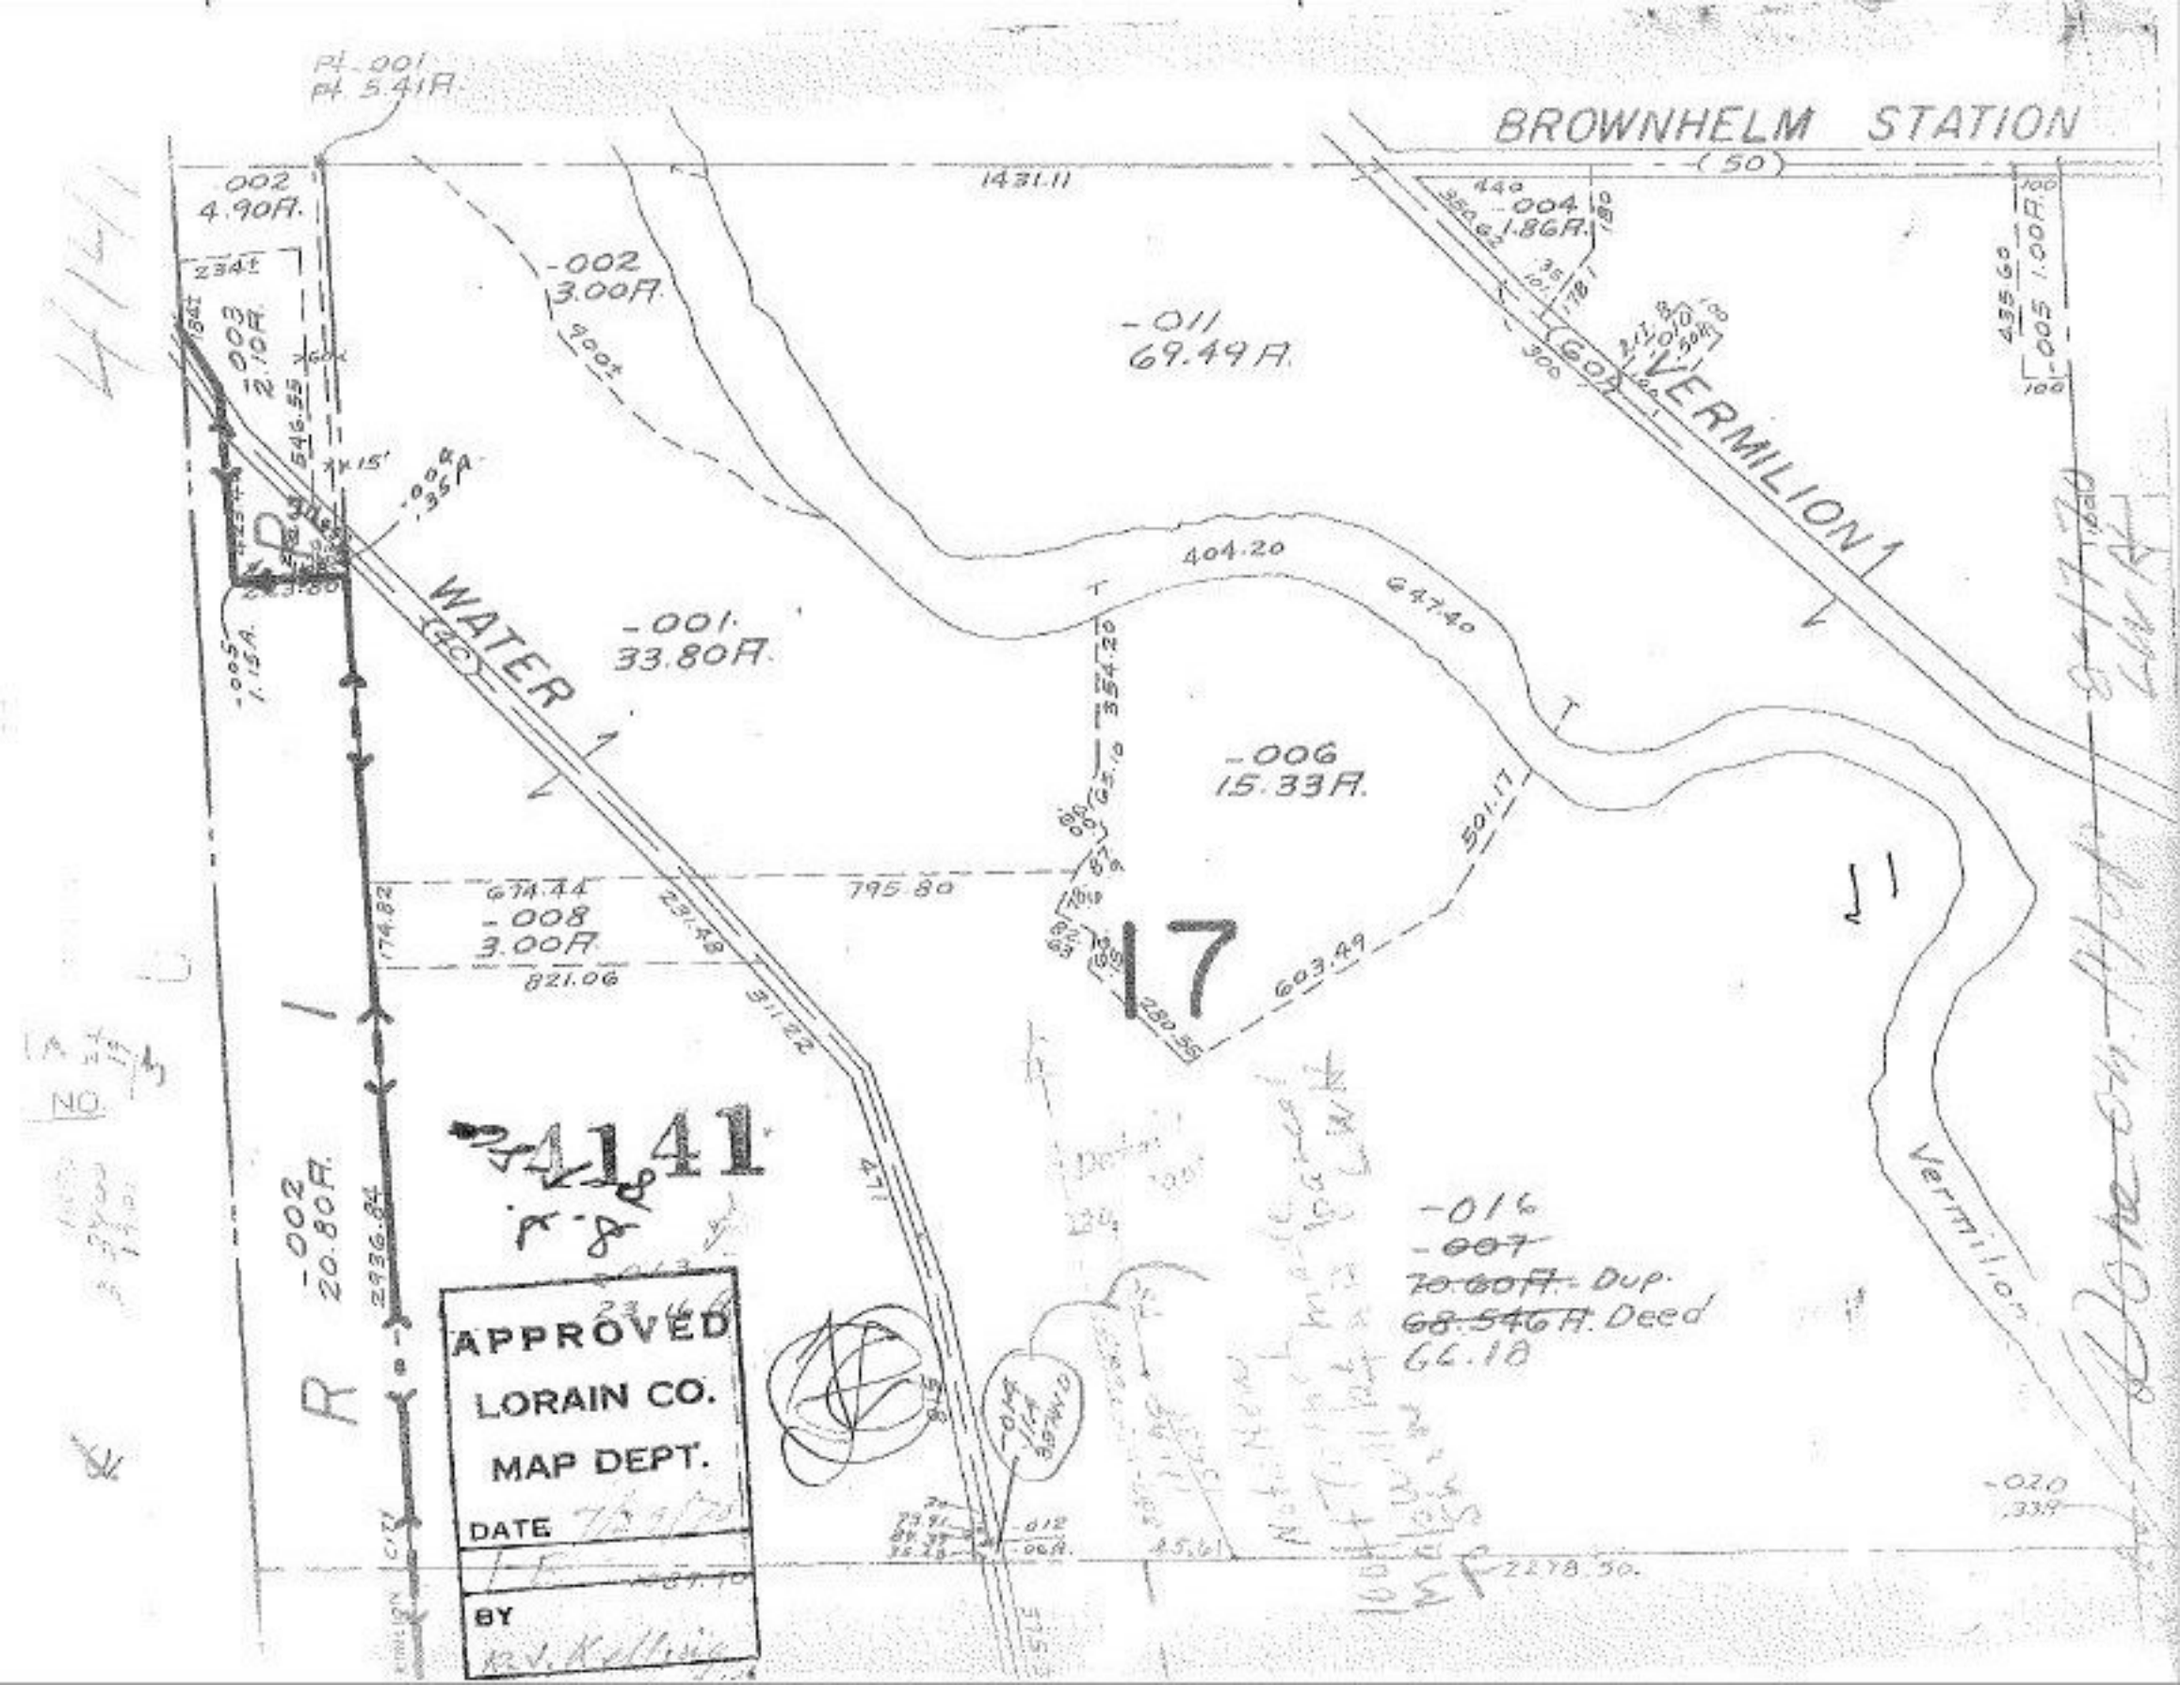

BROWNHELM STATION
(50)
Pt. 001
Pt. 5.41A.
.002
4.90A.
1431.11
-002
3.00A.
-011
69.49A.
-004
1.86A.
VERMILION
WATER
(40)
-001
33.80A.
404.20
647.40
-006
15.33A.
501.17
674.44
795.80
-008
3.00A.
821.06
17
603.49
280.55
4141
-002
20.80A.
2936.84
-016
~~-007~~
~~70.60A.~~ Dup.
~~68.546A.~~ Deed
66.18
Vermilion
APPROVED
LORAIN CO.
MAP DEPT.
DATE
BY