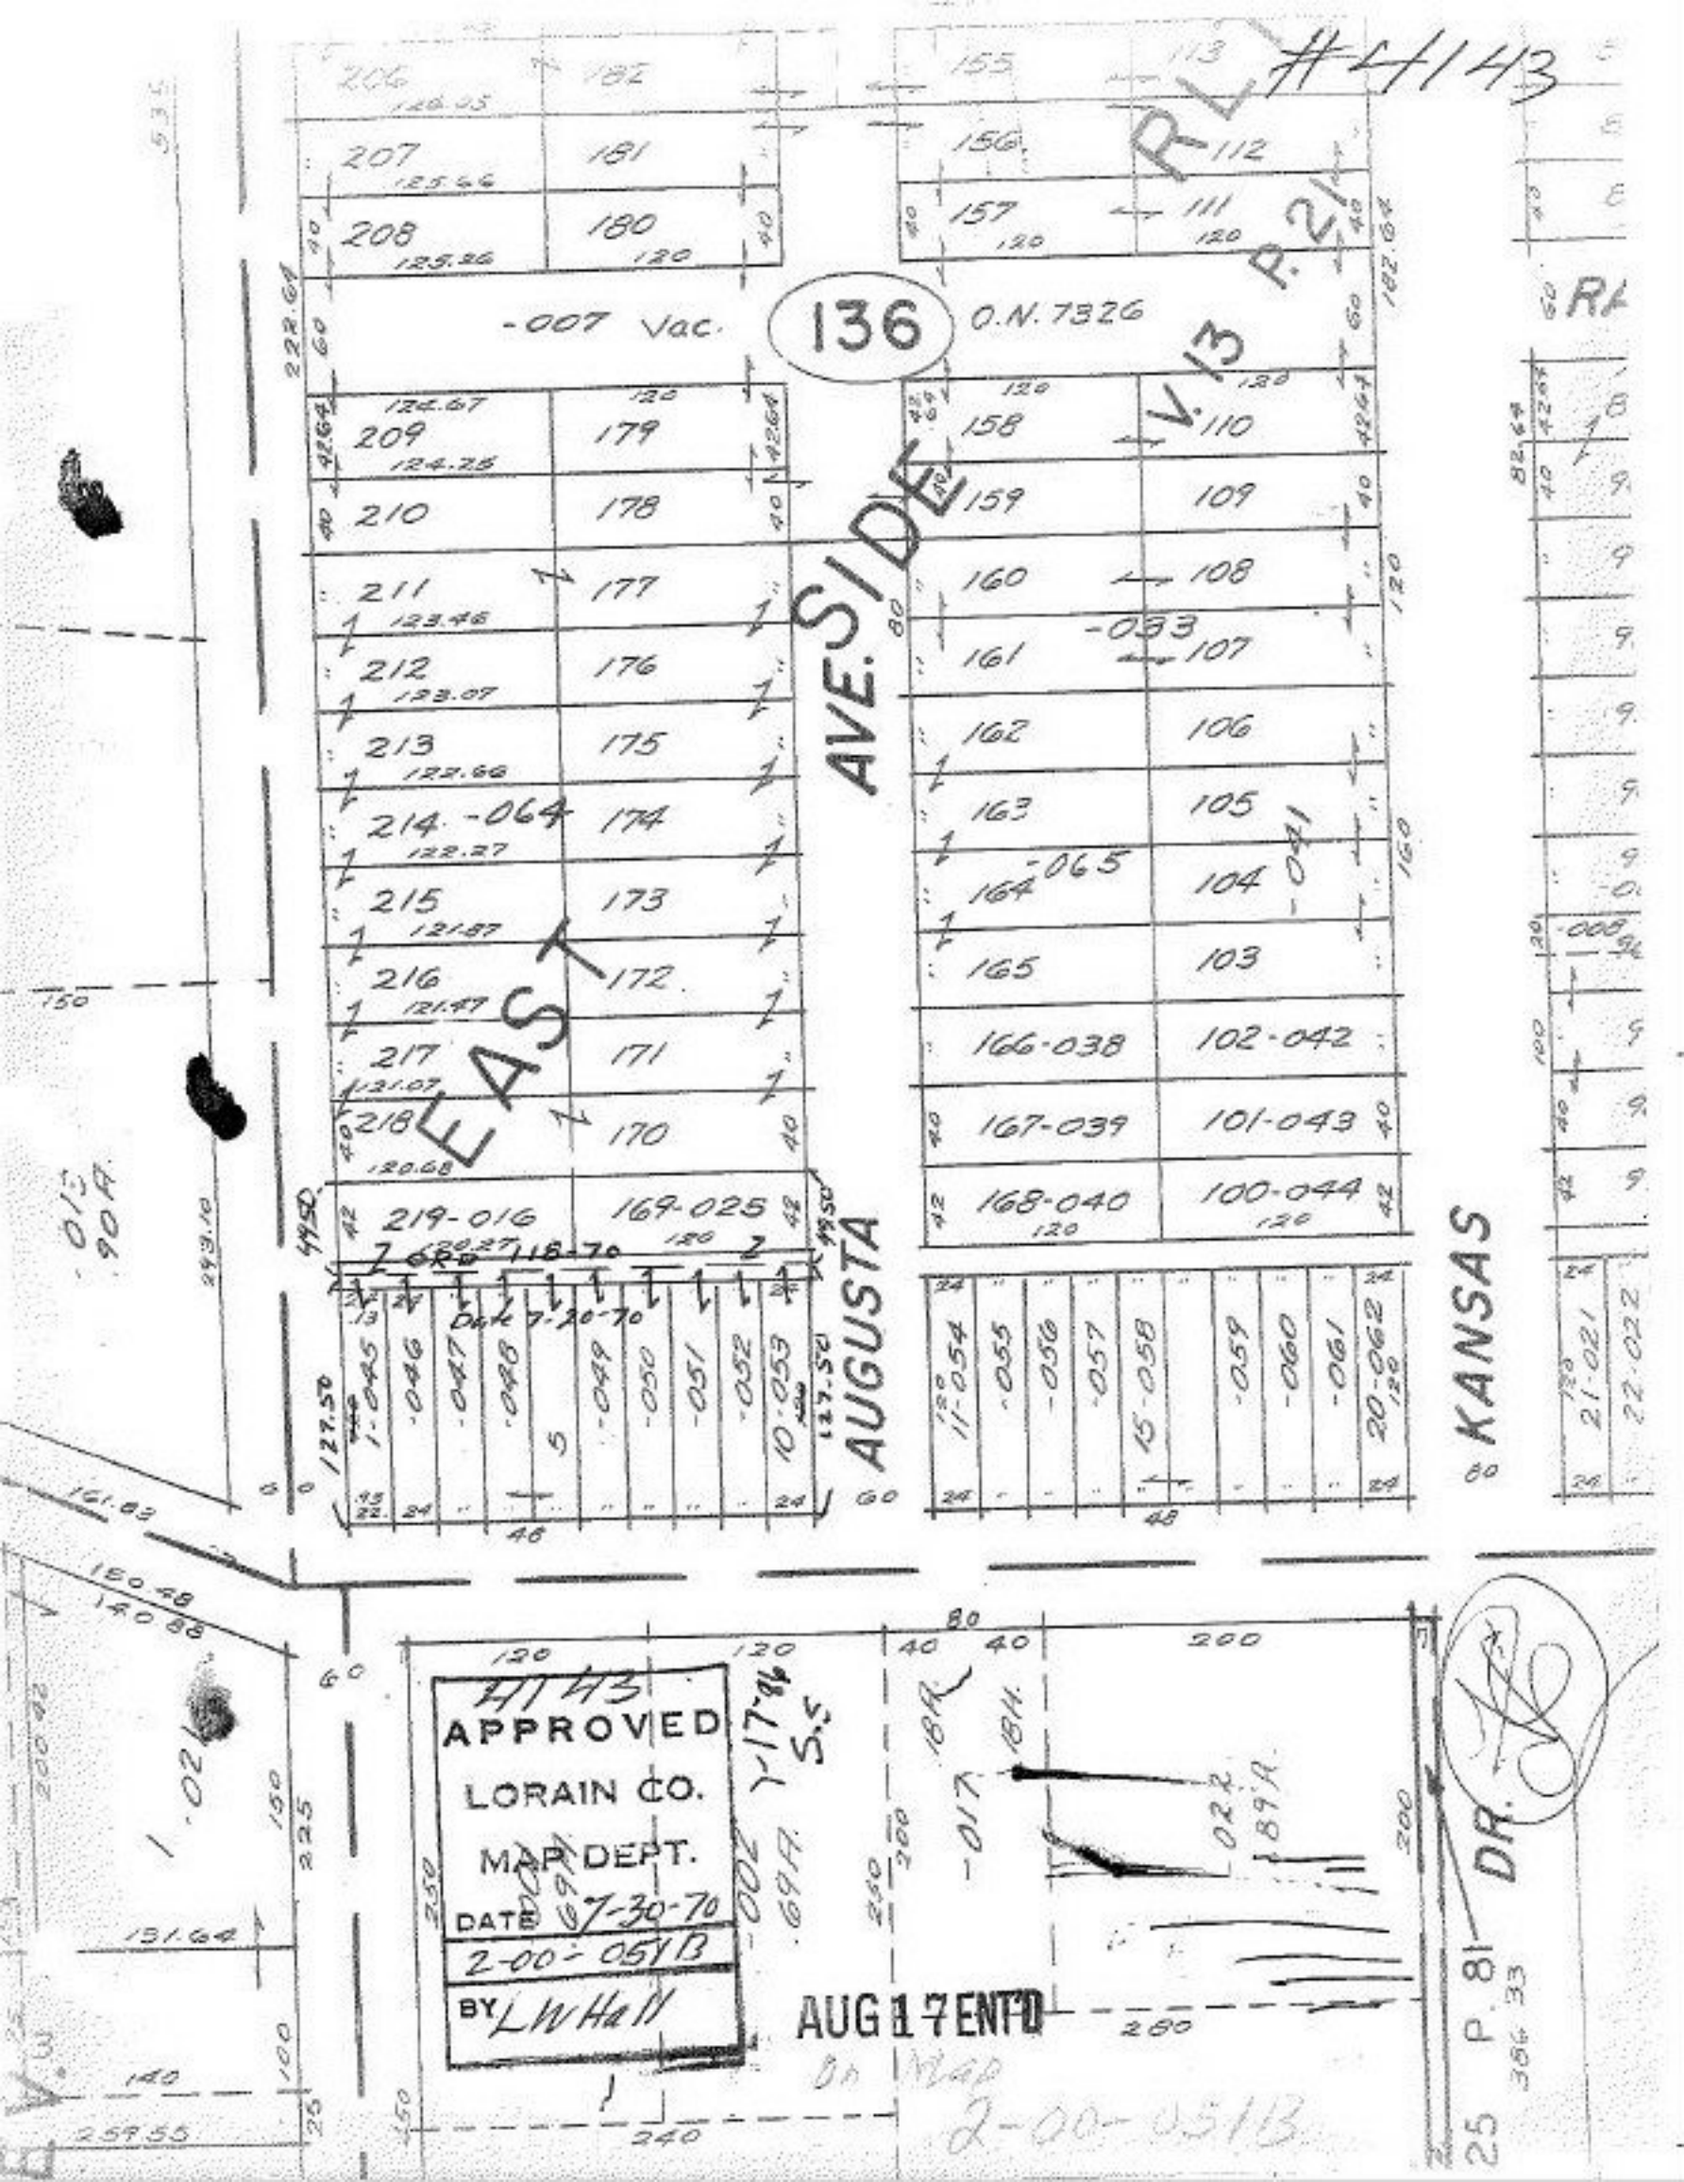
#4143
136
O.N. 7326
-007 Vac.
EAST AVE. SIDE
AUGUSTA
KANSAS
V.13 P.21
RL
Date 7-20-70
APPROVED
LORAIN CO.
MAP DEPT.
DATE 7-30-70
2-00-051B
BY LW Hall
AUG 17 ENT'D
On Map
2-00-051B
DR.
P. 81