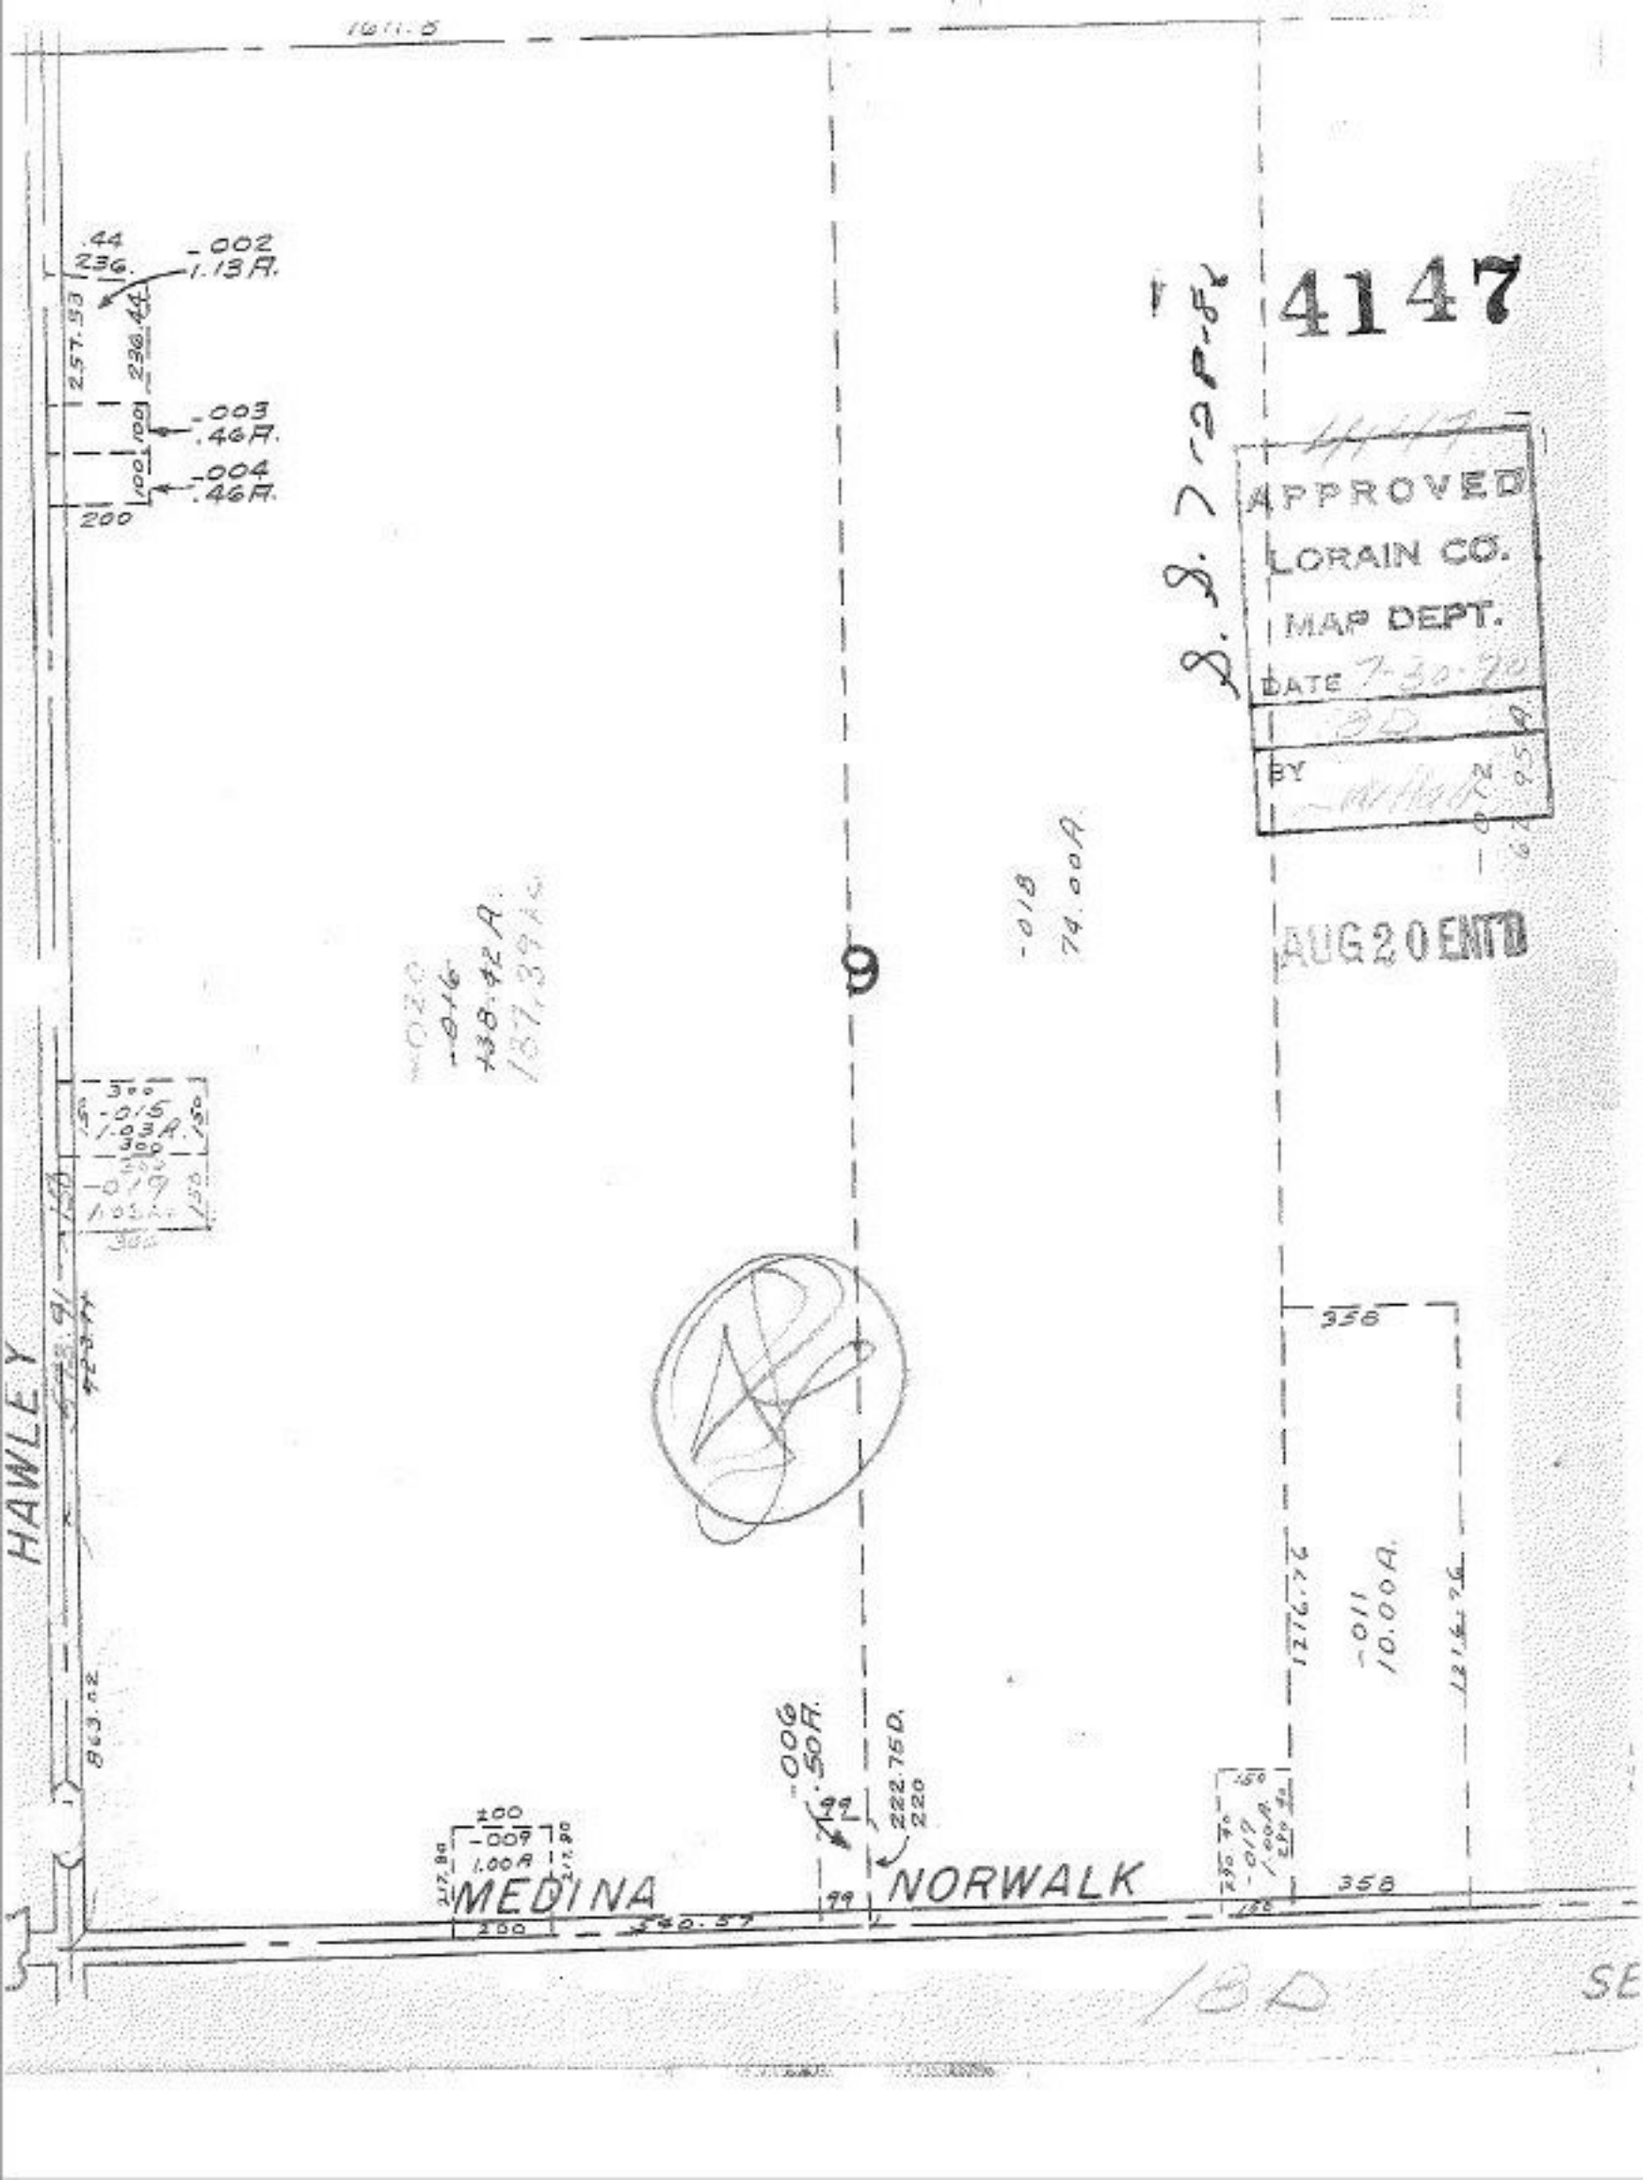
4147
APPROVED
LORAIN CO.
MAP DEPT.
DATE 7-30-92
BY
AUG 20 ENTD
HAWLEY
MEDINA
NORWALK
9
-002
1.13A.
-003
.46A.
-004
.46A.
-005
1.03A.
-006
.50A.
-016
38.42A.
187.39Ac.
-018
74.00A.
257.33
236.44
200
100
99
222.75D.
220
358
863.62
1811.5