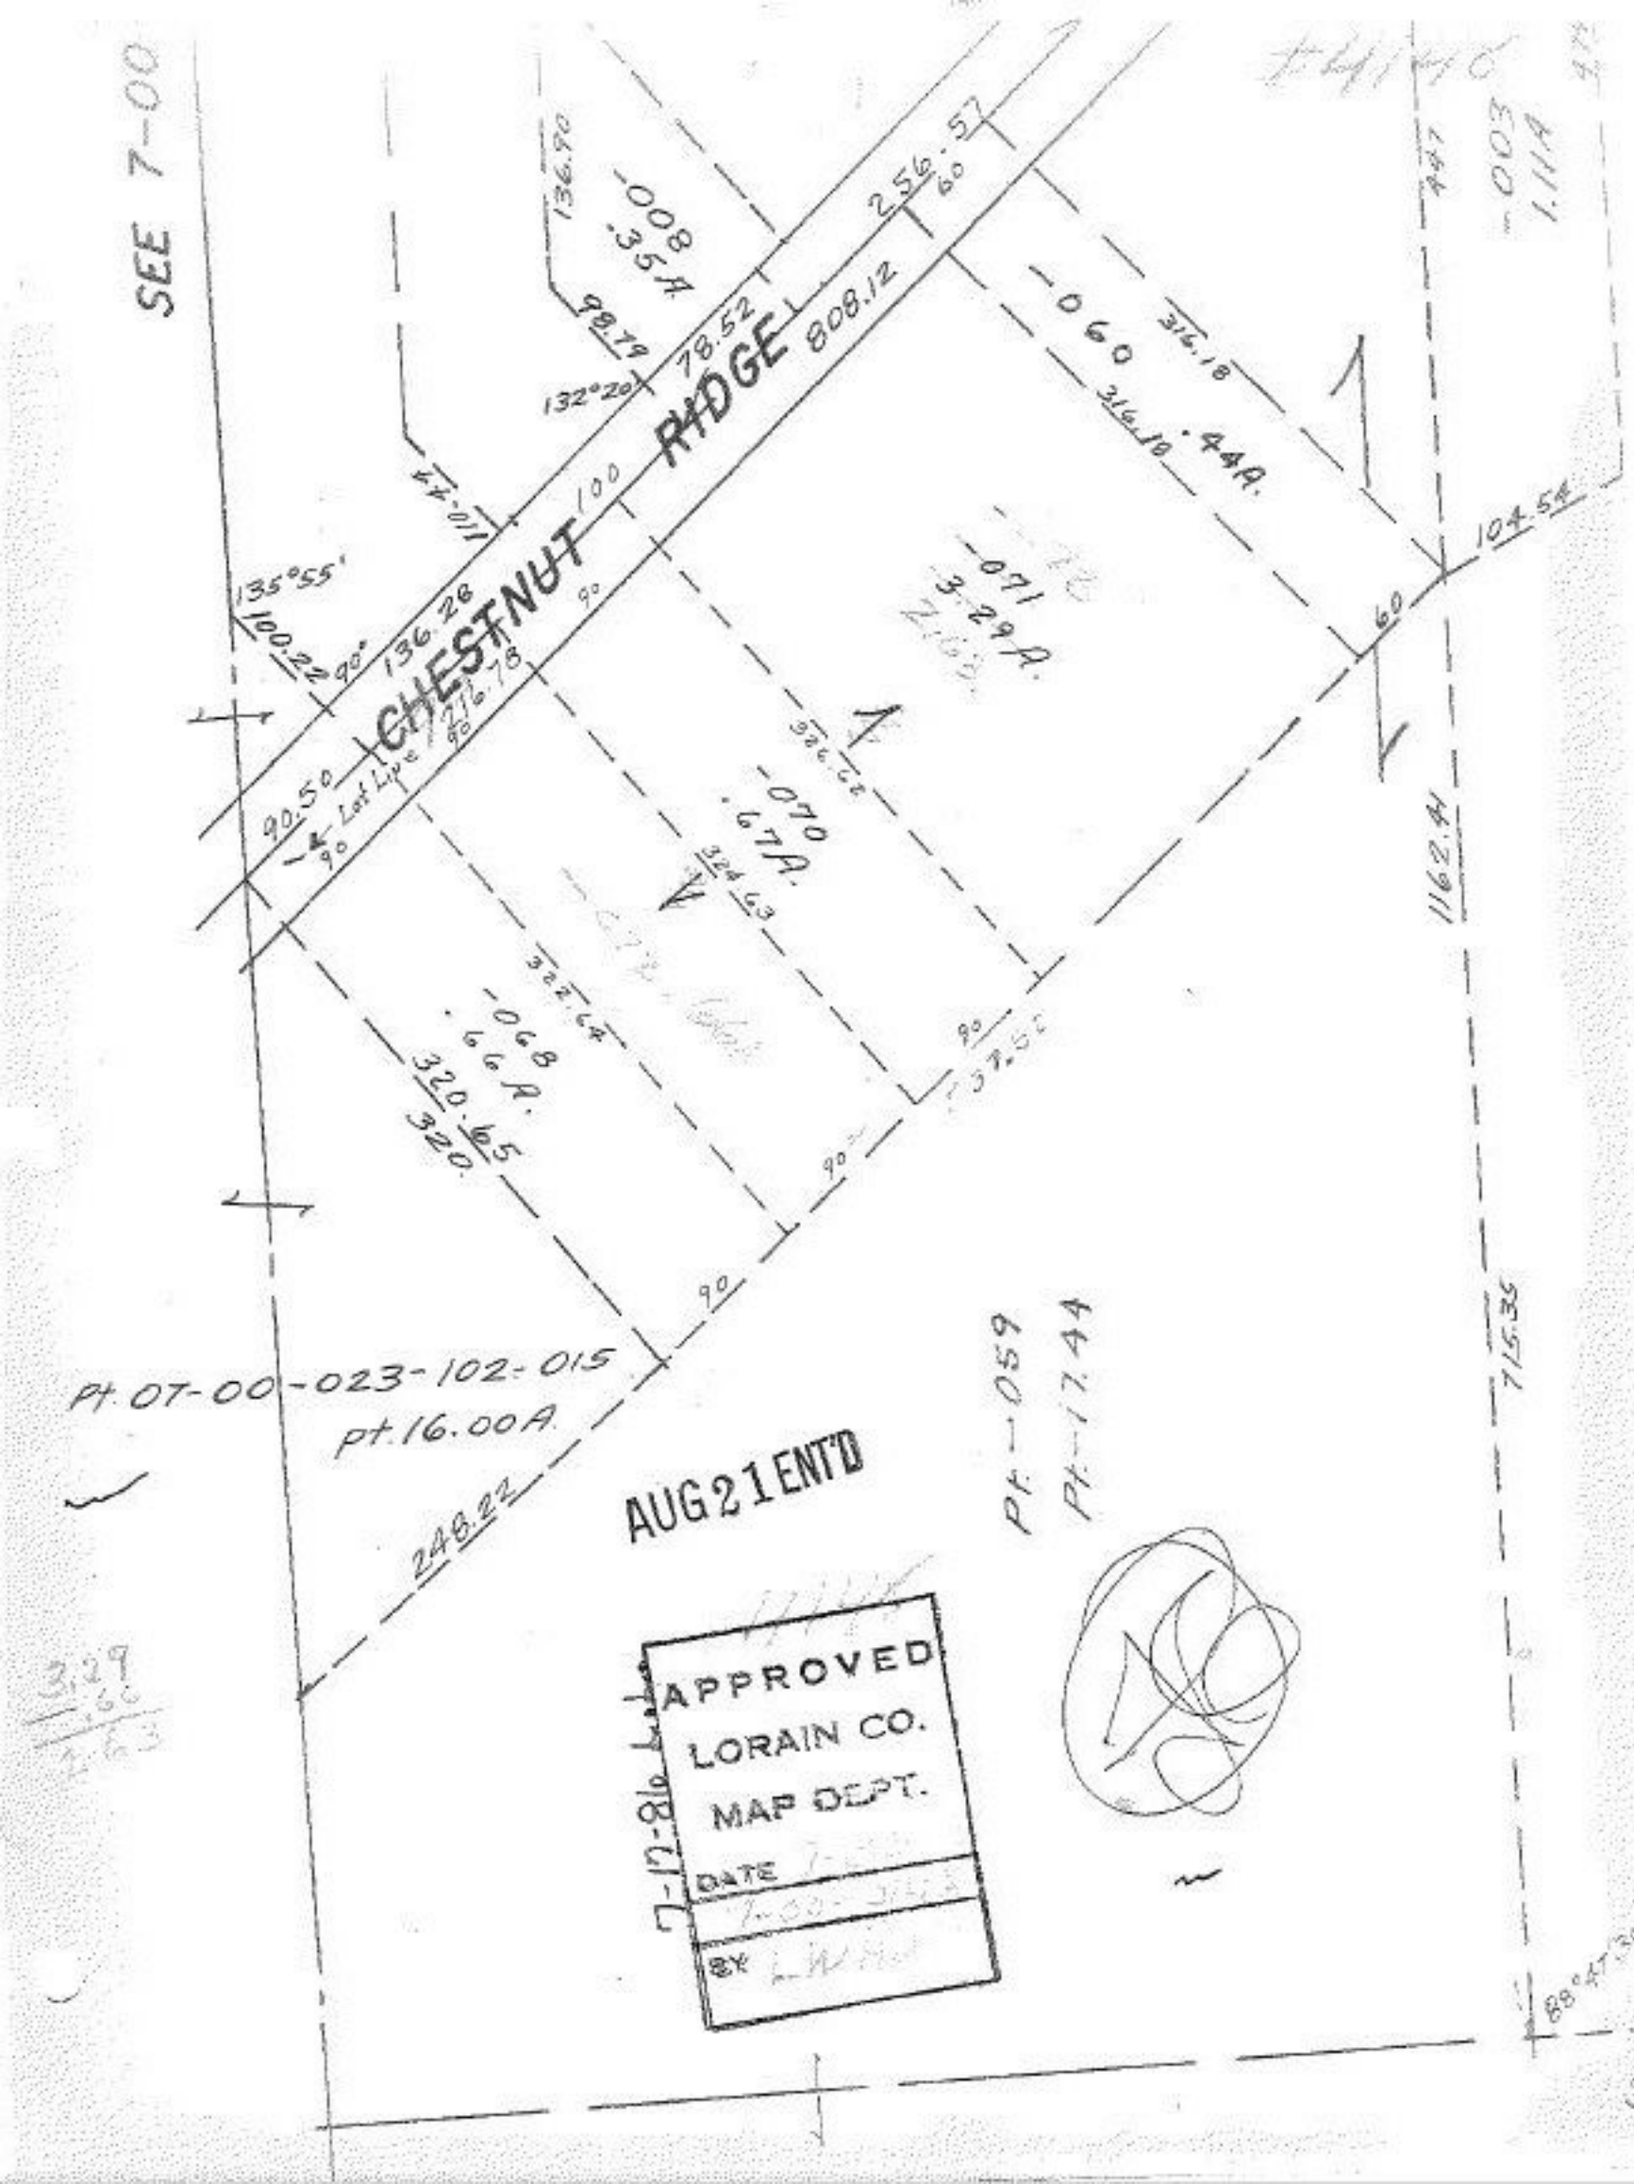
SEE 7-00
CHESTNUT RIDGE
808.12
256.57
60
316.18
316.10
.008
.35A
.060
.44A.
.071
3.29A.
.070
.67A.
.068
.66A.
320.65
320.
322.64
324.63
326.62
337.52
90
90
90