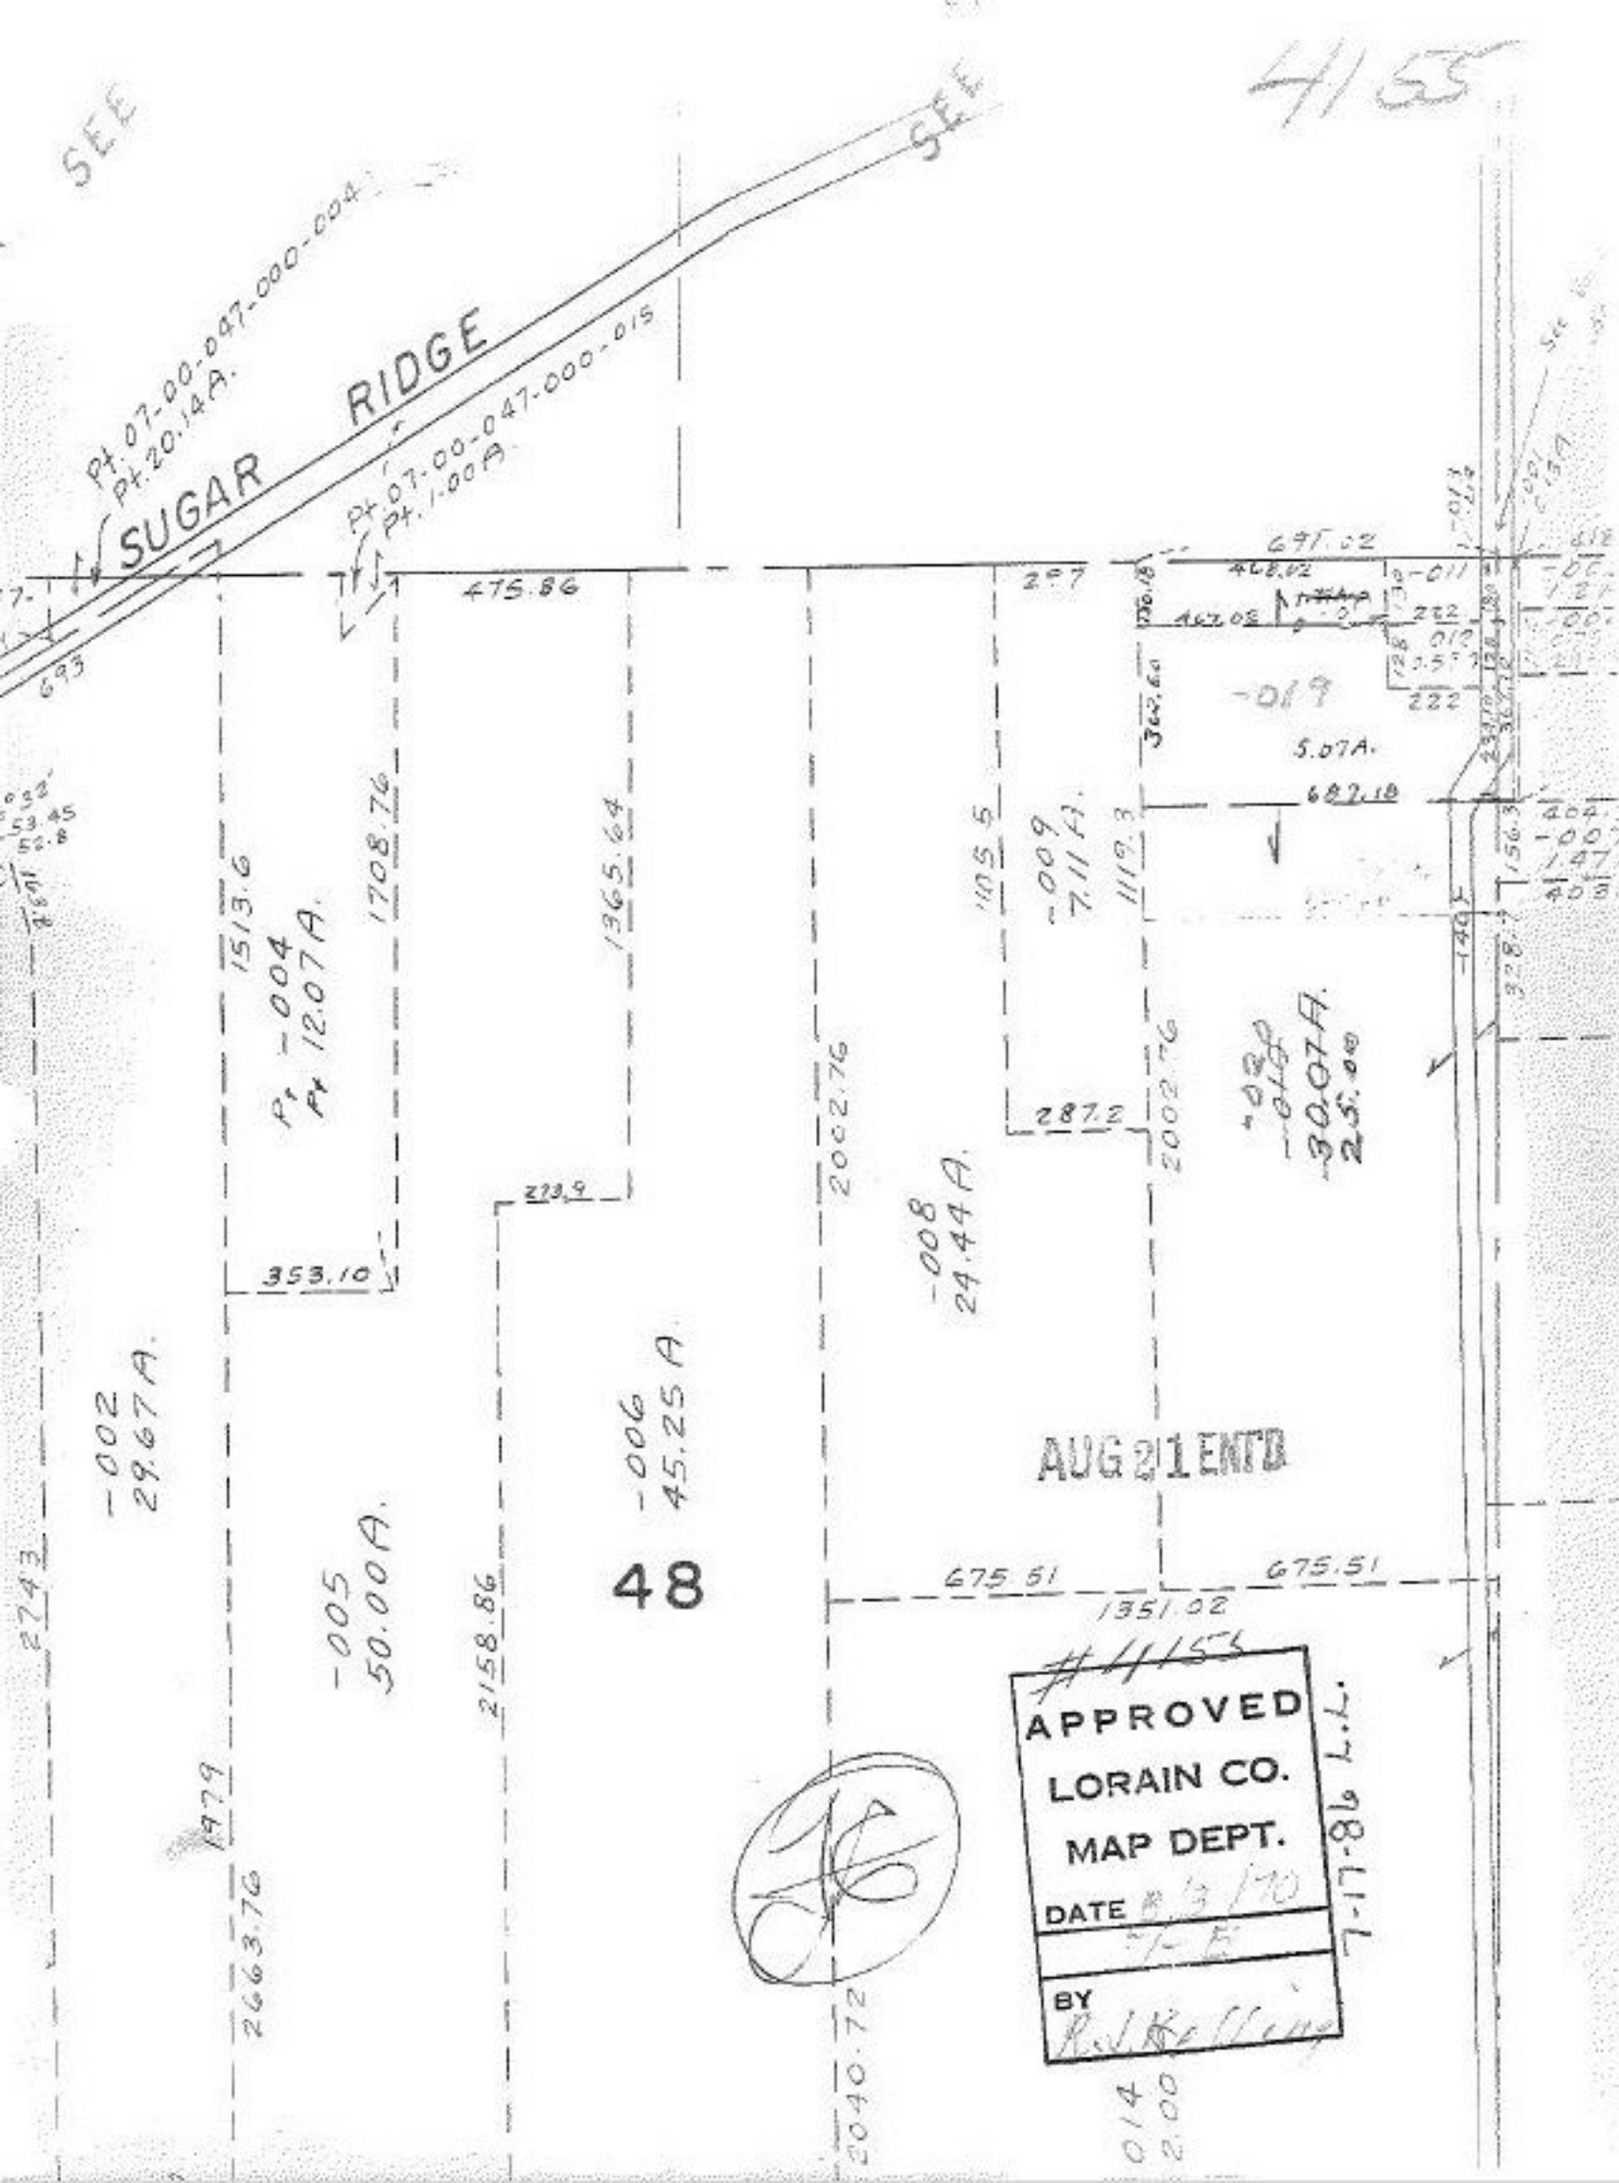
SEE
SEE
SUGAR RIDGE
Pt. 07-00-047-000-004
Pt. 20.14 A.
Pt. 07-00-047-000-015
Pt. 1.00 A.
475.86
697.02
408.02
462.08
-019
5.07A.
682.18
-009
7.11 A.
-008
24.44 A.
-002
29.67 A.
-004
Pt. 12.07 A.
-005
50.00 A.
-006
45.25 A.
-030
-040
30.07 A.
23.00
1513.6
1708.76
1365.64
2002.76
2158.86
2040.72
2663.76
1351.02
675.51
675.51
353.10
287.2
48
AUG 21 ENTD
#41553
APPROVED
LORAIN CO.
MAP DEPT.
DATE 8-3-170
BY
7-17-86 L.L.