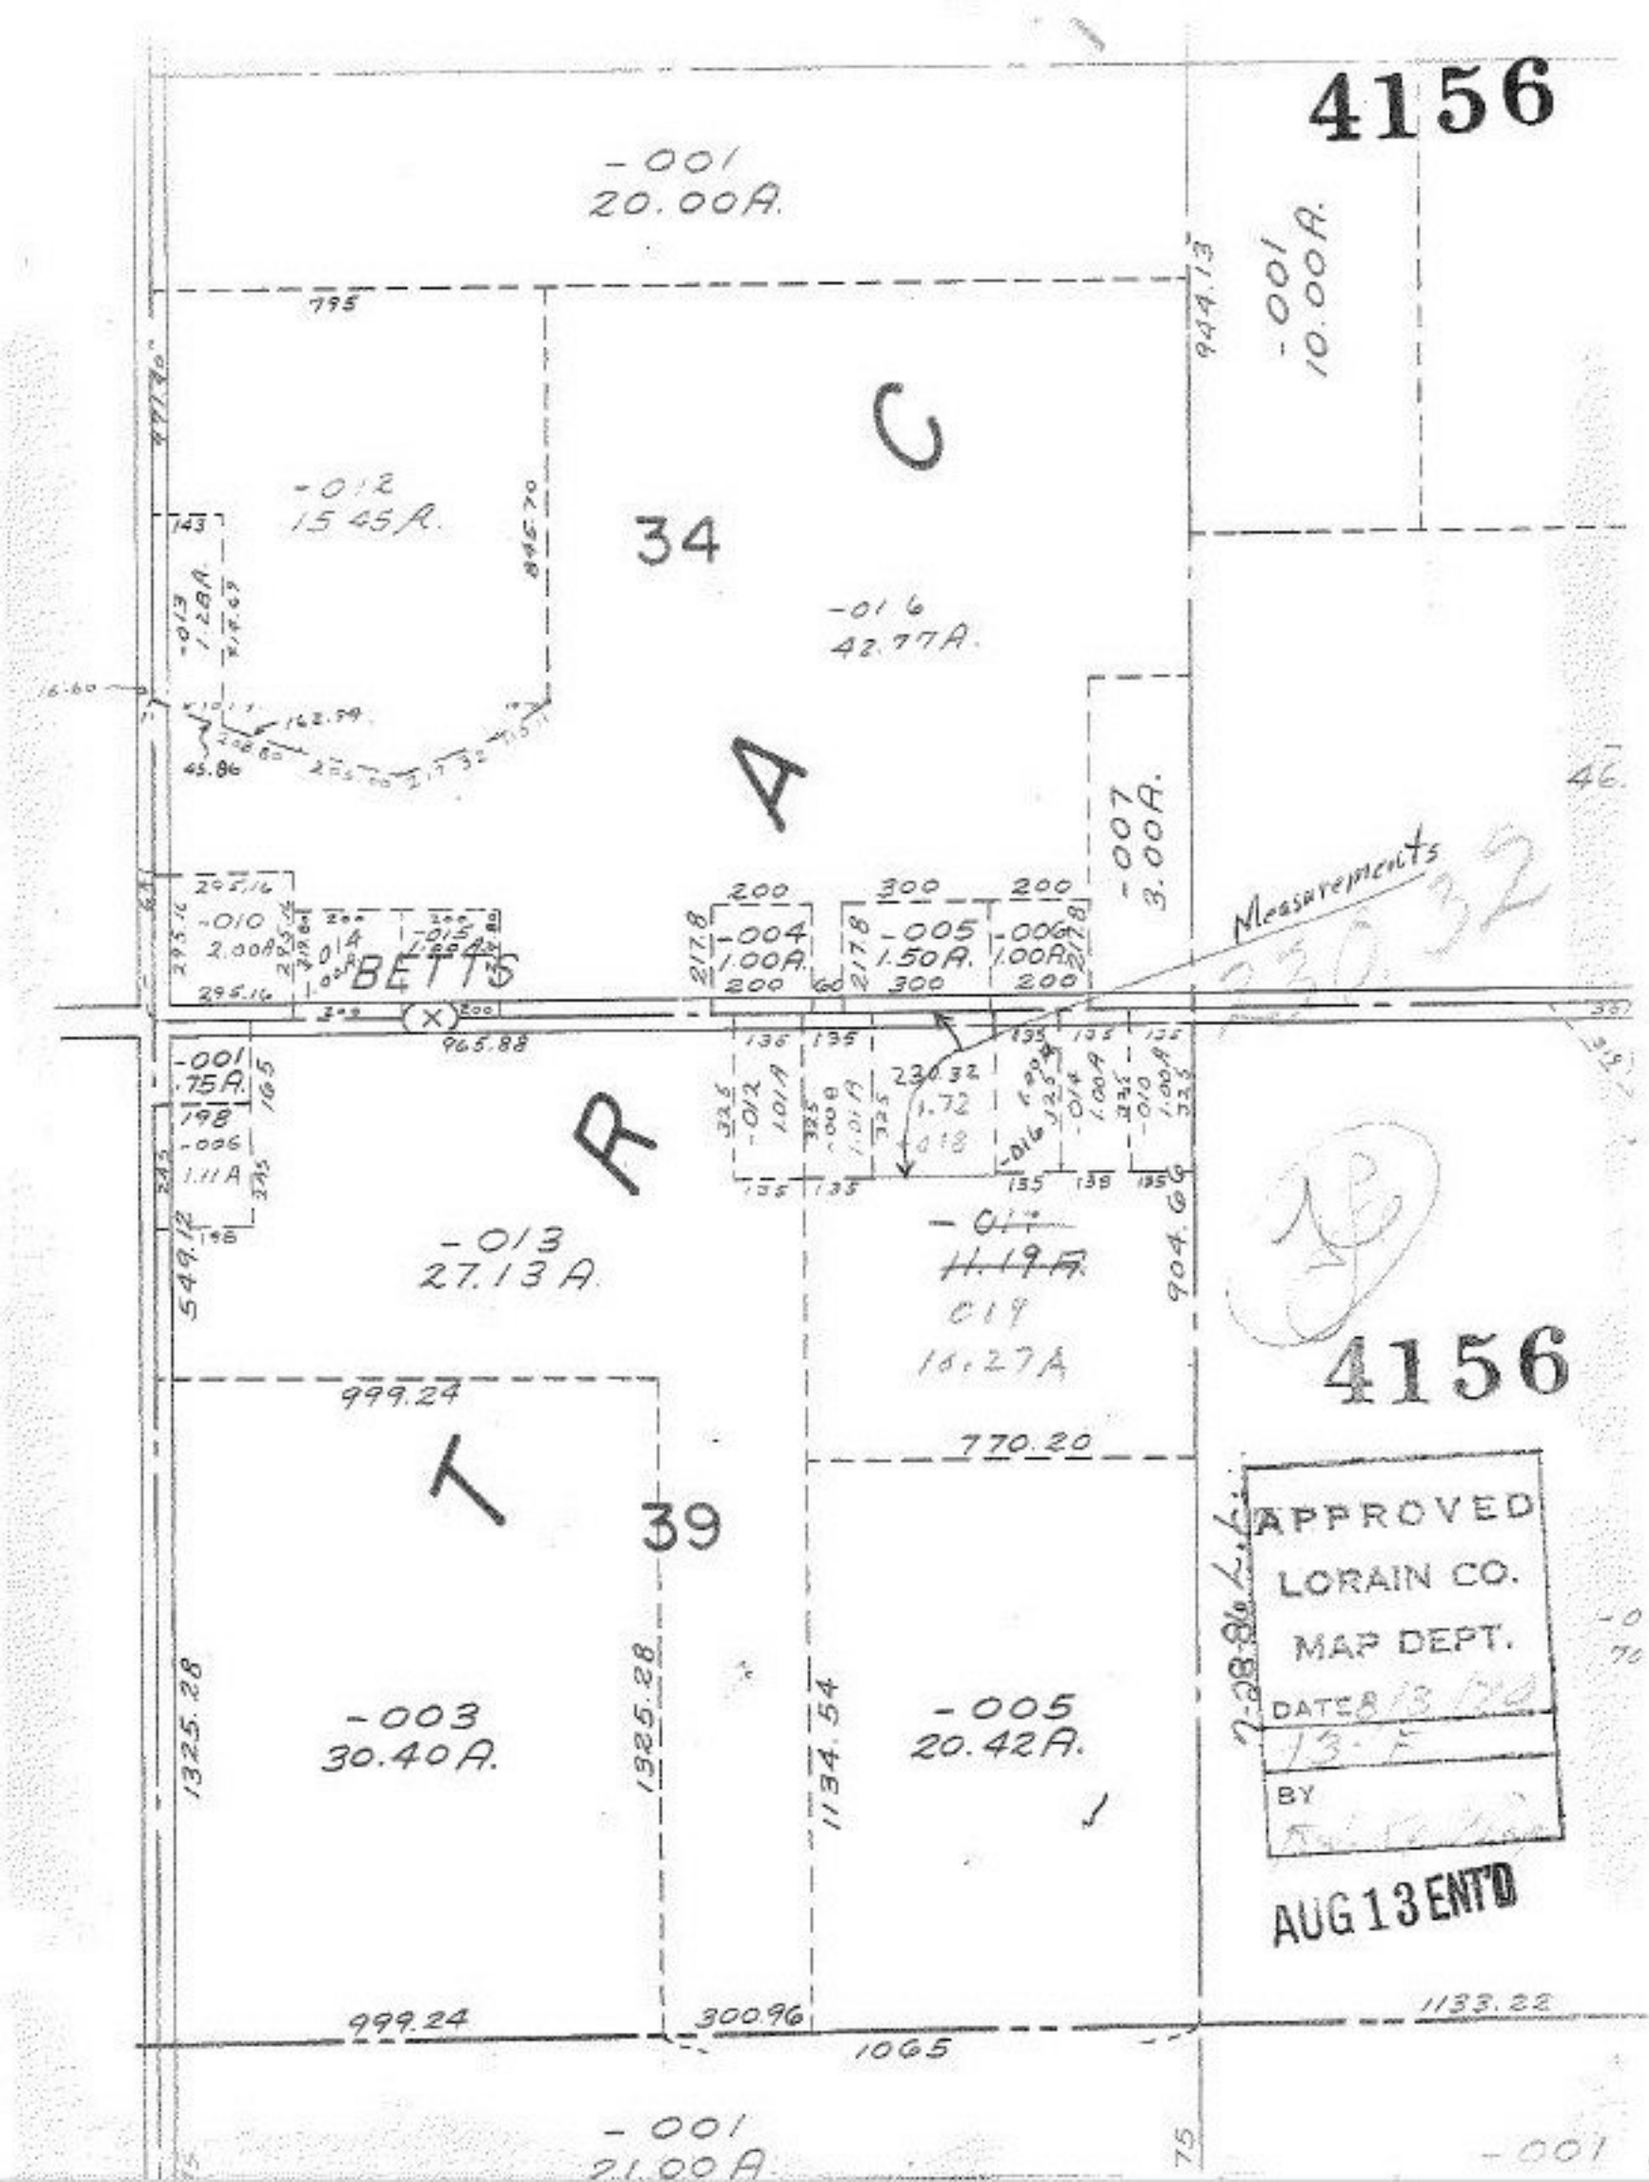
4156
-001
20.00A.
-001
10.00A.
944.13
795
C
34
-012
15.45A.
845.70
-016
42.77A.
A
-007
3.00A.
Measurements
230.32
-010
2.00A
BETTS
-004
1.00A.
-005
1.50A.
-006
1.00A.
200
300
965.88
-001
.75A.
-006
1.11A
R
-013
27.13A.
-017
11.19A.
-019
16.27A
904.66
549.12
4156
999.24
770.20
T
39
APPROVED
LORAIN CO.
MAP DEPT.
DATE
BY
AUG 13 ENT'D
-003
30.40A.
1325.28
1134.54
-005
20.42A.
999.24
300.96
1133.22
1065
-001
21.00A.
-001