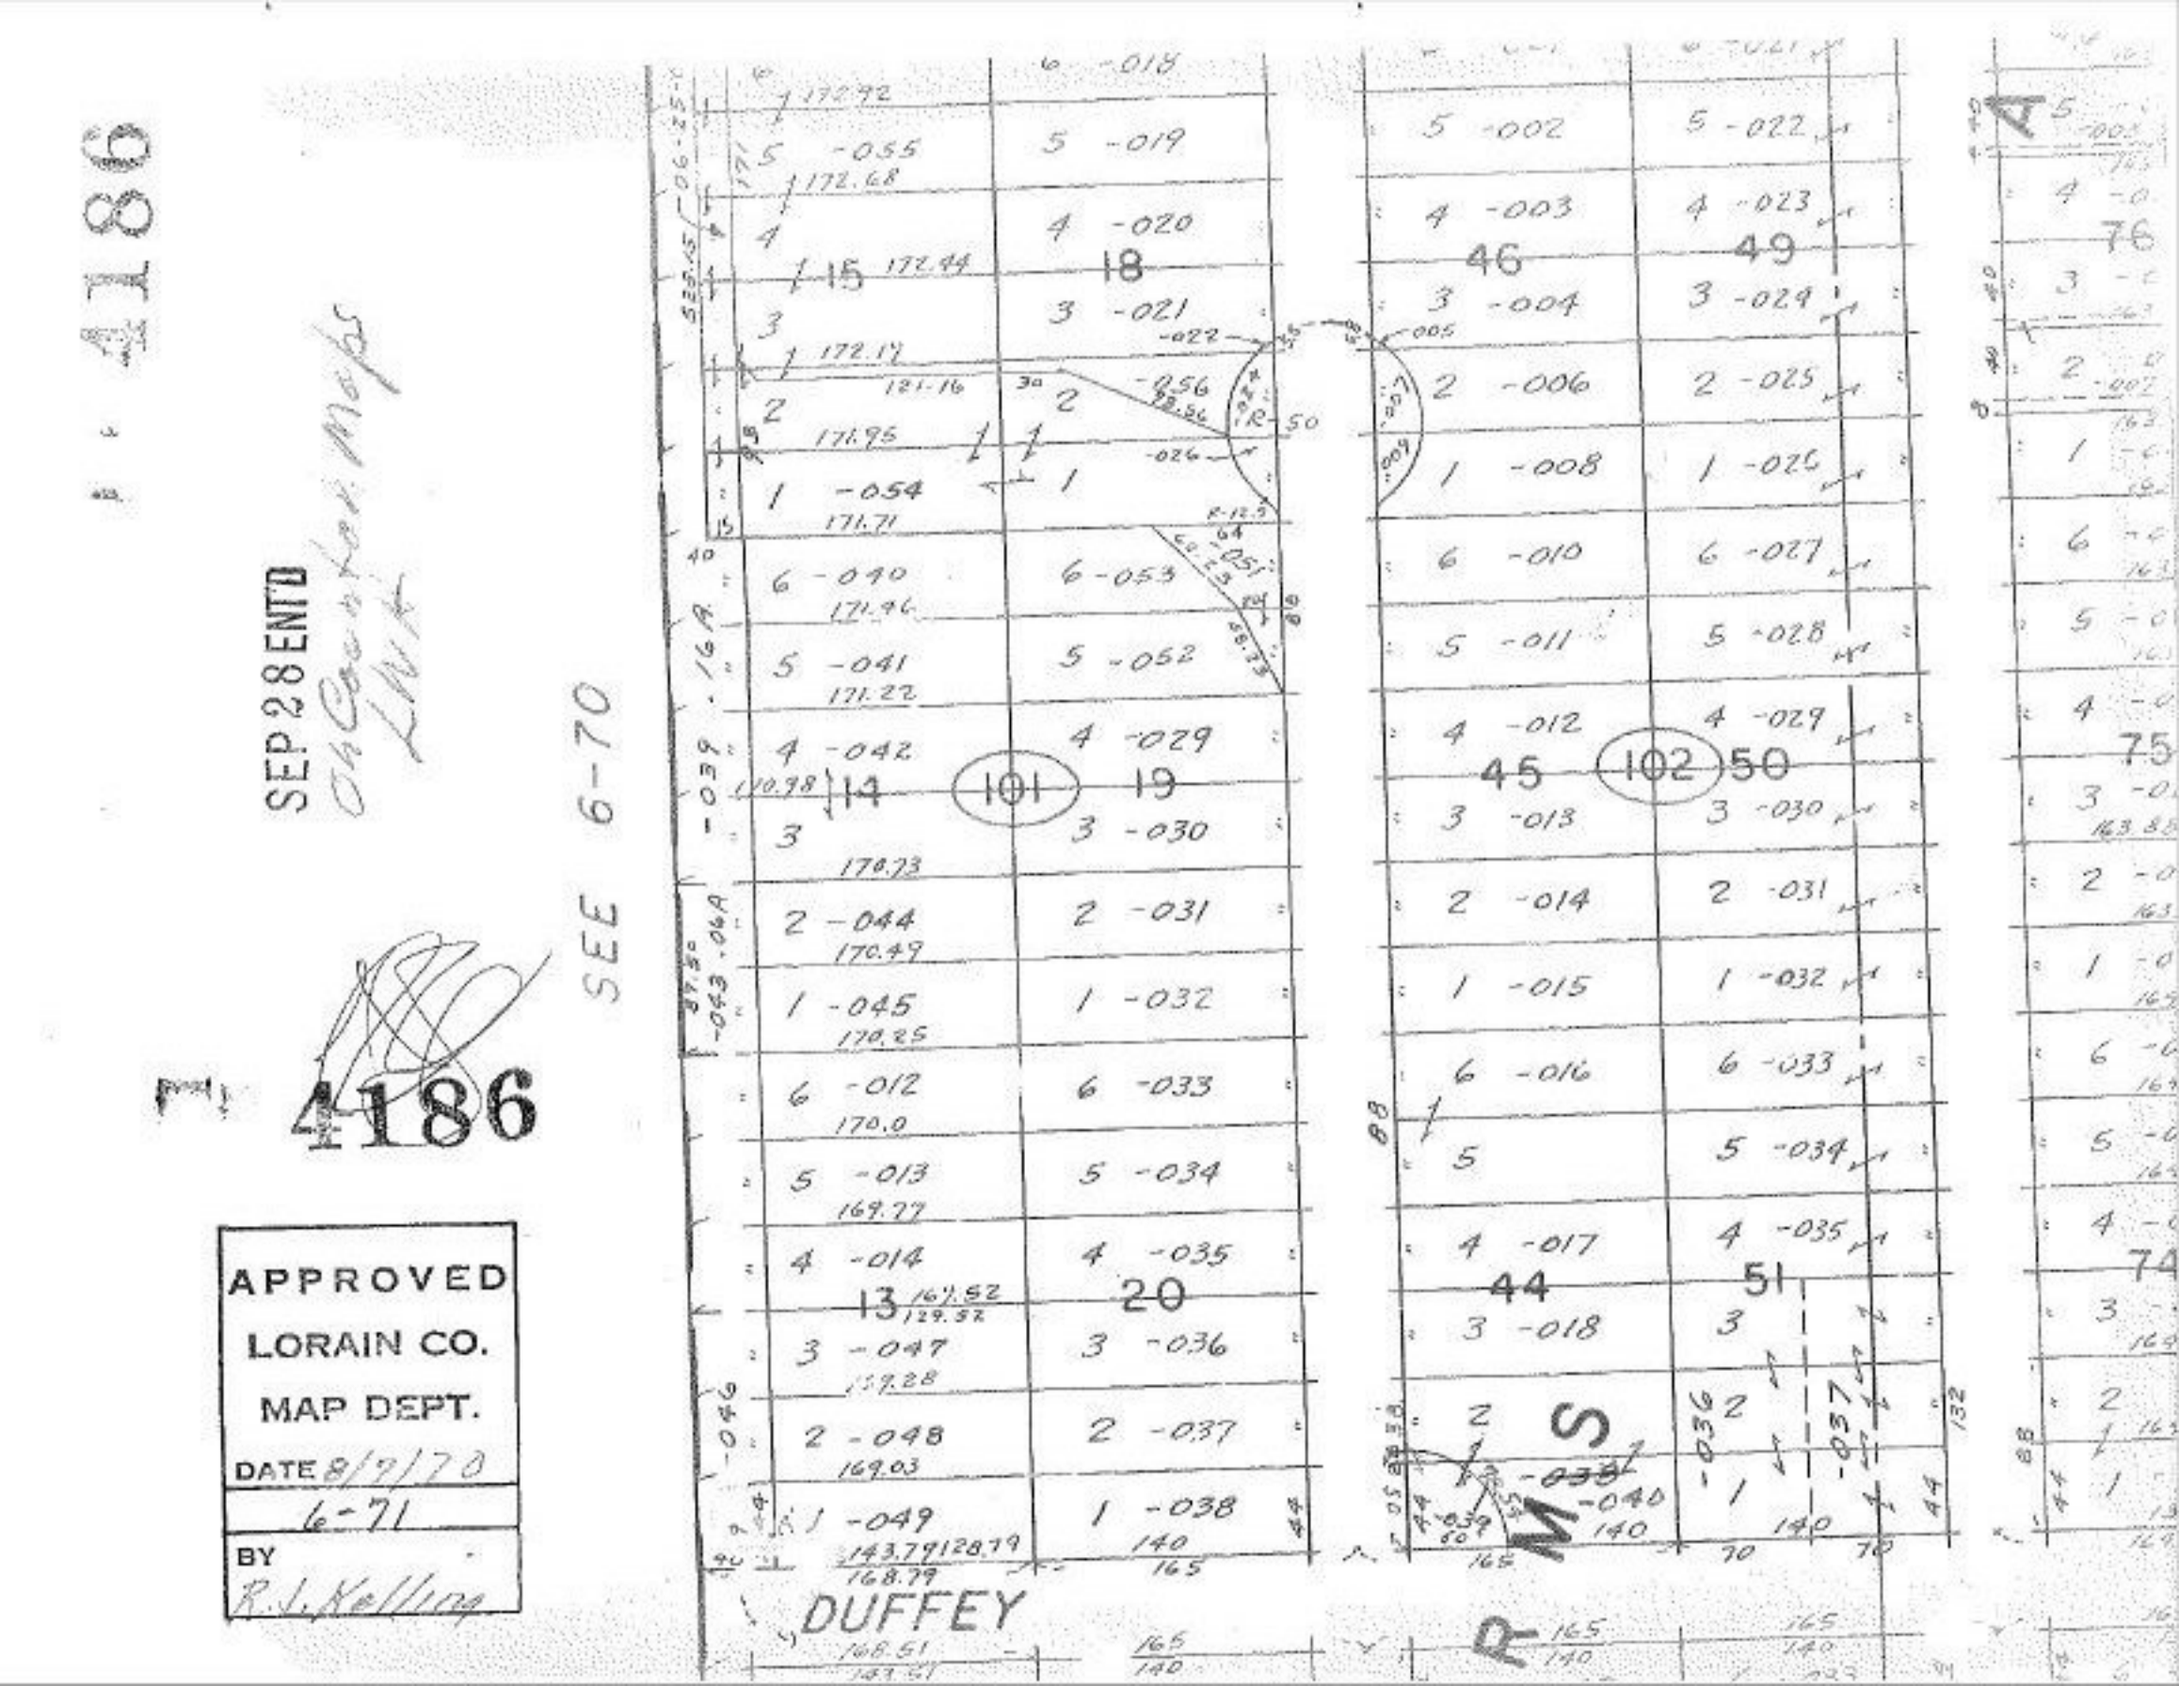
4186
SEP 28 ENTD
SEE 6-70
4186
APPROVED
LORAIN CO.
MAP DEPT.
DATE 8/9/70
6-71
BY
R. J. Kelley
DUFFEY
101
102
18
19
20
45
46
49
50
51
44
14
13
15
12
16
17
S
R