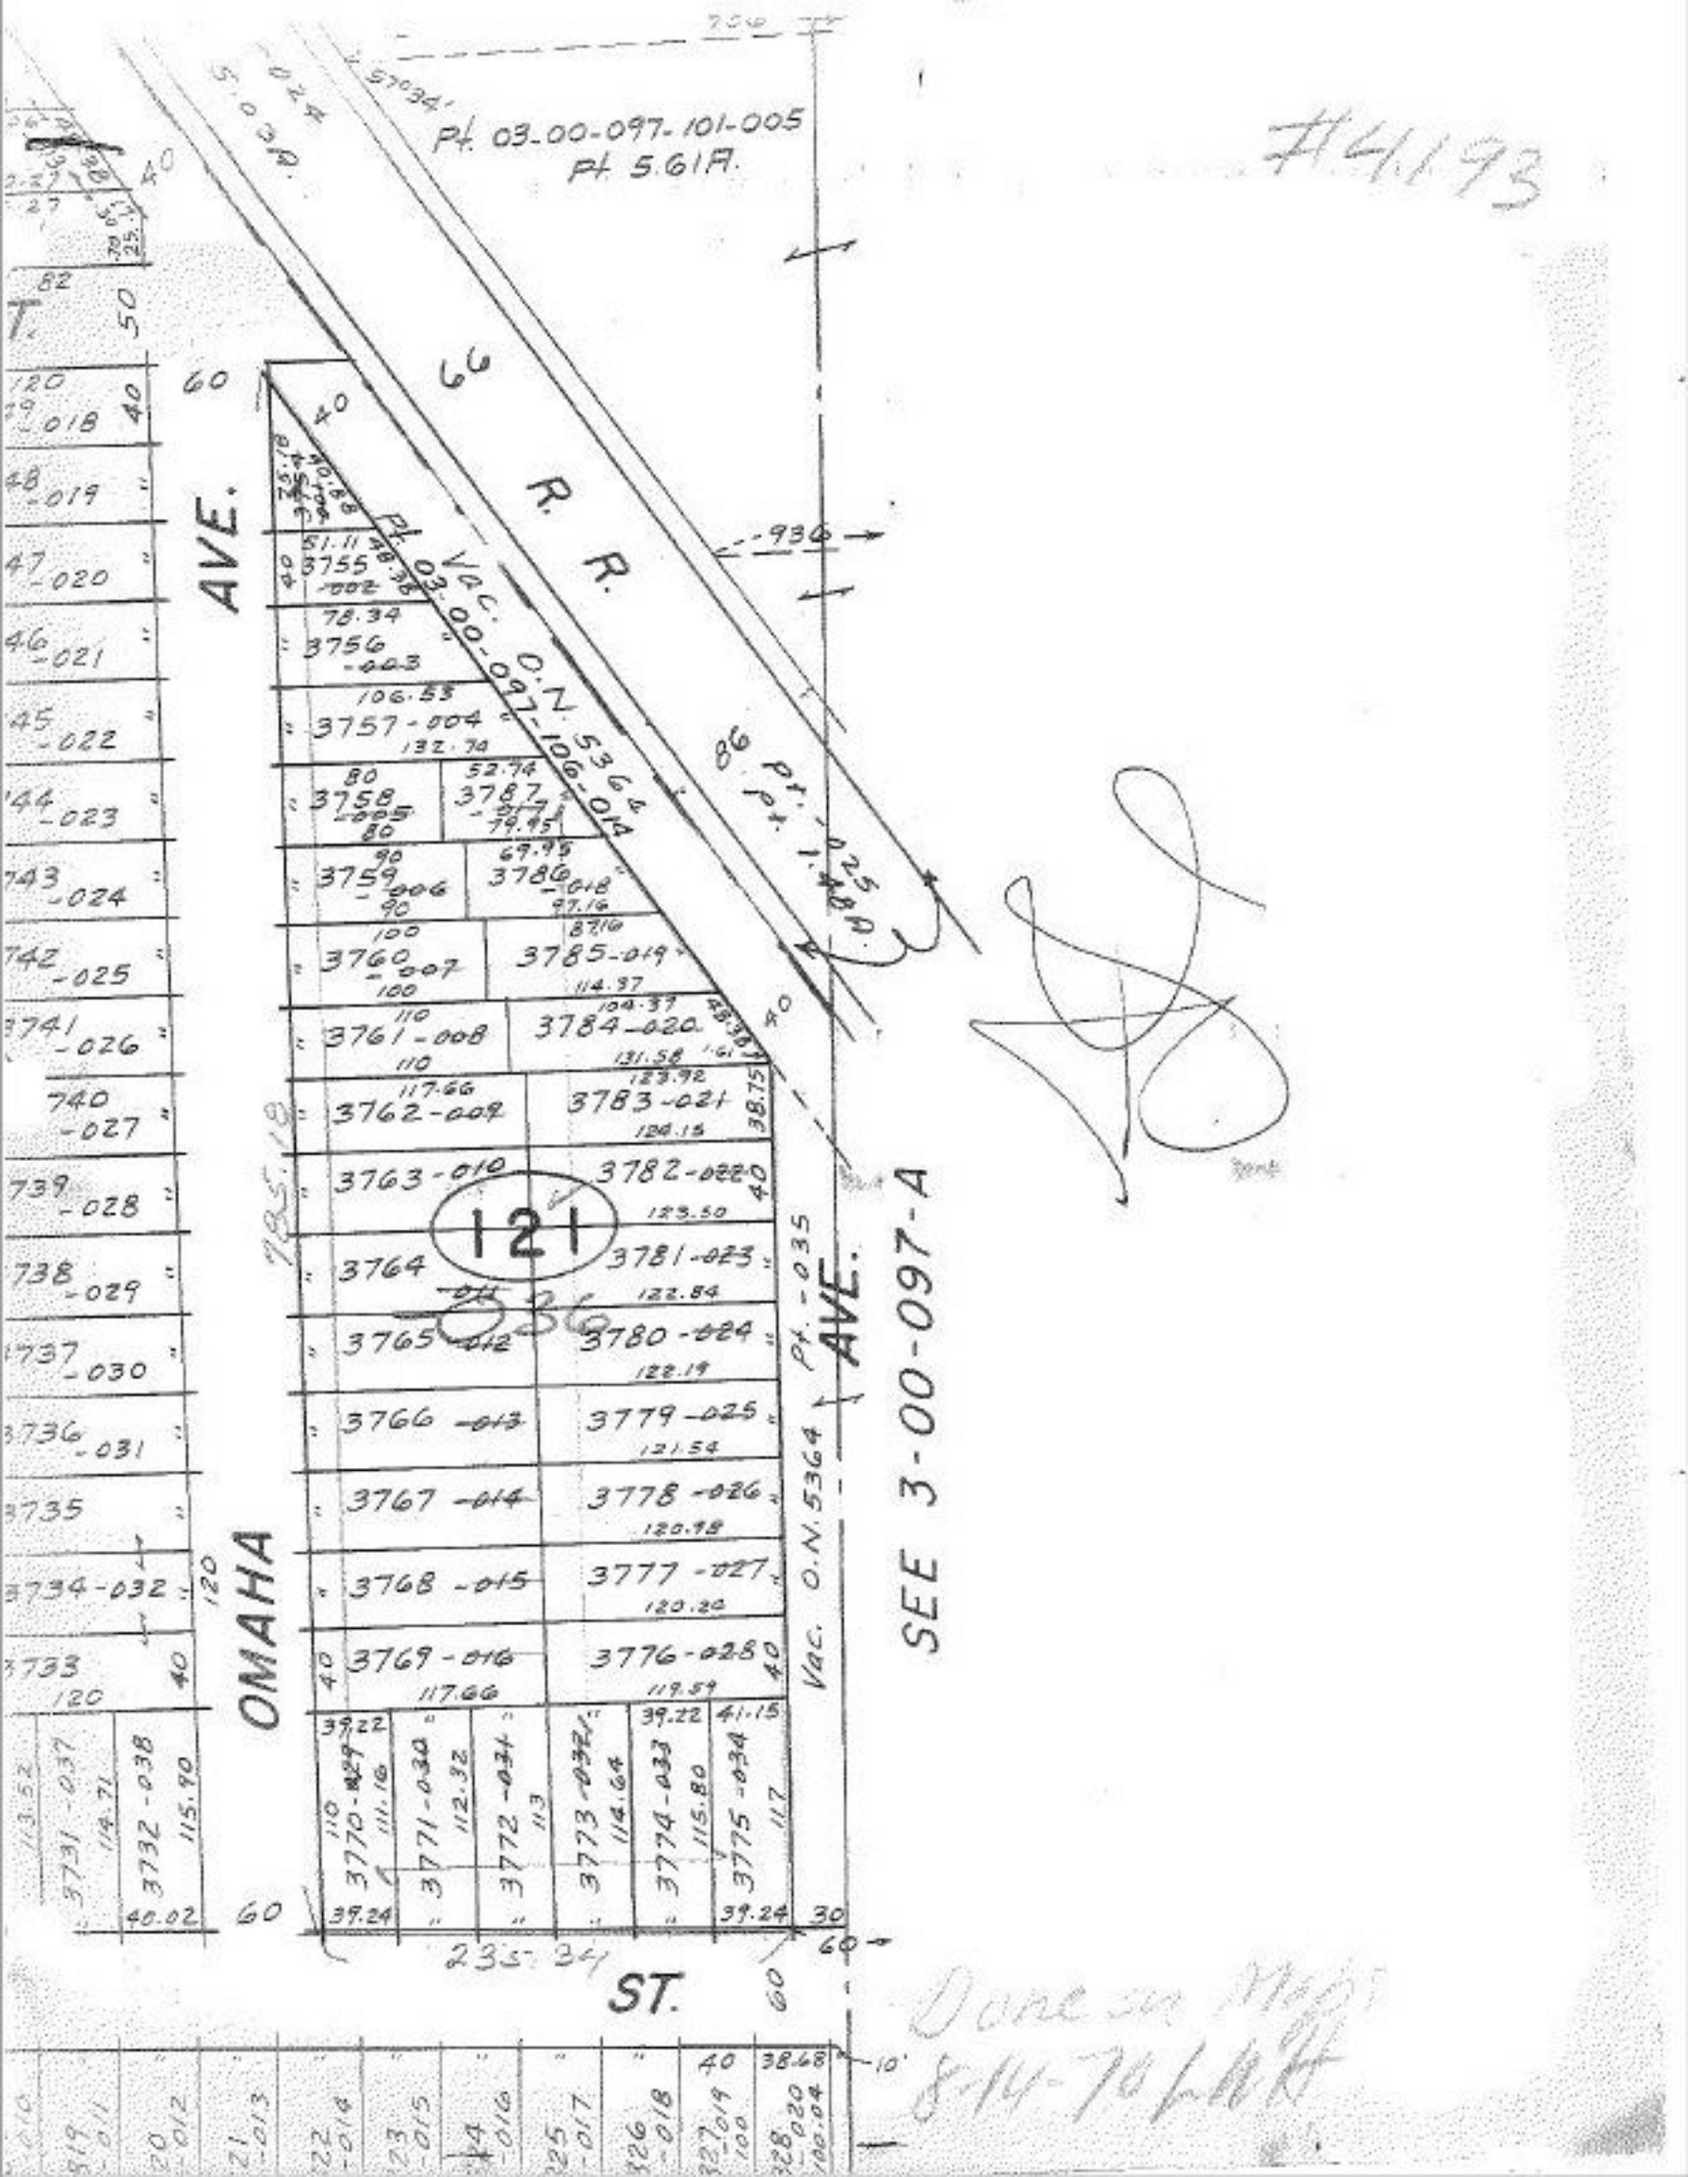
#4193
Pt. 03-00-097-101-005
Pt. 5.61A.
R. R.
AVE.
OMAHA
ST.
Vac. O.N. 5364
Pt. 03-00-097-106-014
Pt. -025
Pt. 1.48A.
Pt. -035
Vac. O.N. 5364
121
SEE 3-00-097-A
Done on Map
8-14-70