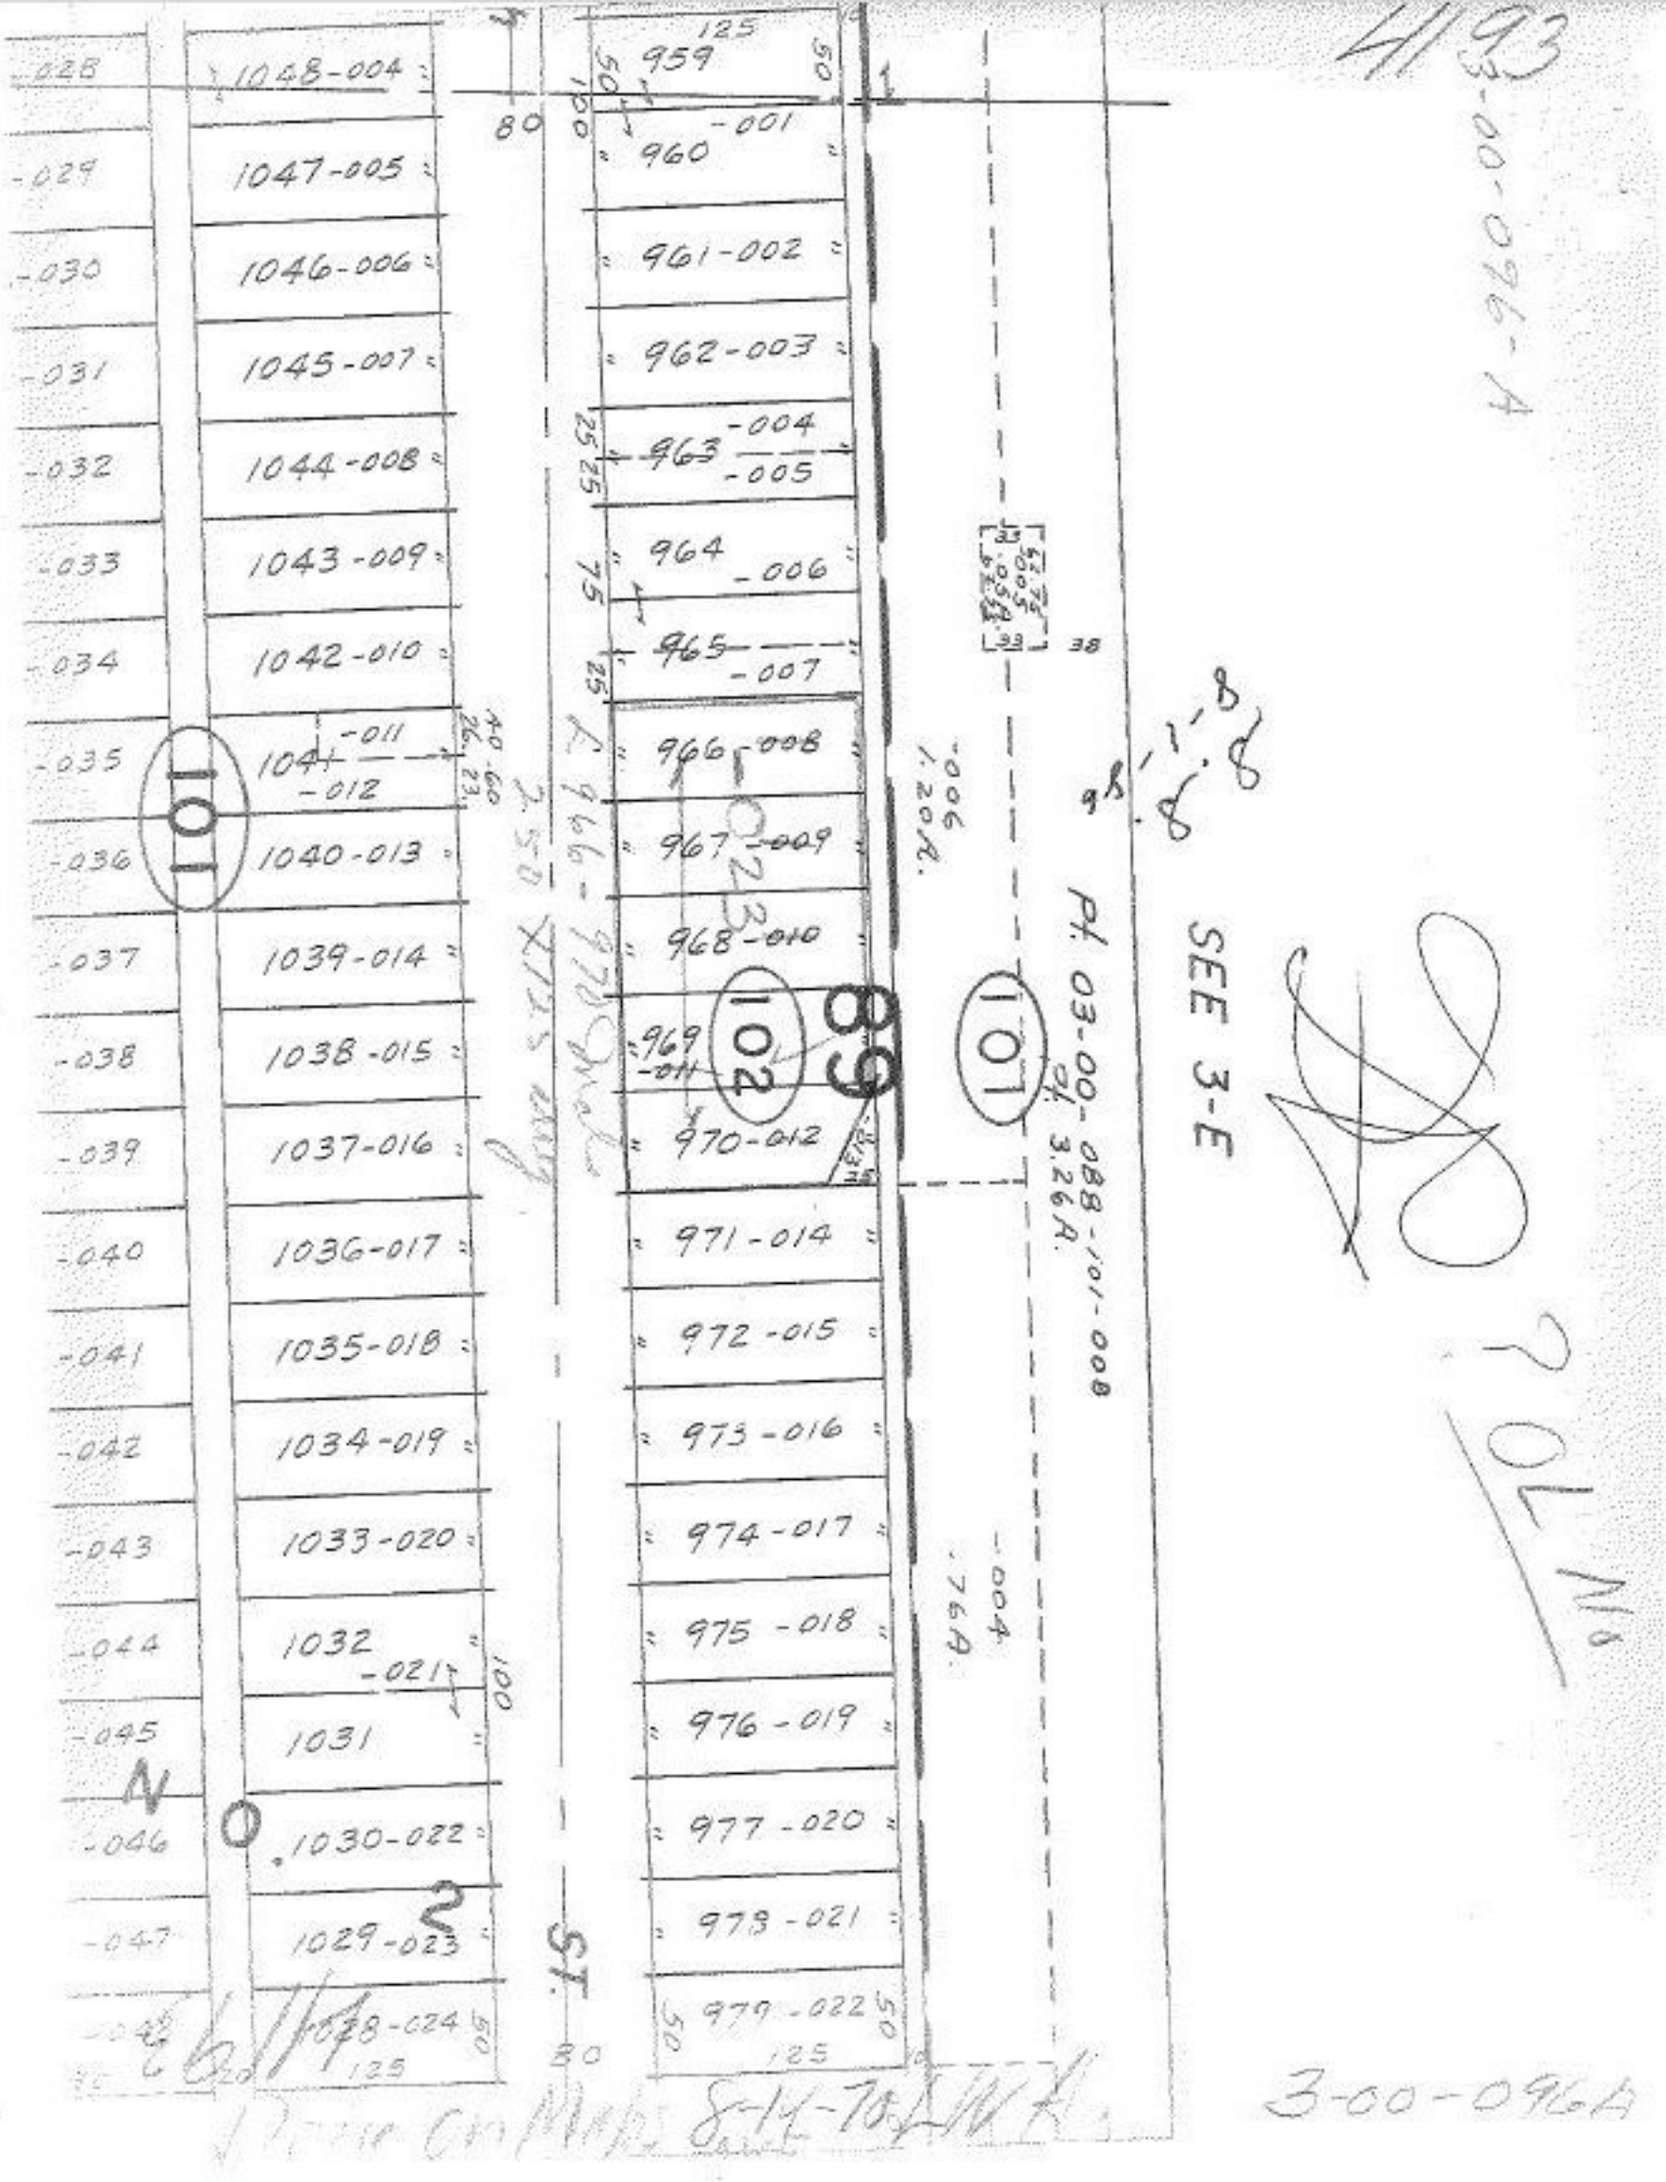
1048-004
1047-005
1046-006
1045-007
1044-008
1043-009
1042-010
1041-011
-012
1040-013
1039-014
1038-015
1037-016
1036-017
1035-018
1034-019
1033-020
1032-021
1031
1030-022
1029-023
1028-024
959
960 -001
961-002
962-003
963 -004
-005
964 -006
965 -007
966 -008
967 -009
968 -010
969 -011
970-012
971-014
972-015
973-016
974-017
975-018
976-019
977-020
978-021
979-022
101
102
SEE 3-E
Pt. 03-00-088-101-008
3.26A.
-004
.76A.
-006
1.20A.
ST.