


304A

101

1196

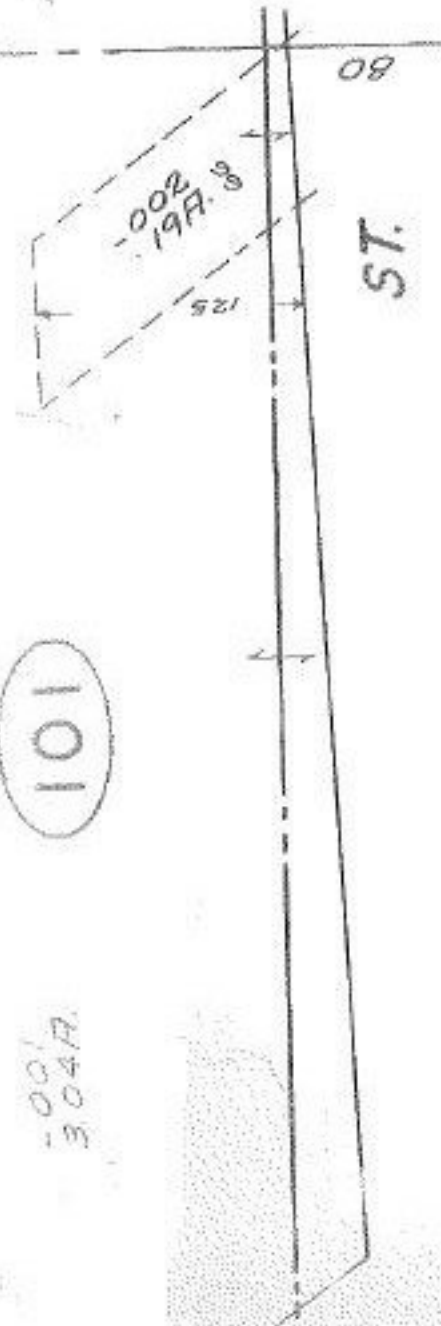

105

112

3.2 AC

3706	0	68.64
3707	0	3753
3708	0	95.85
3709	0	85.85
3710	0	3752
3711	0	113.06
3712	0	193.06
3713	0	3751
3714	0	120.27
3715	0	110.27
3716	0	3751
3717	0	120
3718	0	120

ST. 50

3719	0	120
3720	0	3749
3721	0	118
3722	0	3748
3723	0	120
3724	0	3747
3725	0	120
3726	0	3746
3727	0	120
3728	0	3745


PT. 5.02A
PT. 5.03A

PT. 03.00-097-101-005
PT. 5.61A

SEP 3-00-097A

For 7415 Part

7-17-86 S.S.

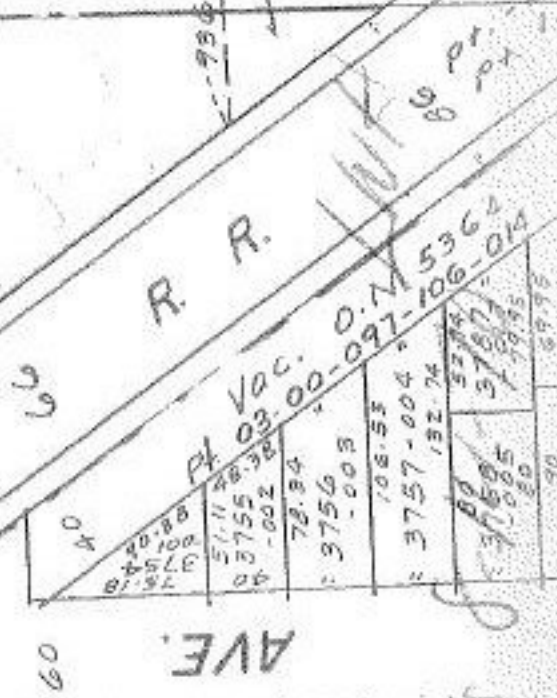

3719-3728

3-00-097B