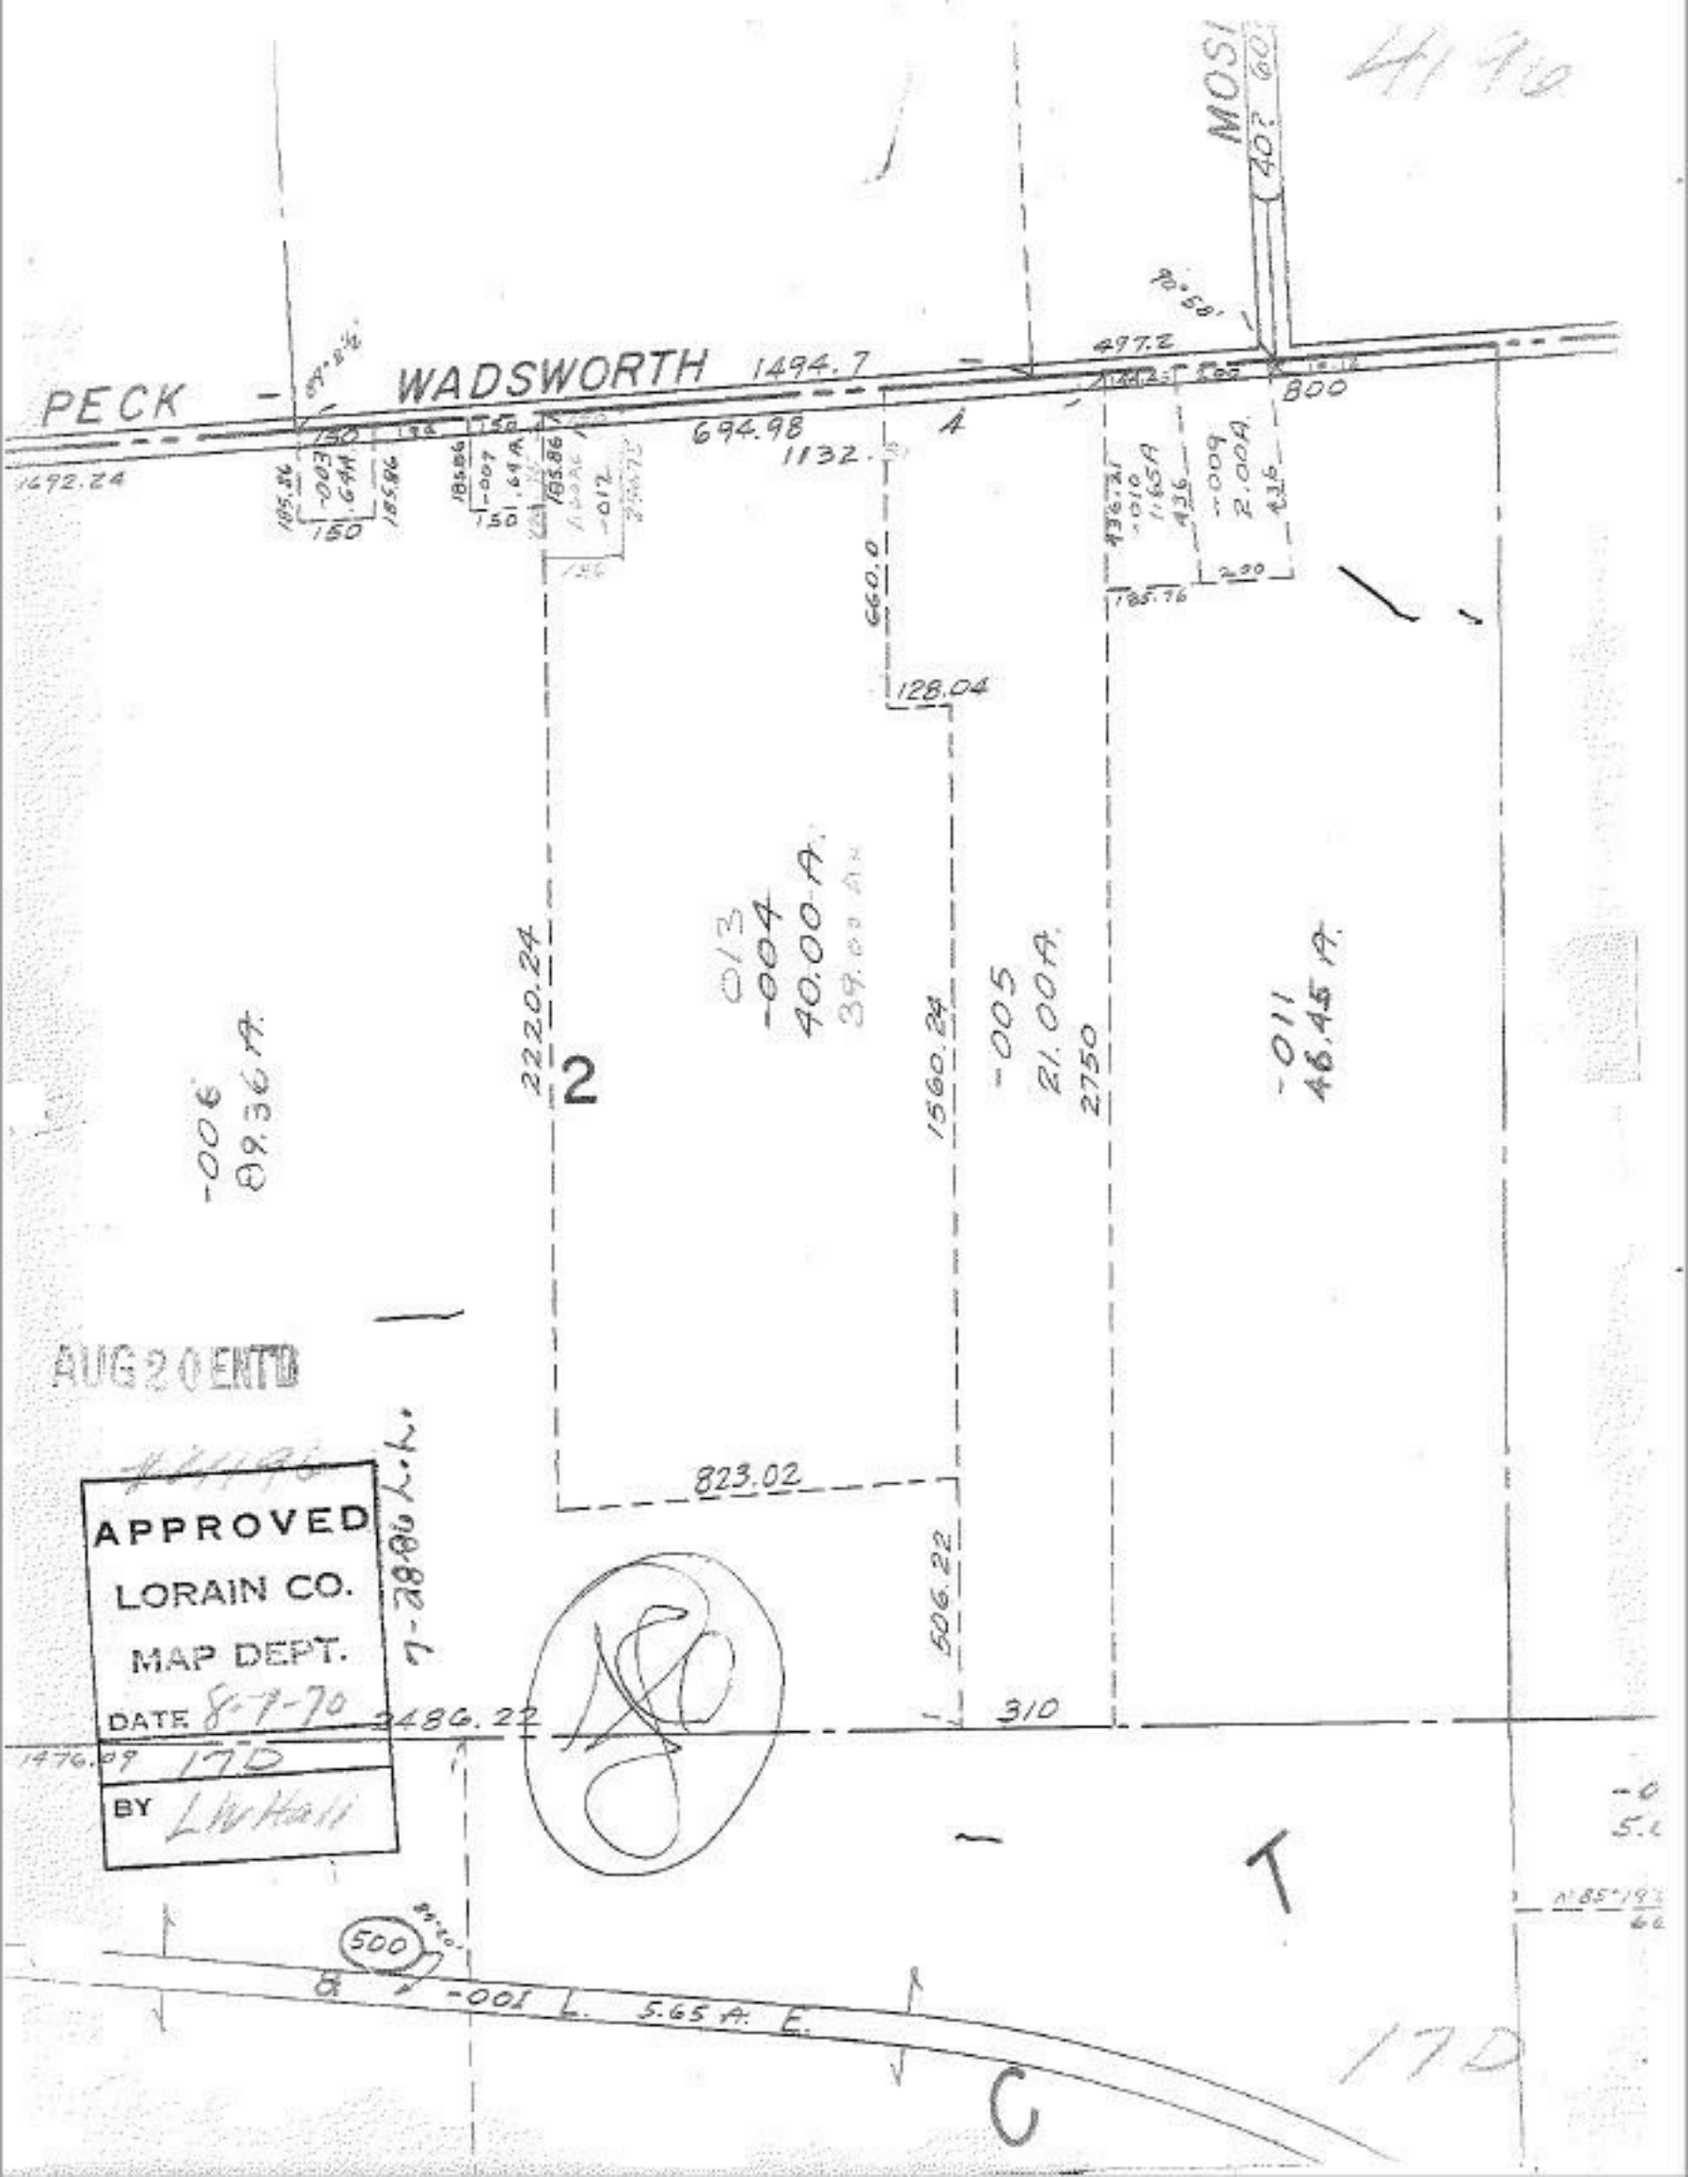

AUG 20 ENTD

APPROVED
LORAIN CO.
MAP DEPT.
DATE 8-7-70
17D
BY LWHall