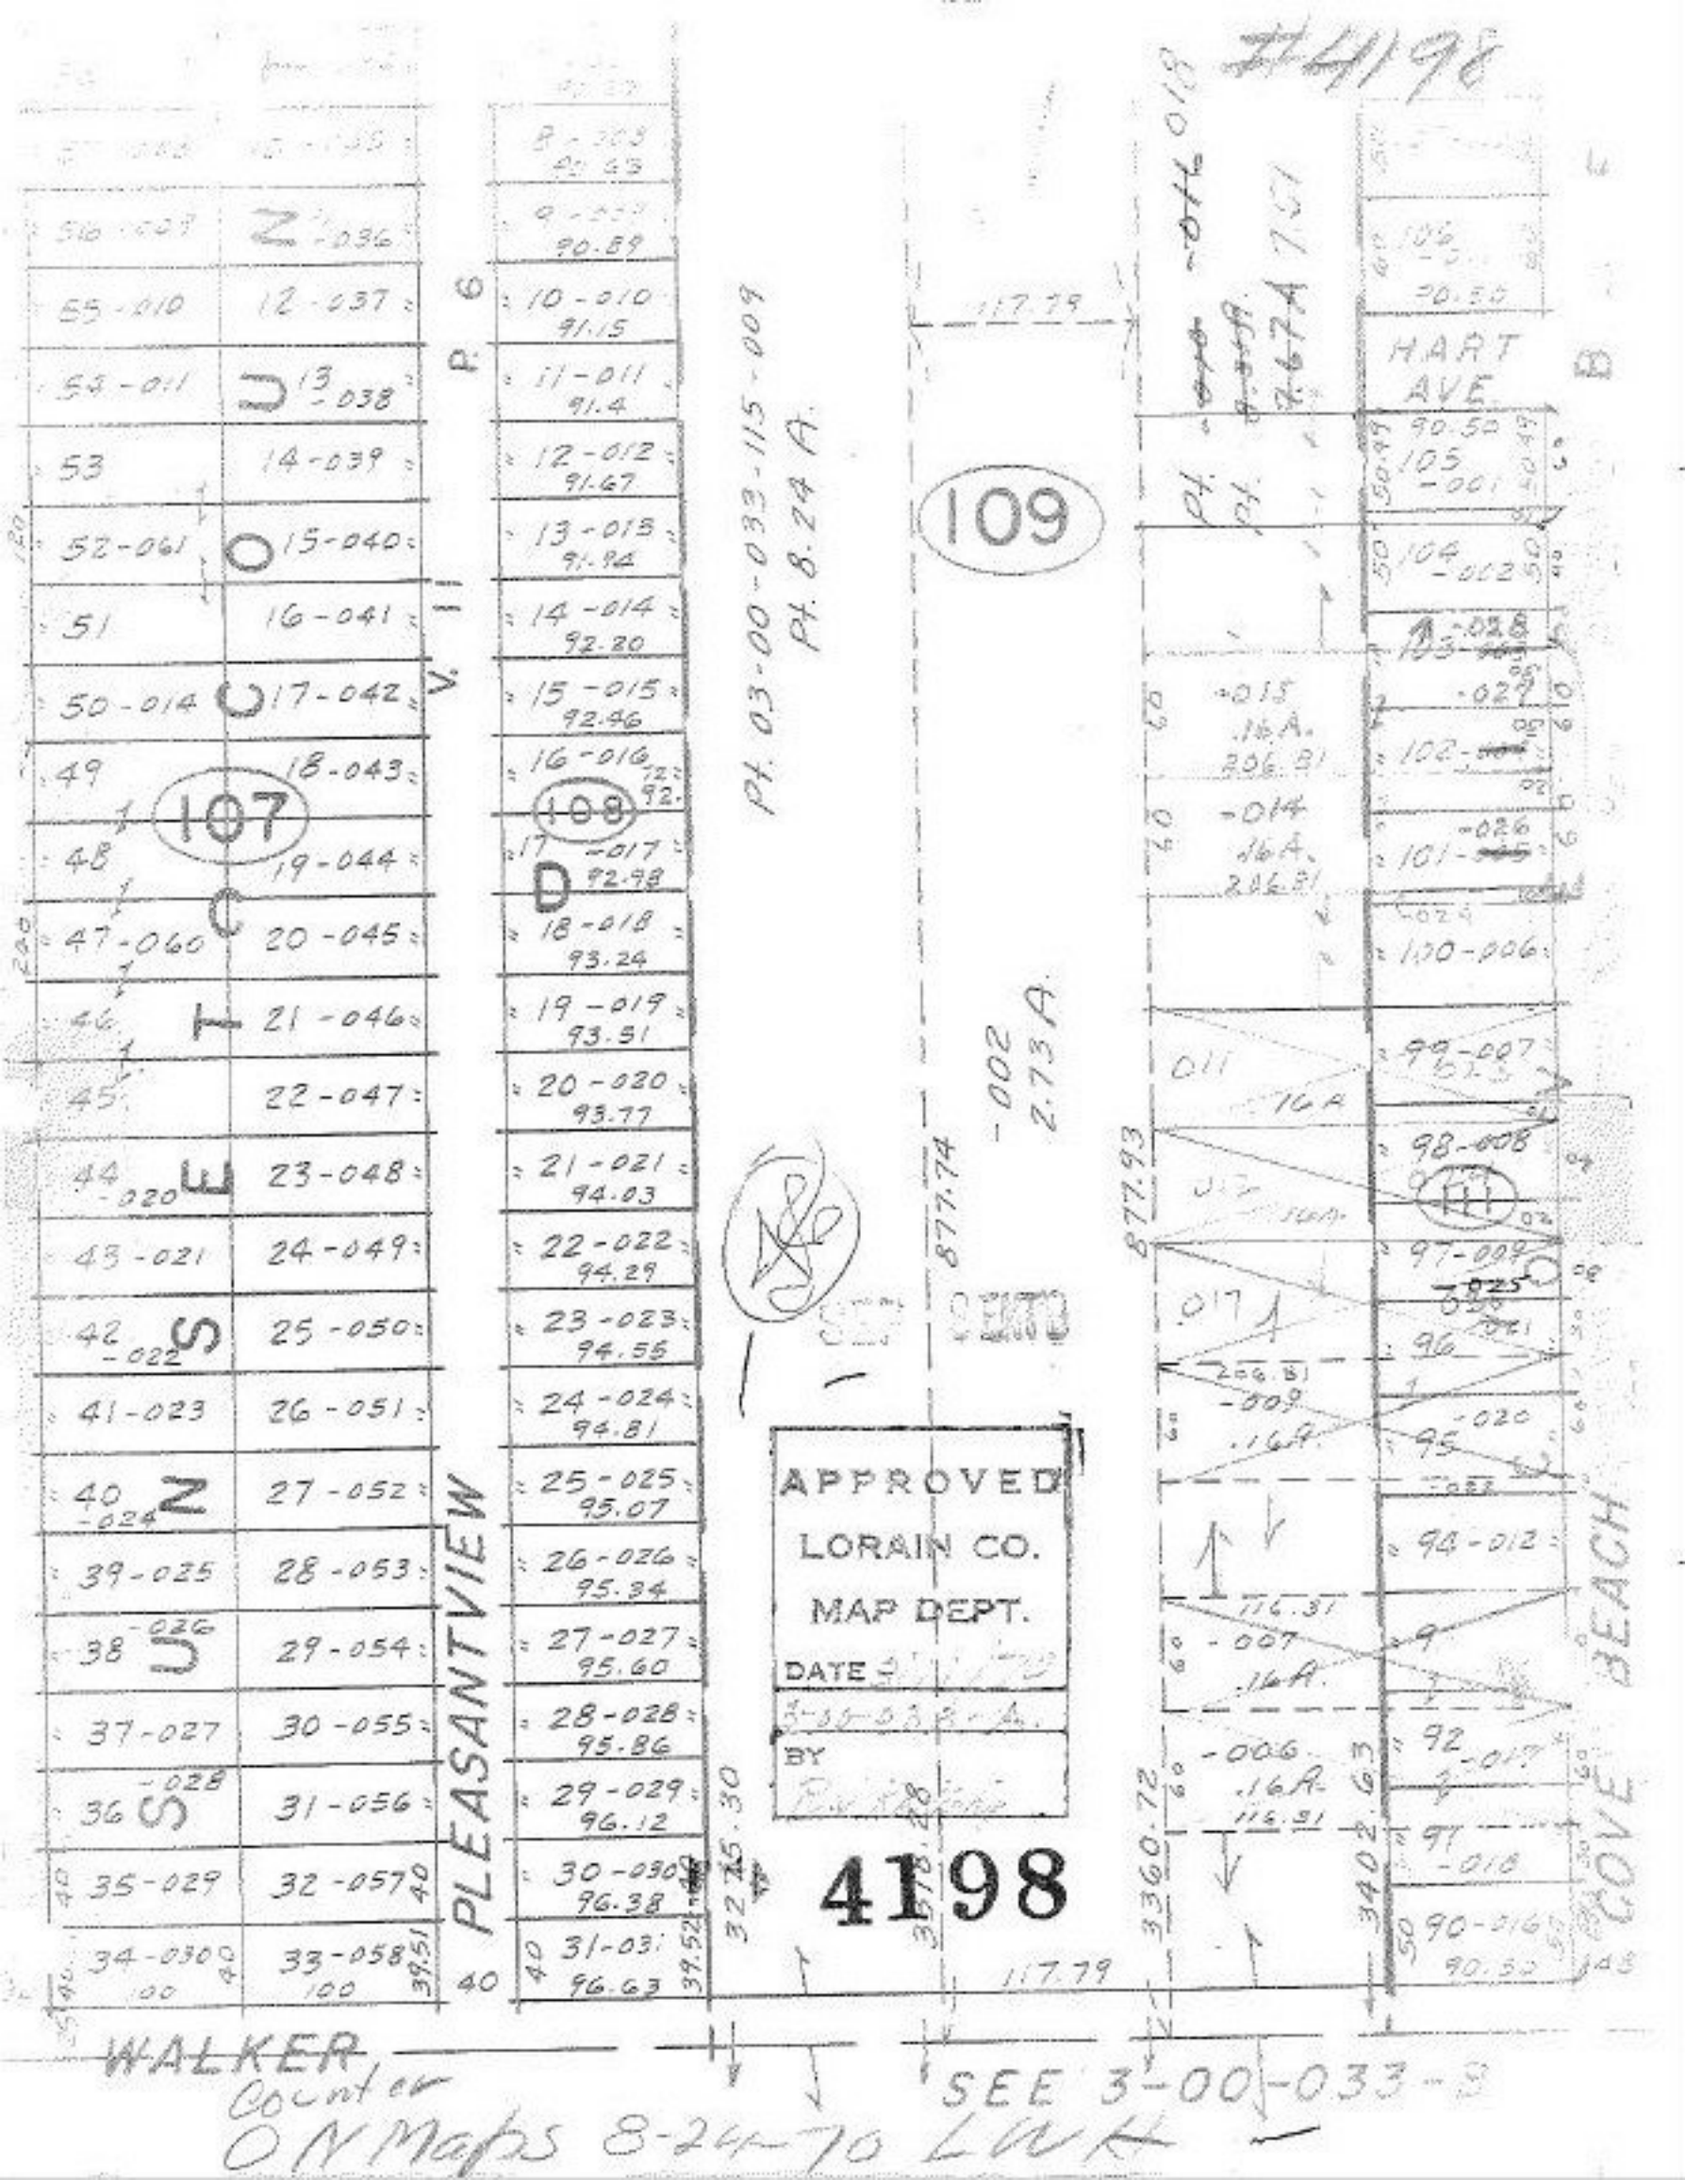
4198
PLEASANTVIEW
COVE BEACH
HART AVE.
109
107
108
APPROVED
LORAIN CO.
MAP DEPT.
DATE
BY
4198
WALKER
Counter
SEE 3-00-033-S
ON Maps 8-24-70 LWH