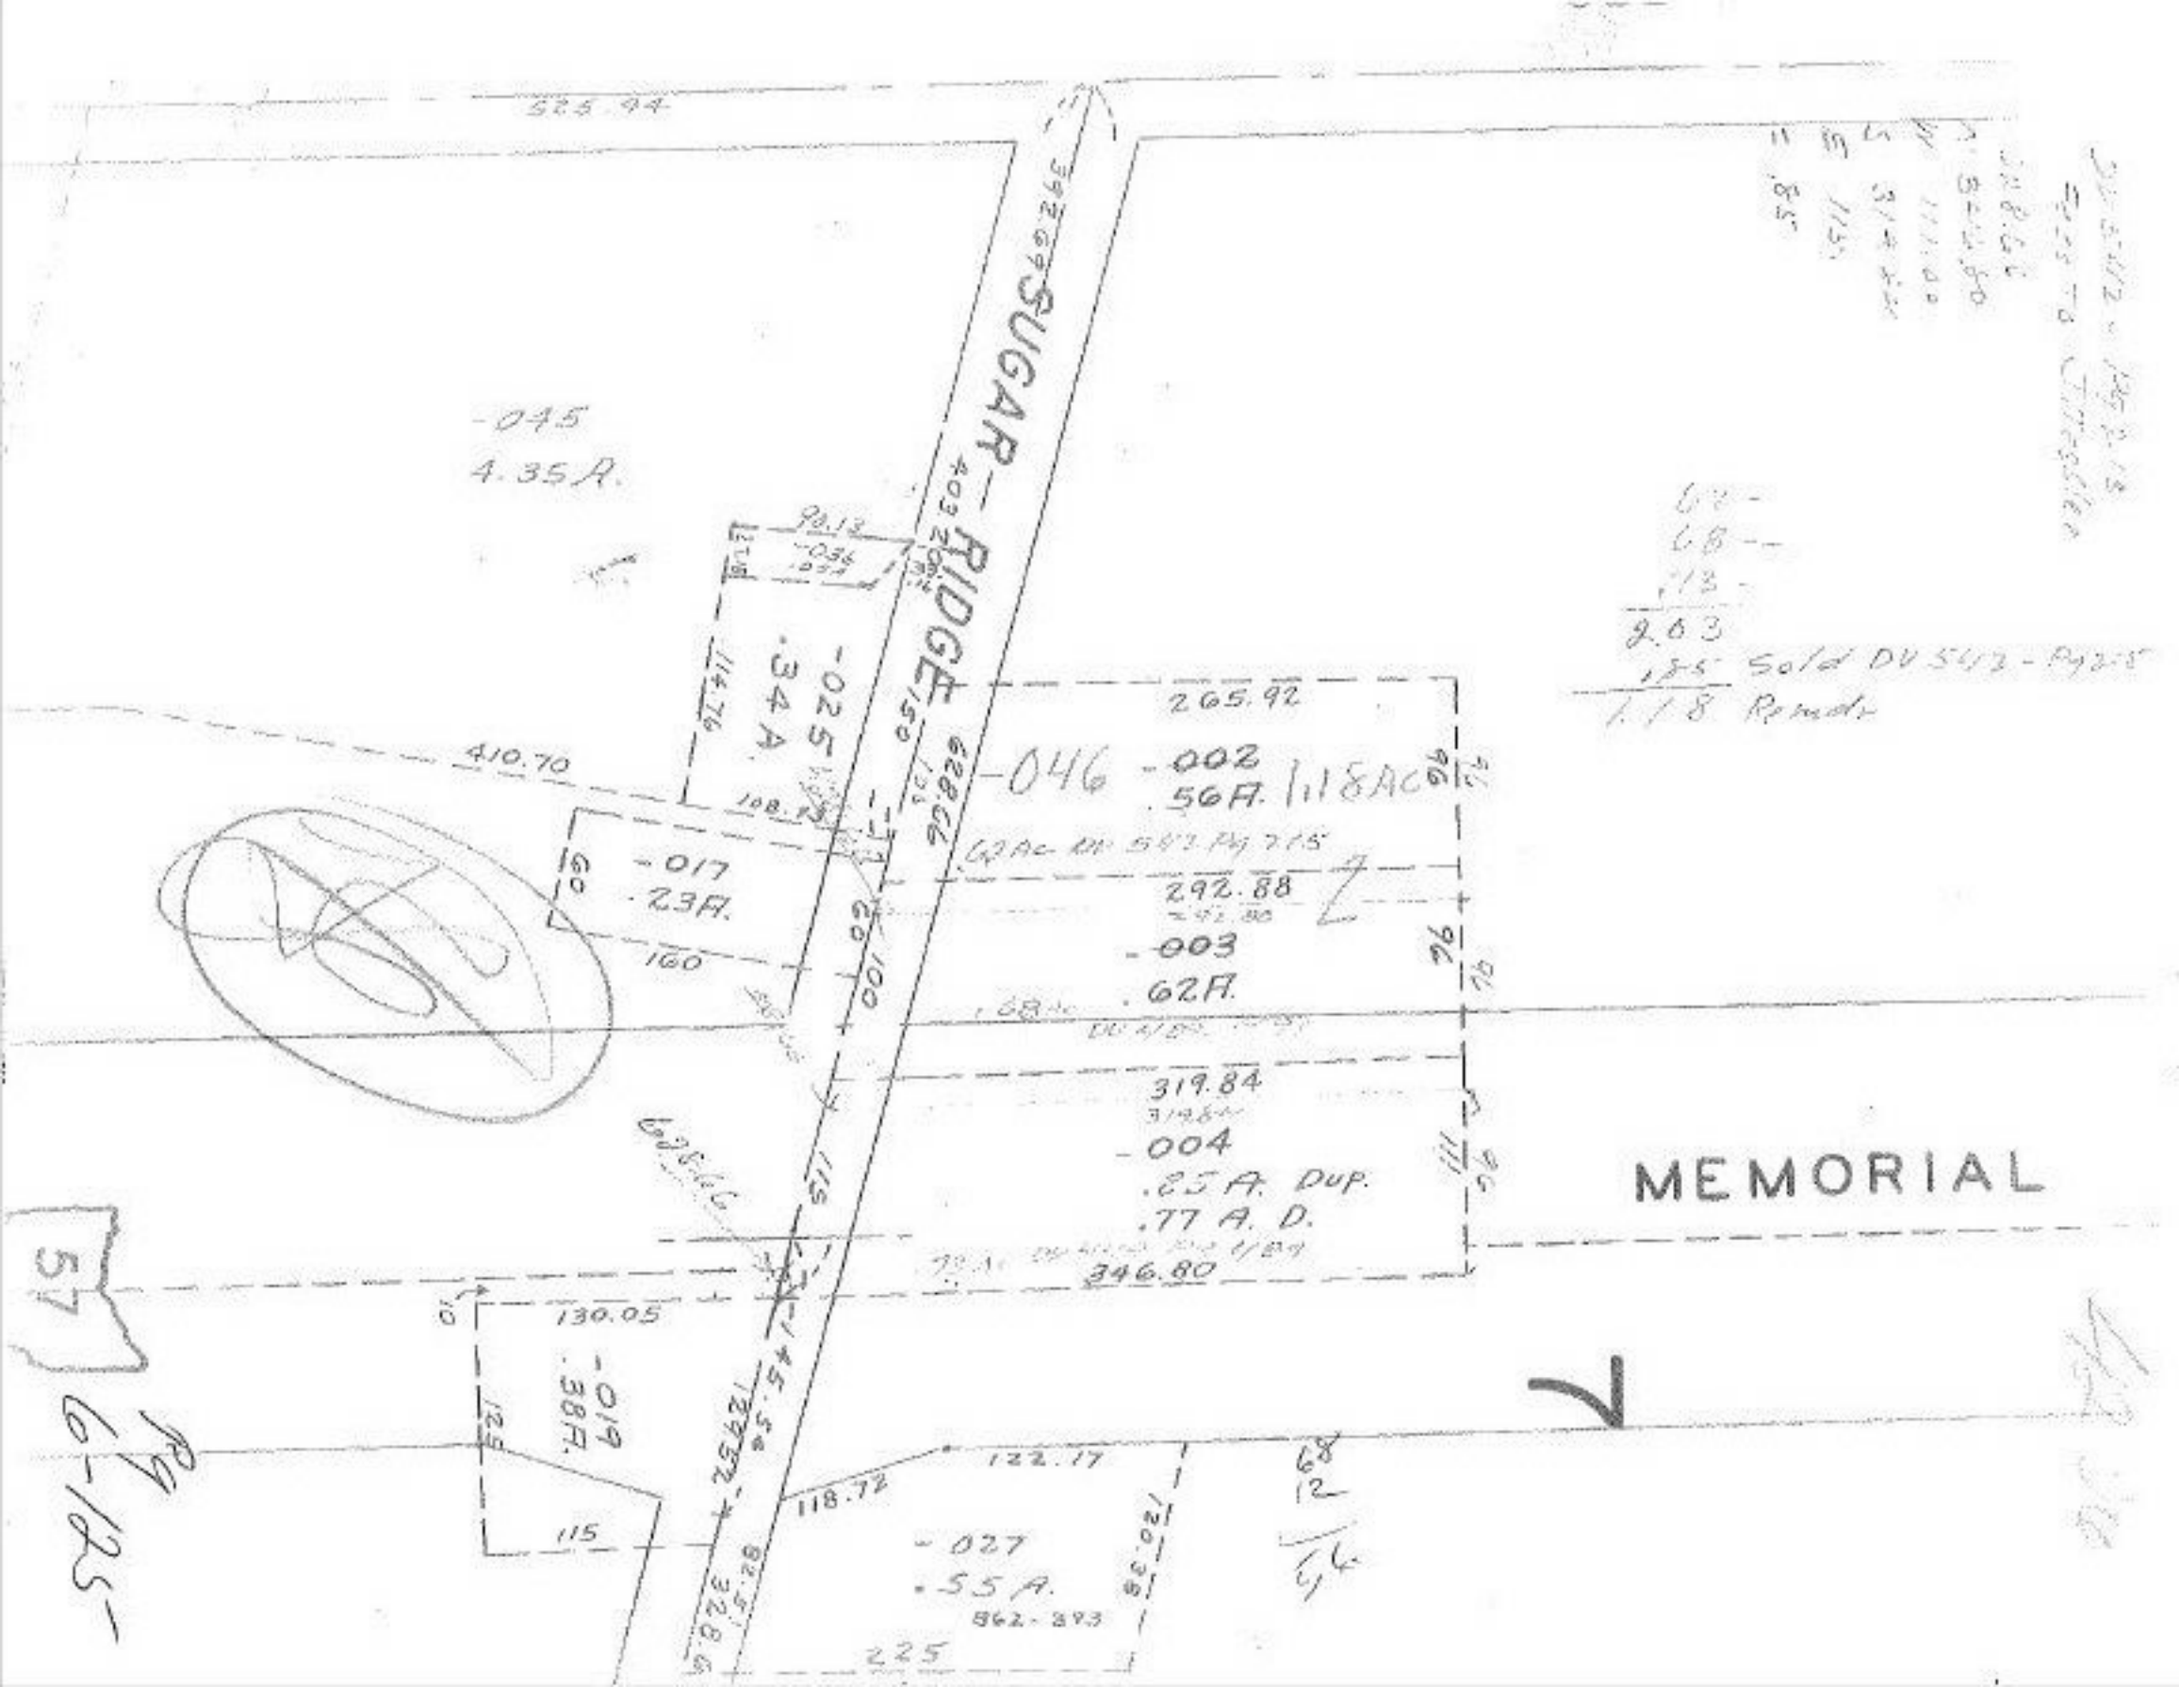
525.94
SUGAR RIDGE
-045
4.35A.
-025
.34A.
-017
.23A.
-046
-002
.56A. 1.18AC
-003
.62A.
-004
.85A. DUP.
.77 A. D.
MEMORIAL
-027
.55A.
-019
.38A.
410.70
265.92
292.88
319.84
346.80
130.05
122.17
118.72
225
160
115
2.03
.15 Sold DV 542 - Pg 215
1.18 Remain