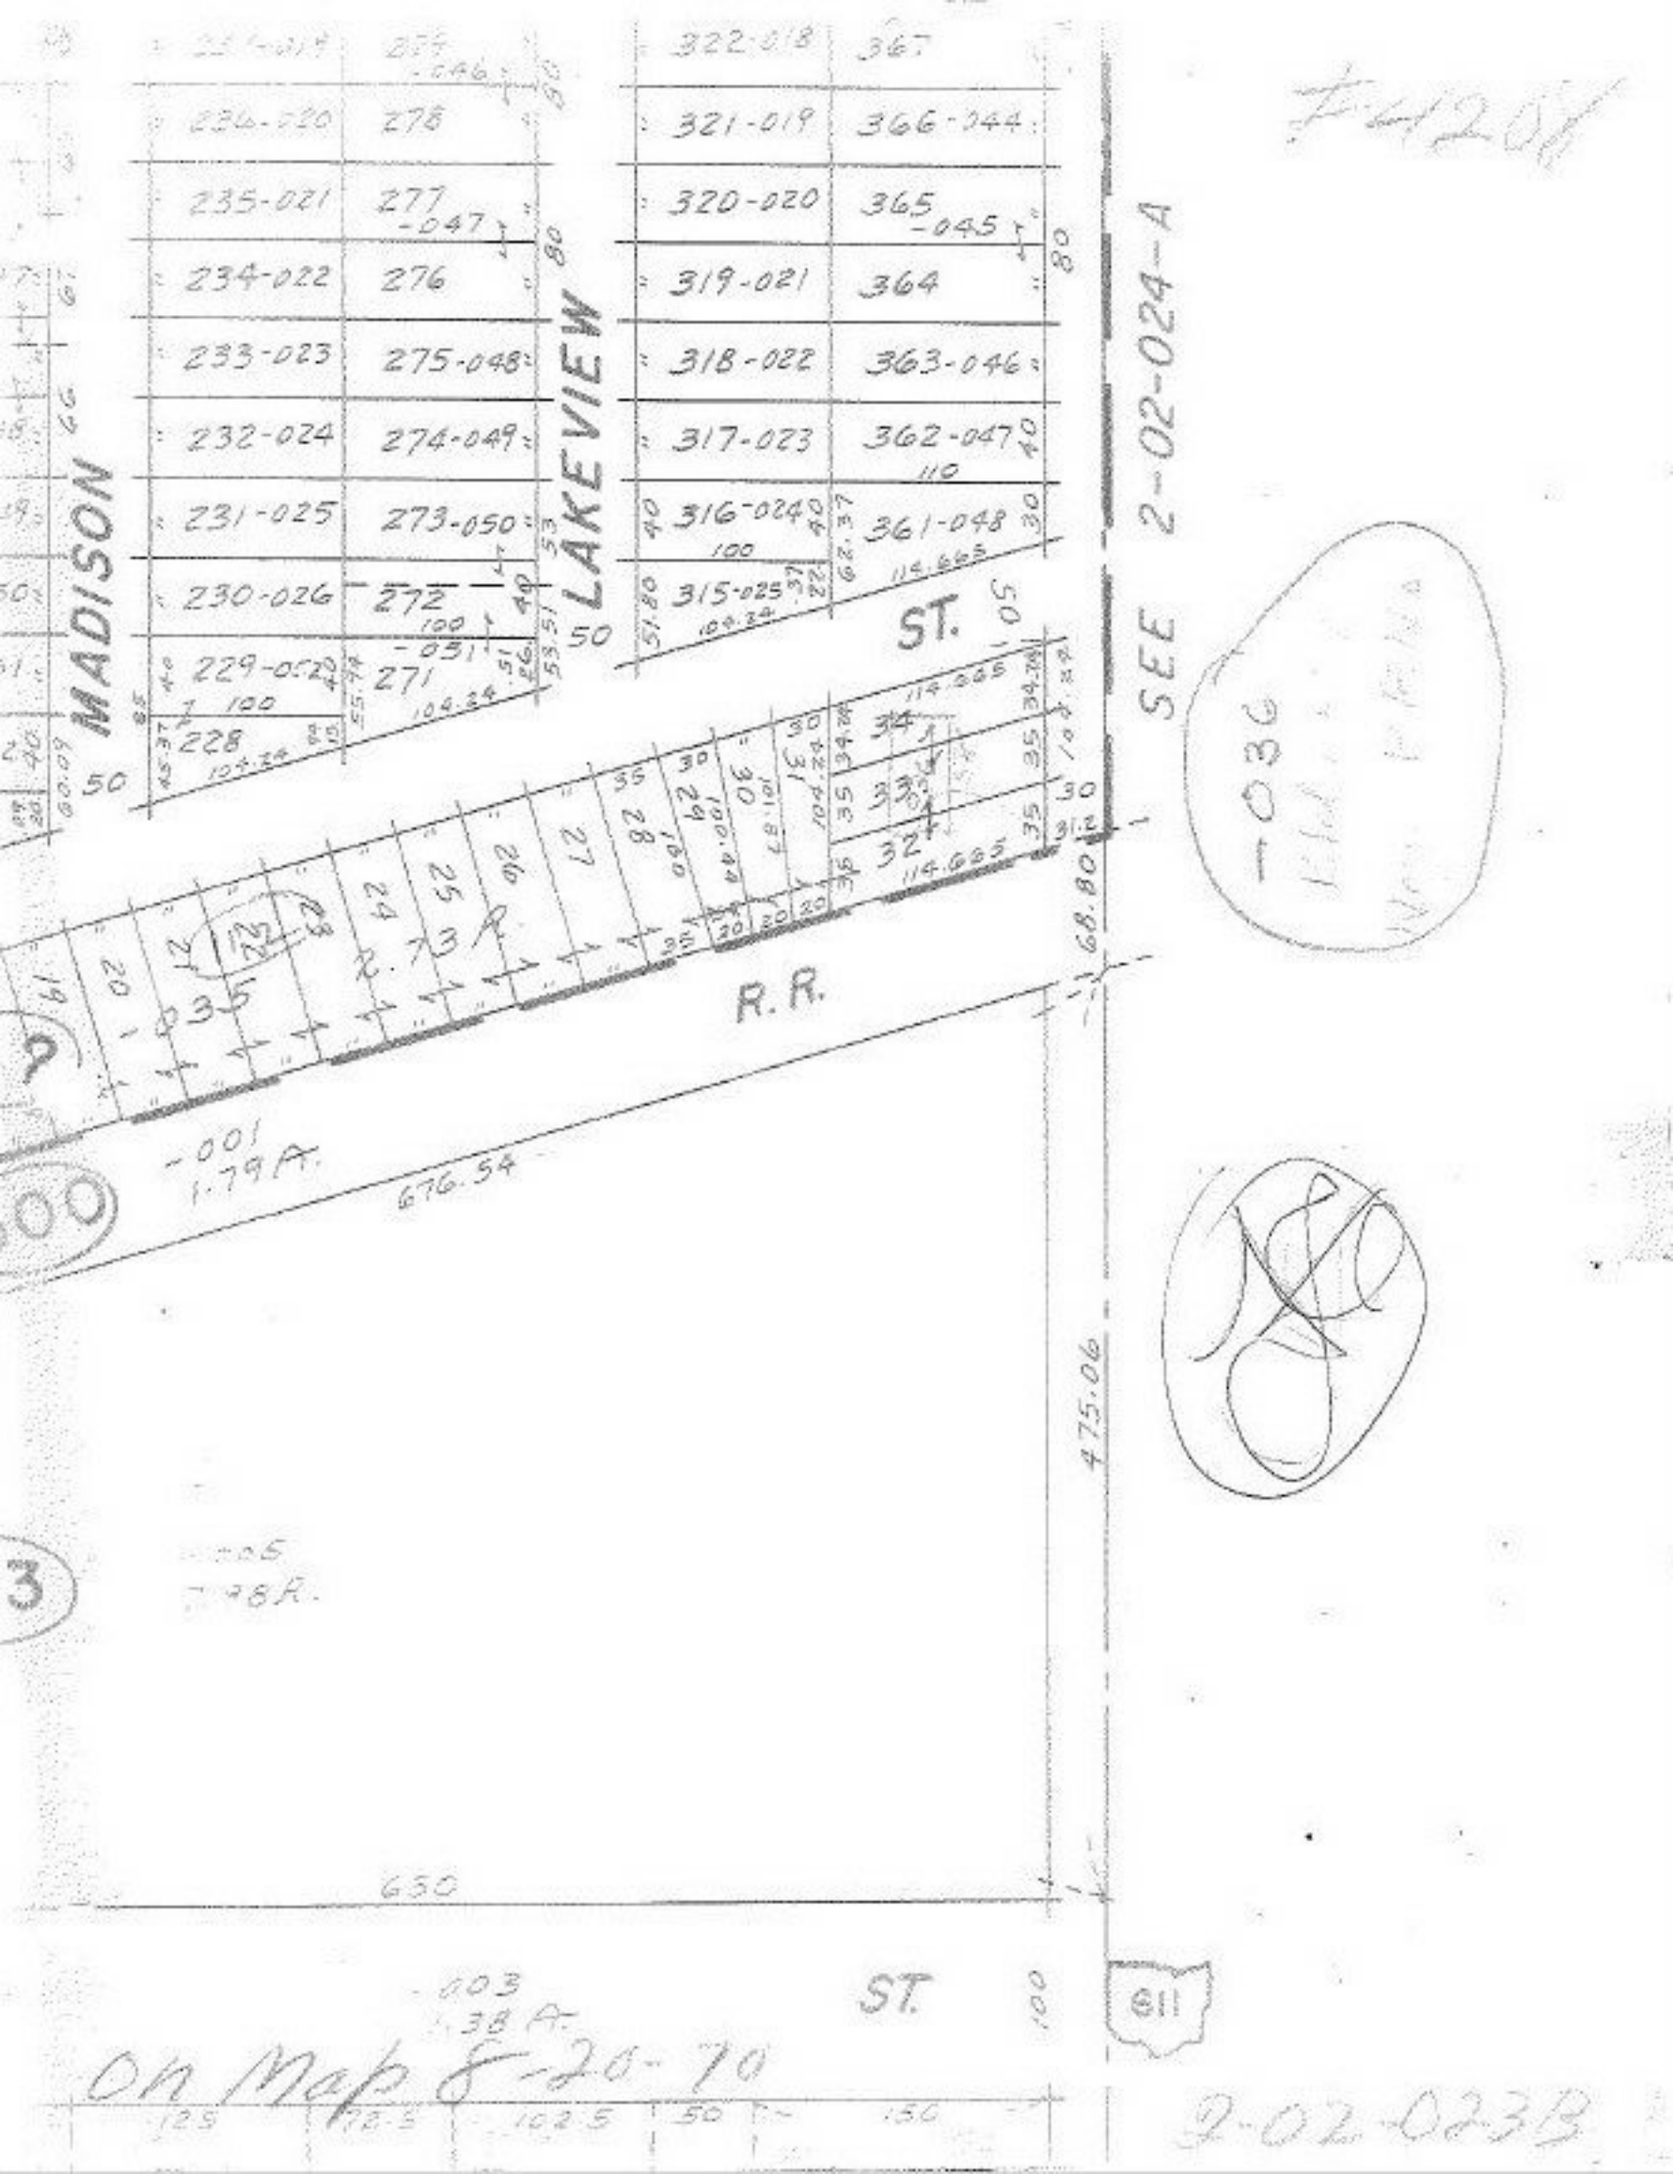
MADISON
LAKEVIEW
ST.
R.R.
SEE 2-02-024-A
-036
-001
1.79 A.
676.54
475.06
650
-003
1.38 A.
ST.
On Map 8-20-70
2-02-023