PARENT PARCEL: 06-24-123-000-021
CHILD PARCEL:
STARTING POINT: INTERSECTION OF C/L OF WEST RIVER RD. AND SOUTH LINE OF O.L.123

19-04214-D

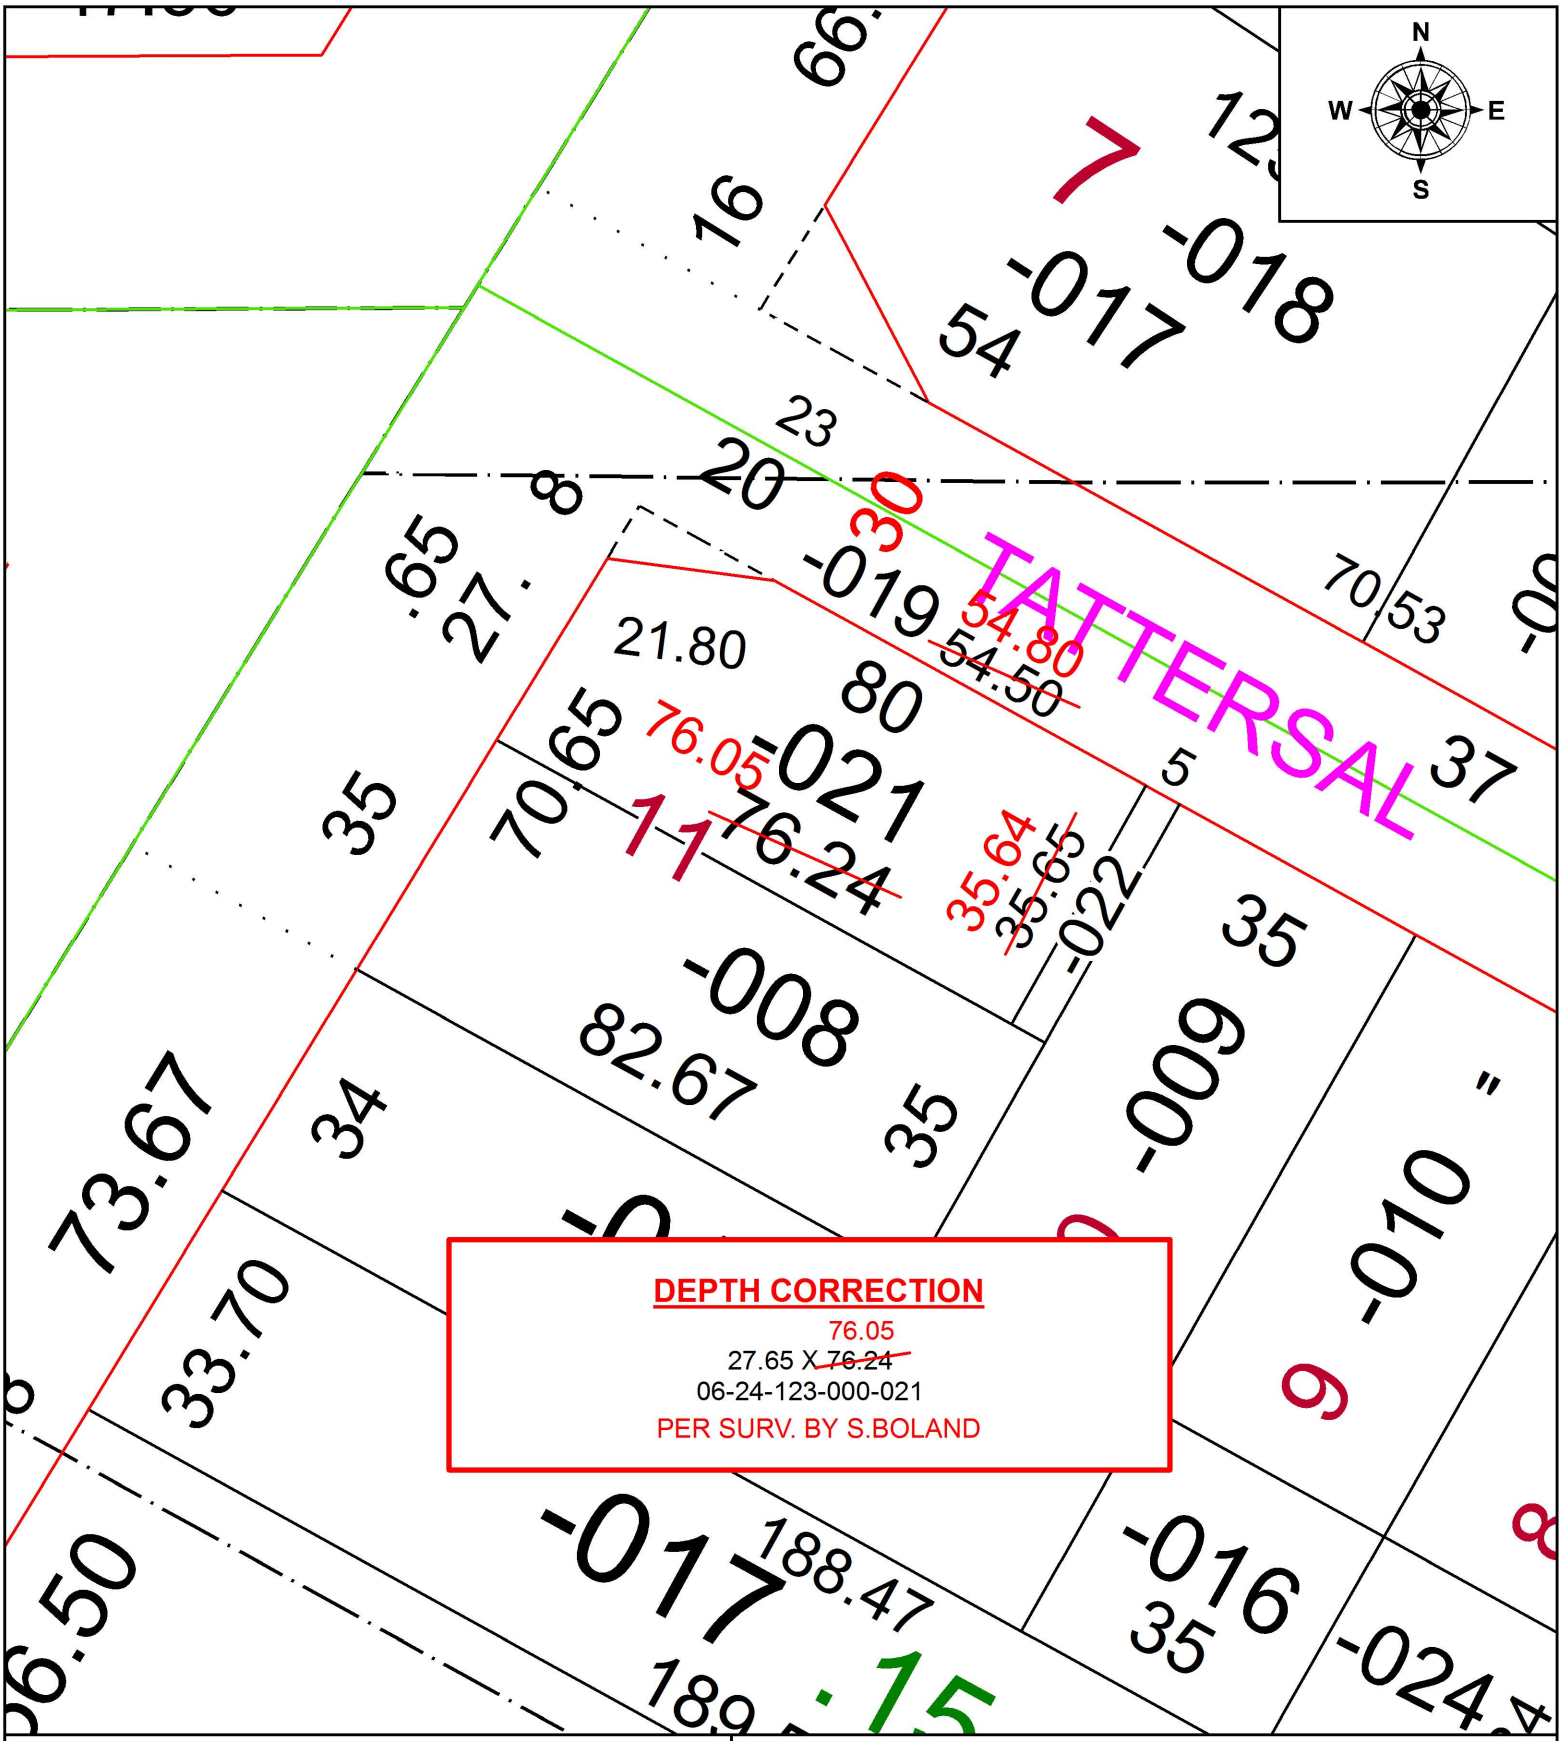

SPLITS/DEEDS PROCESSED
LORAIN COUNTY TAX MAP DEPARTMENT
226 MIDDLE AVE. ELYRIA, OH

SURVEYED BY: SEAN A. BOLAND
CLOSURE: 1:38,747
MAP PAGE(S): 6-24-123
APPOVED BY: RRM **DATE:** 10-30-19
SCALE: 1" = 25 **PRIOR INSTRUMENT:** 20120405355