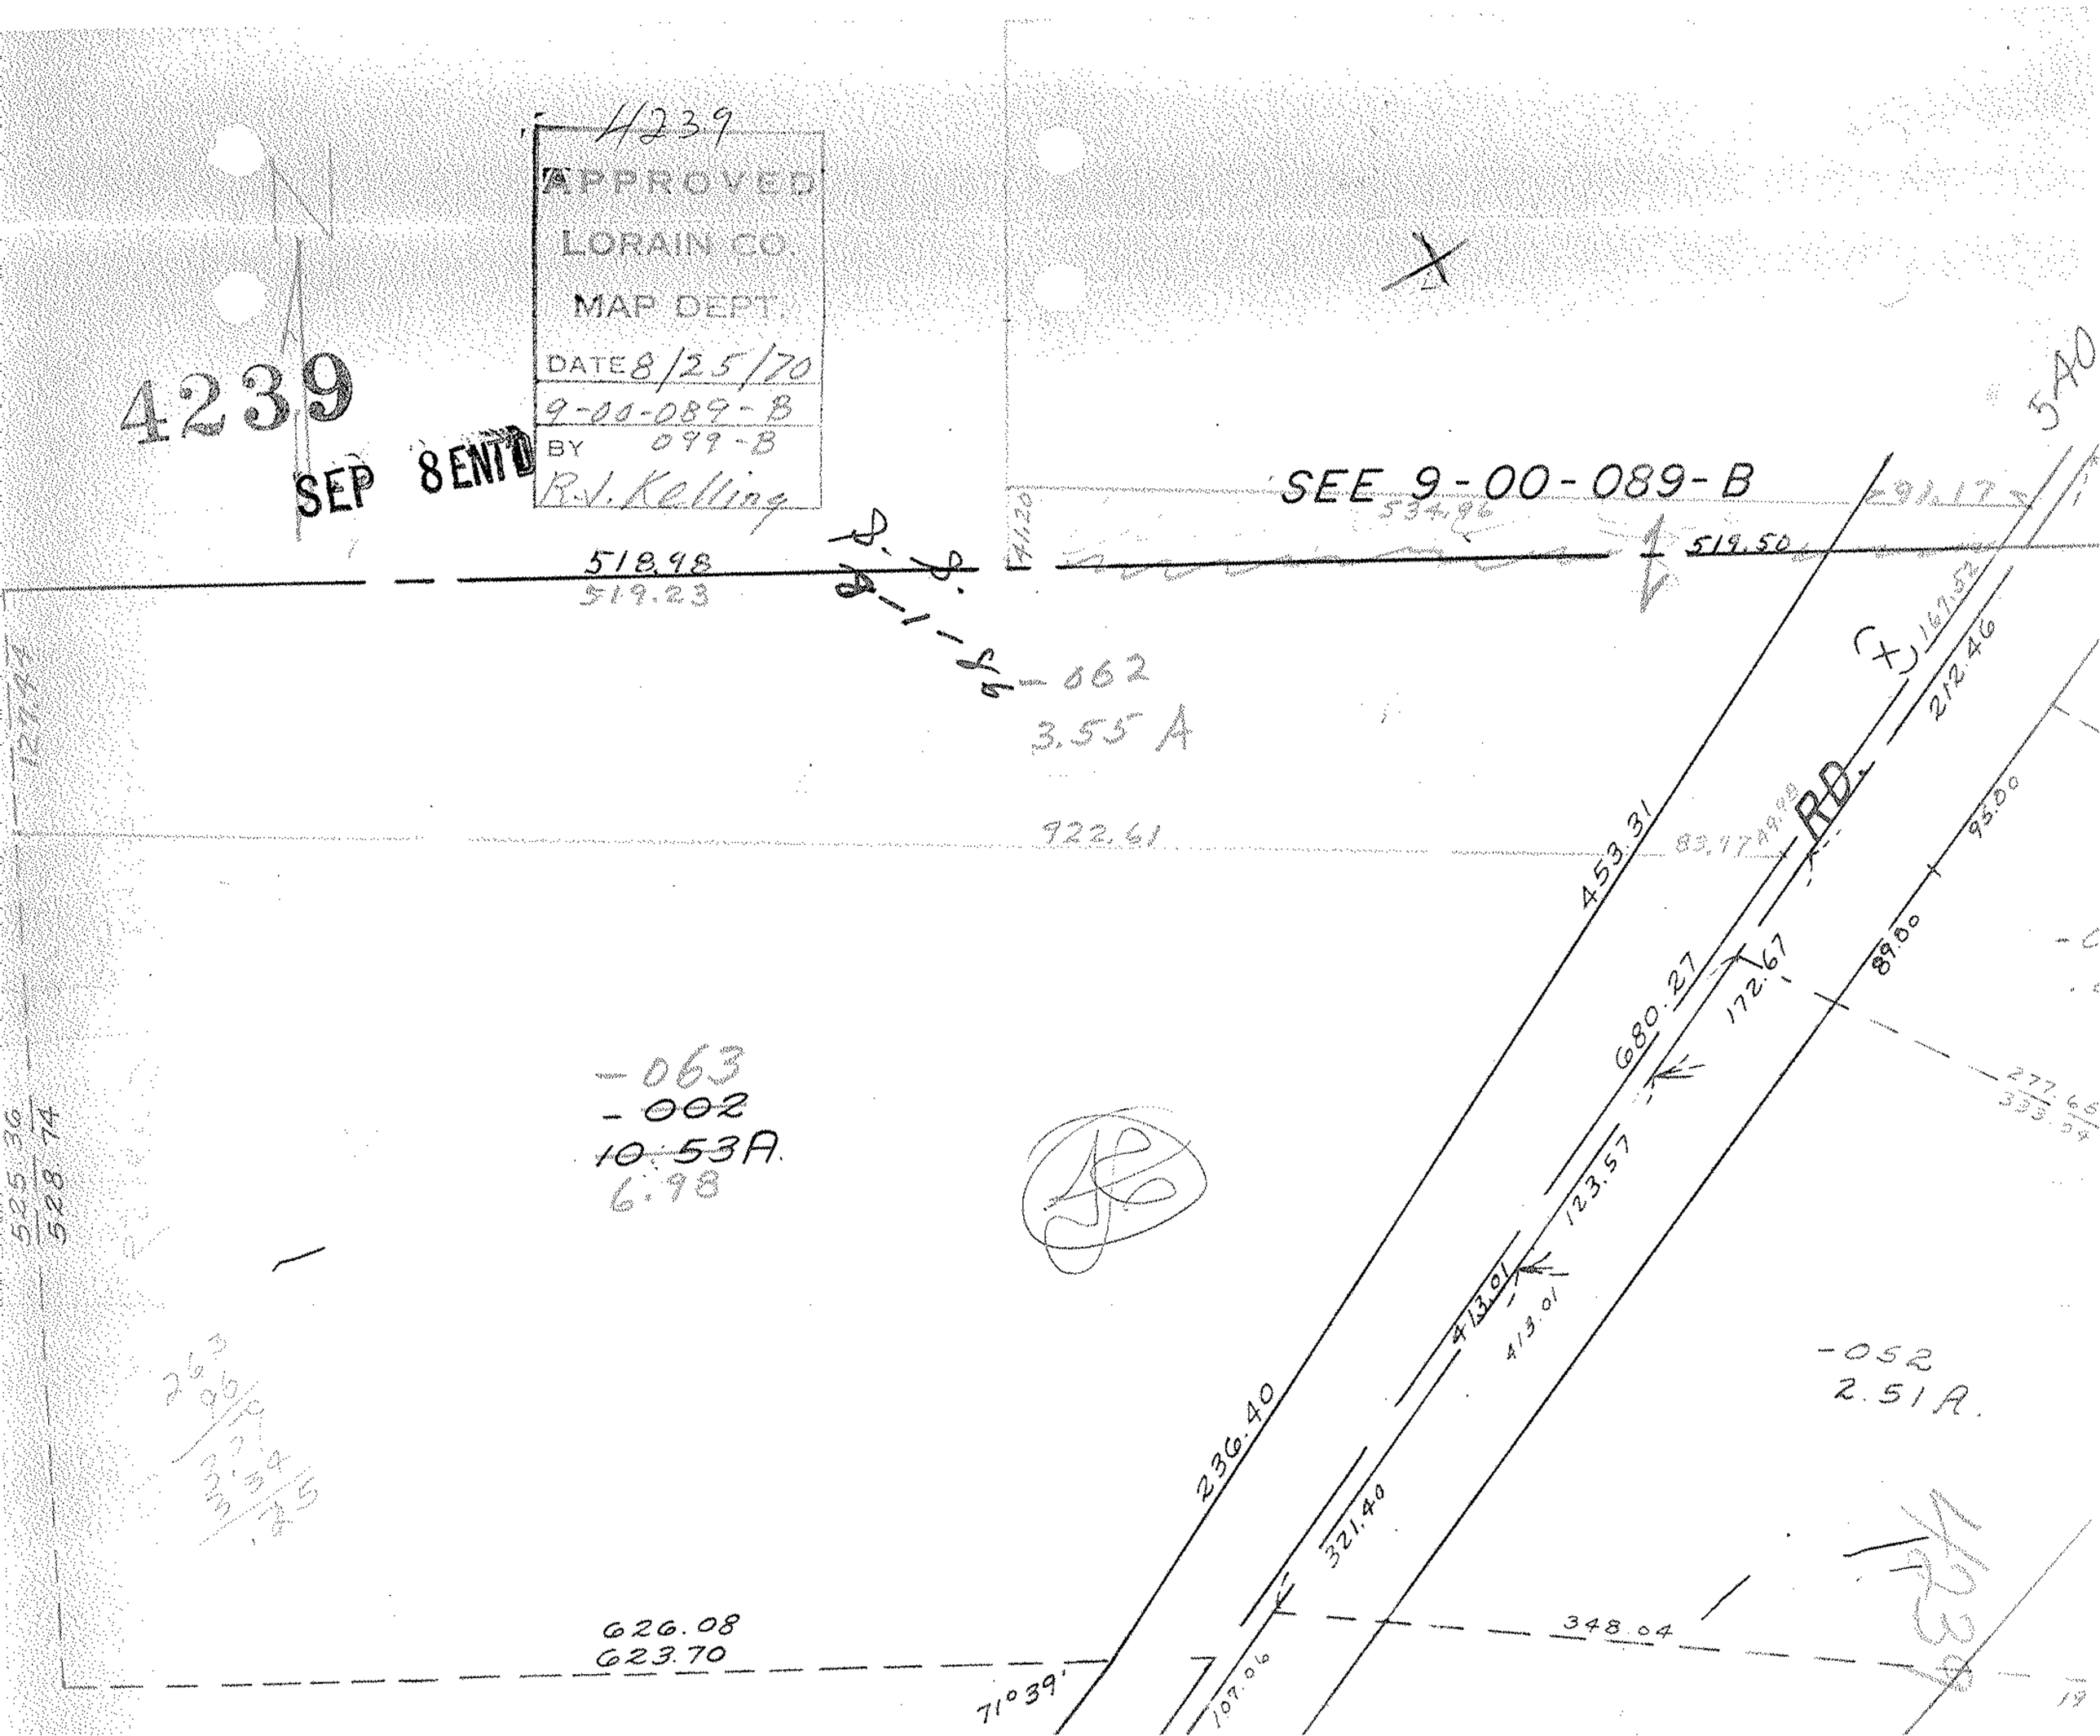
4239
APPROVED
LORAIN CO.
MAP DEPT.
DATE 8/25/70
9-00-089-B
BY 099-B
R.J. Kelling
4239
SEP 8 ENT'D
SEE 9-00-089-B
518.98
519.23
519.50
534.96
41.20
-062
3.55 A
922.61
453.31
RD.
167.52
212.46
95.00
89.00
680.27
172.67
123.57
413.01
413.01
236.40
321.40
-052
2.51 A.
-063
-002
10.53A.
6.98
525.36
528.74
626.08
623.70
71°39'
107.06
348.04
540