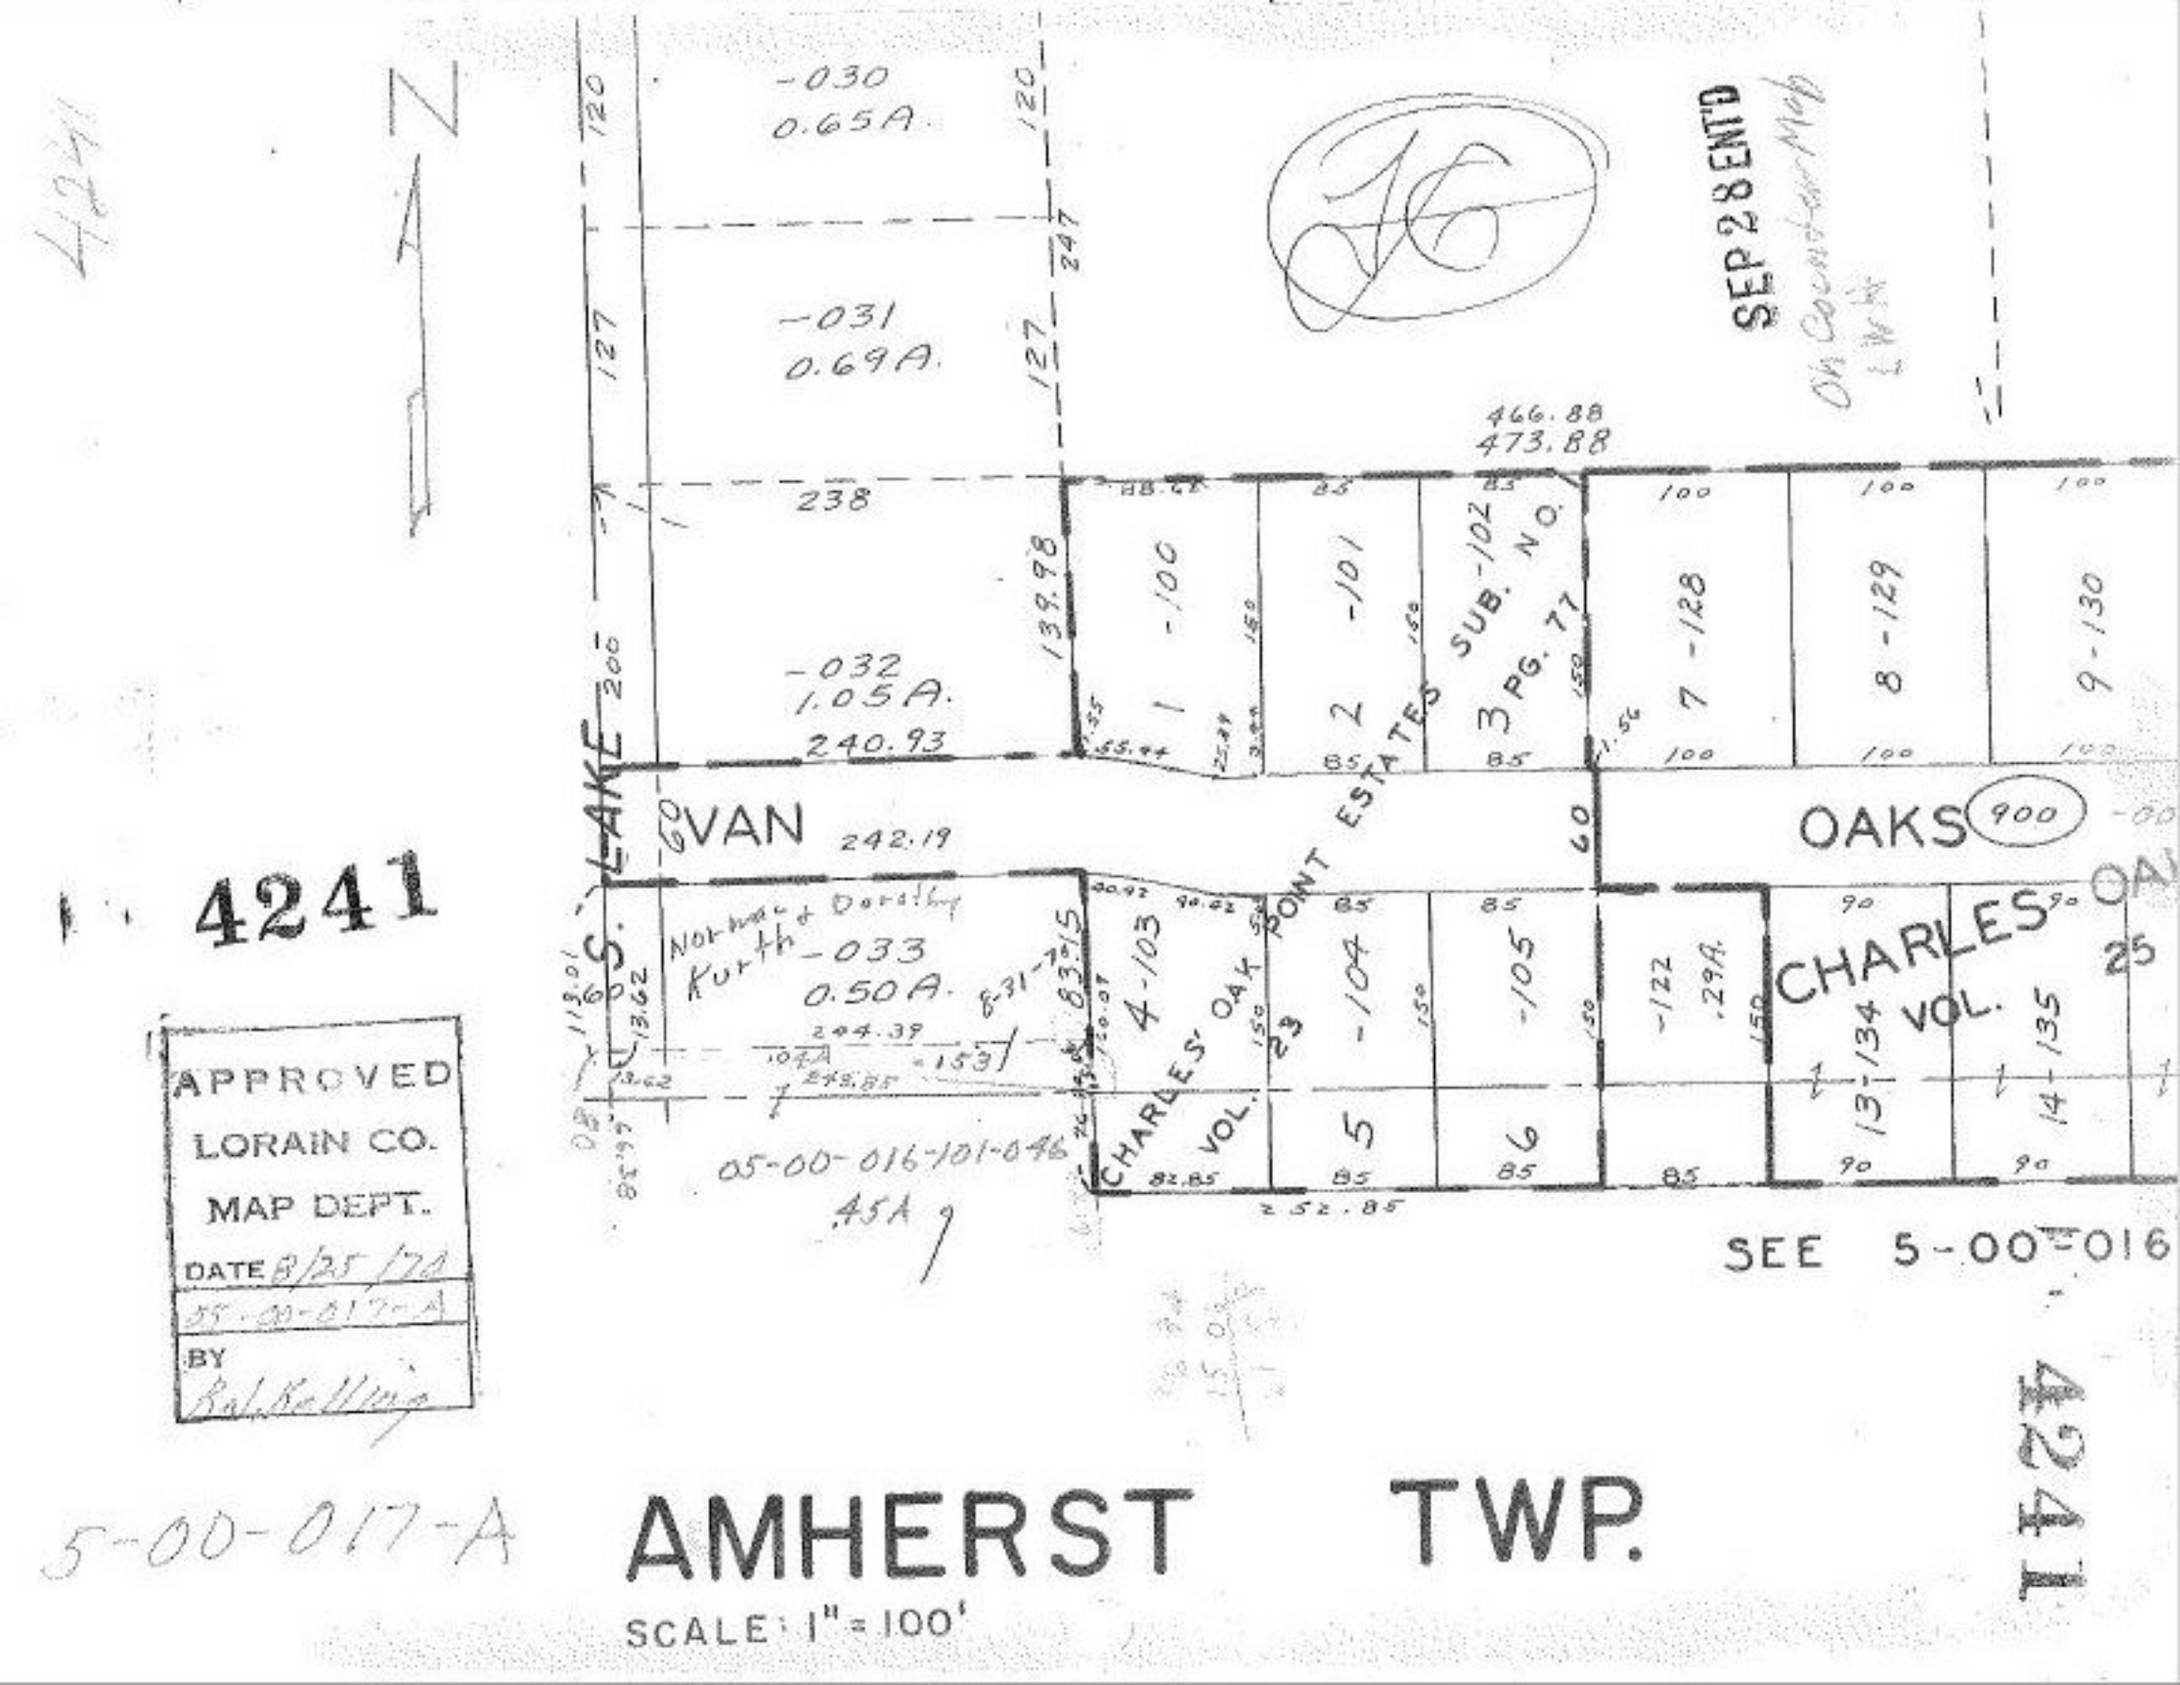

4241
N
-030
0.65A.
-031
0.69A.
-032
1.05A.
240.93
242.19
-033
0.50A.
244.39
05-00-016-101-046
.45A
S. LAKE
VAN
OAKS
900
CHARLES' OAK POINT ESTATES SUB. NO. 3 PG. 77
CHARLES' OAK VOL. 23
CHARLES' OAK VOL. 25
466.88
473.88
139.98
1 -100
2 -101
3 -102
4 -103
5 -104
6 -105
7 -128
8 -129
9 -130
13 -134
14 -135
-122
.29A.
252.85
SEE 5-00-016
SEP 28 ENT'D
4241
APPROVED
LORAIN CO.
MAP DEPT.
DATE 8/25/70
55-00-017-A
BY
5-00-017-A
AMHERST TWP.
SCALE: 1" = 100'
4241