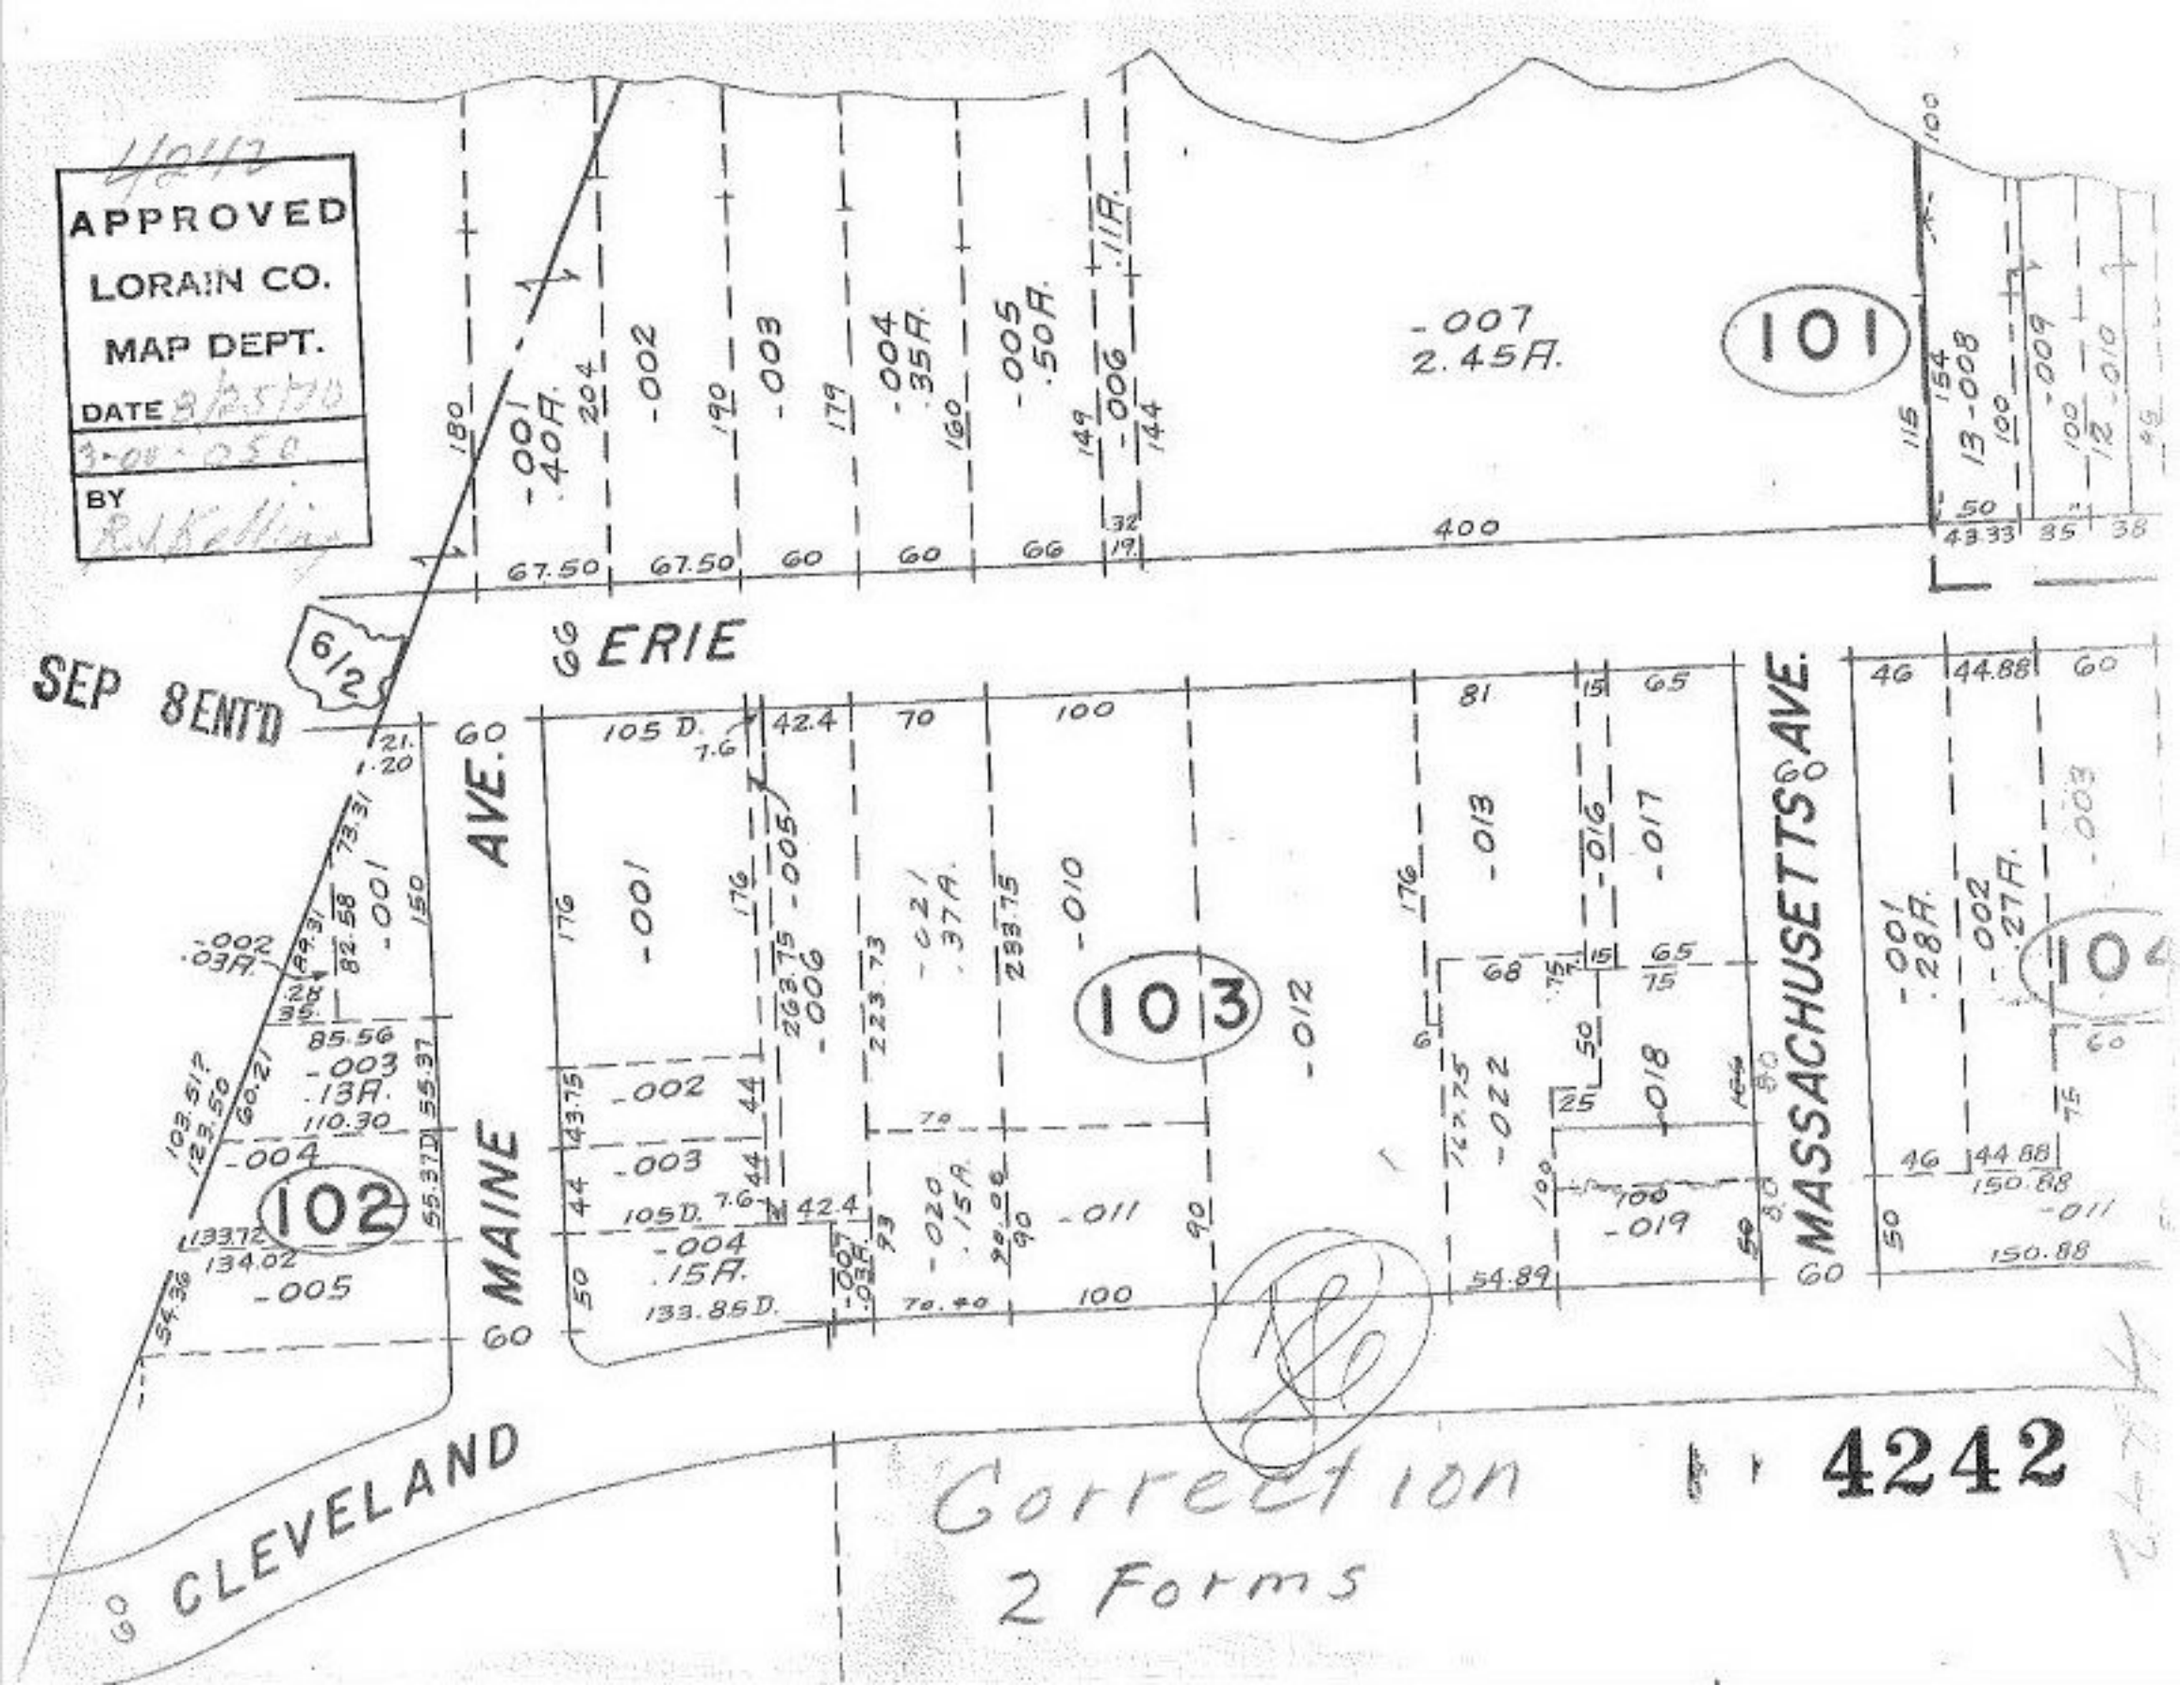
APPROVED
LORAIN CO.
MAP DEPT.
DATE
BY
SEP 8 ENT'D
6/2
ERIE
MAINE AVE.
MASSACHUSETTS AVE.
CLEVELAND
101
102
103
104
-007
2.45A.
-001
.40A.
-002
-003
-004
.35A.
-005
.50A.
-006
.11A.
-001
-002
-003
.13A.
-004
-005
-001
-002
-003
-004
.15A.
-005
-006
-021
.37A.
-010
-011
-012
-013
-016
-017
-018
-019
-022
-001
.28A.
-002
.27A.
-003
-011
Correction
2 Forms
4242