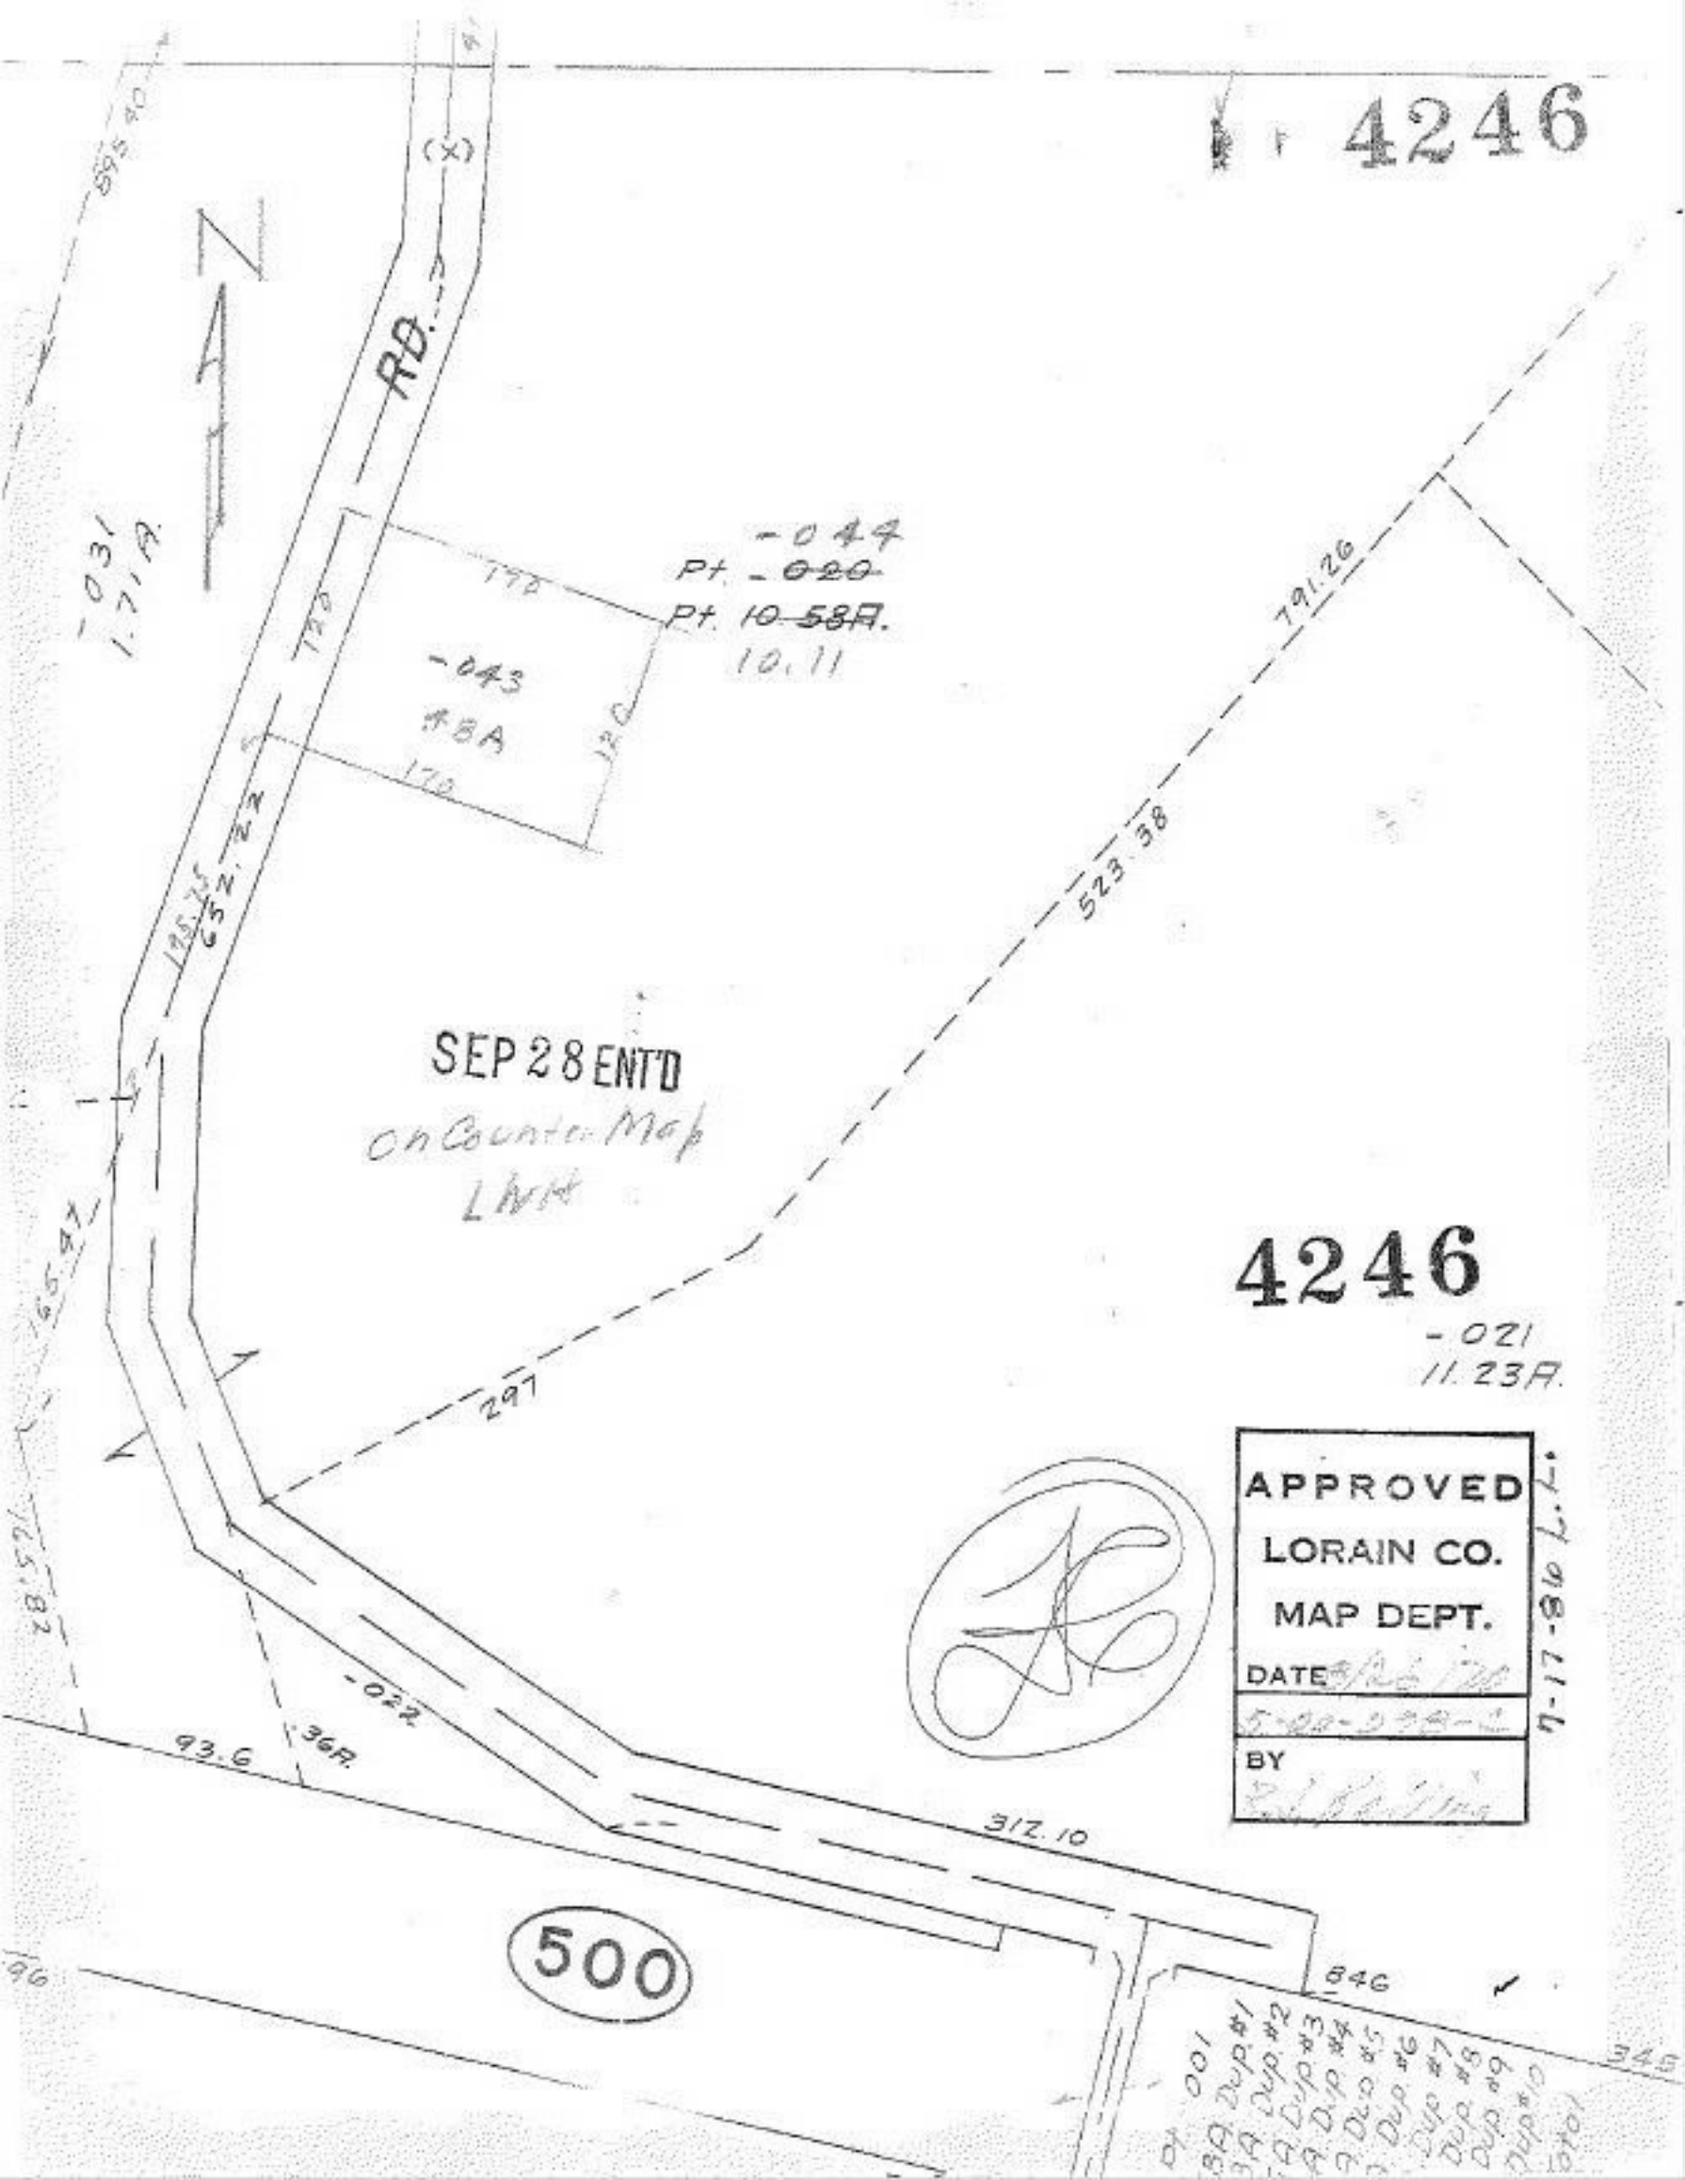
4246
RD.
-031
1.71A.
-044
Pt. ~~-020~~
Pt. ~~10.58A.~~
10.11
-043
.48A
170
120
652.22
791.26
523.38
SEP 28 ENT'D
On Counter Map
LWH
4246
-021
11.23A.
297
APPROVED
LORAIN CO.
MAP DEPT.
DATE
BY
7-17-86 L.L.
-022
93.6
.36A.
312.10
500
846
345