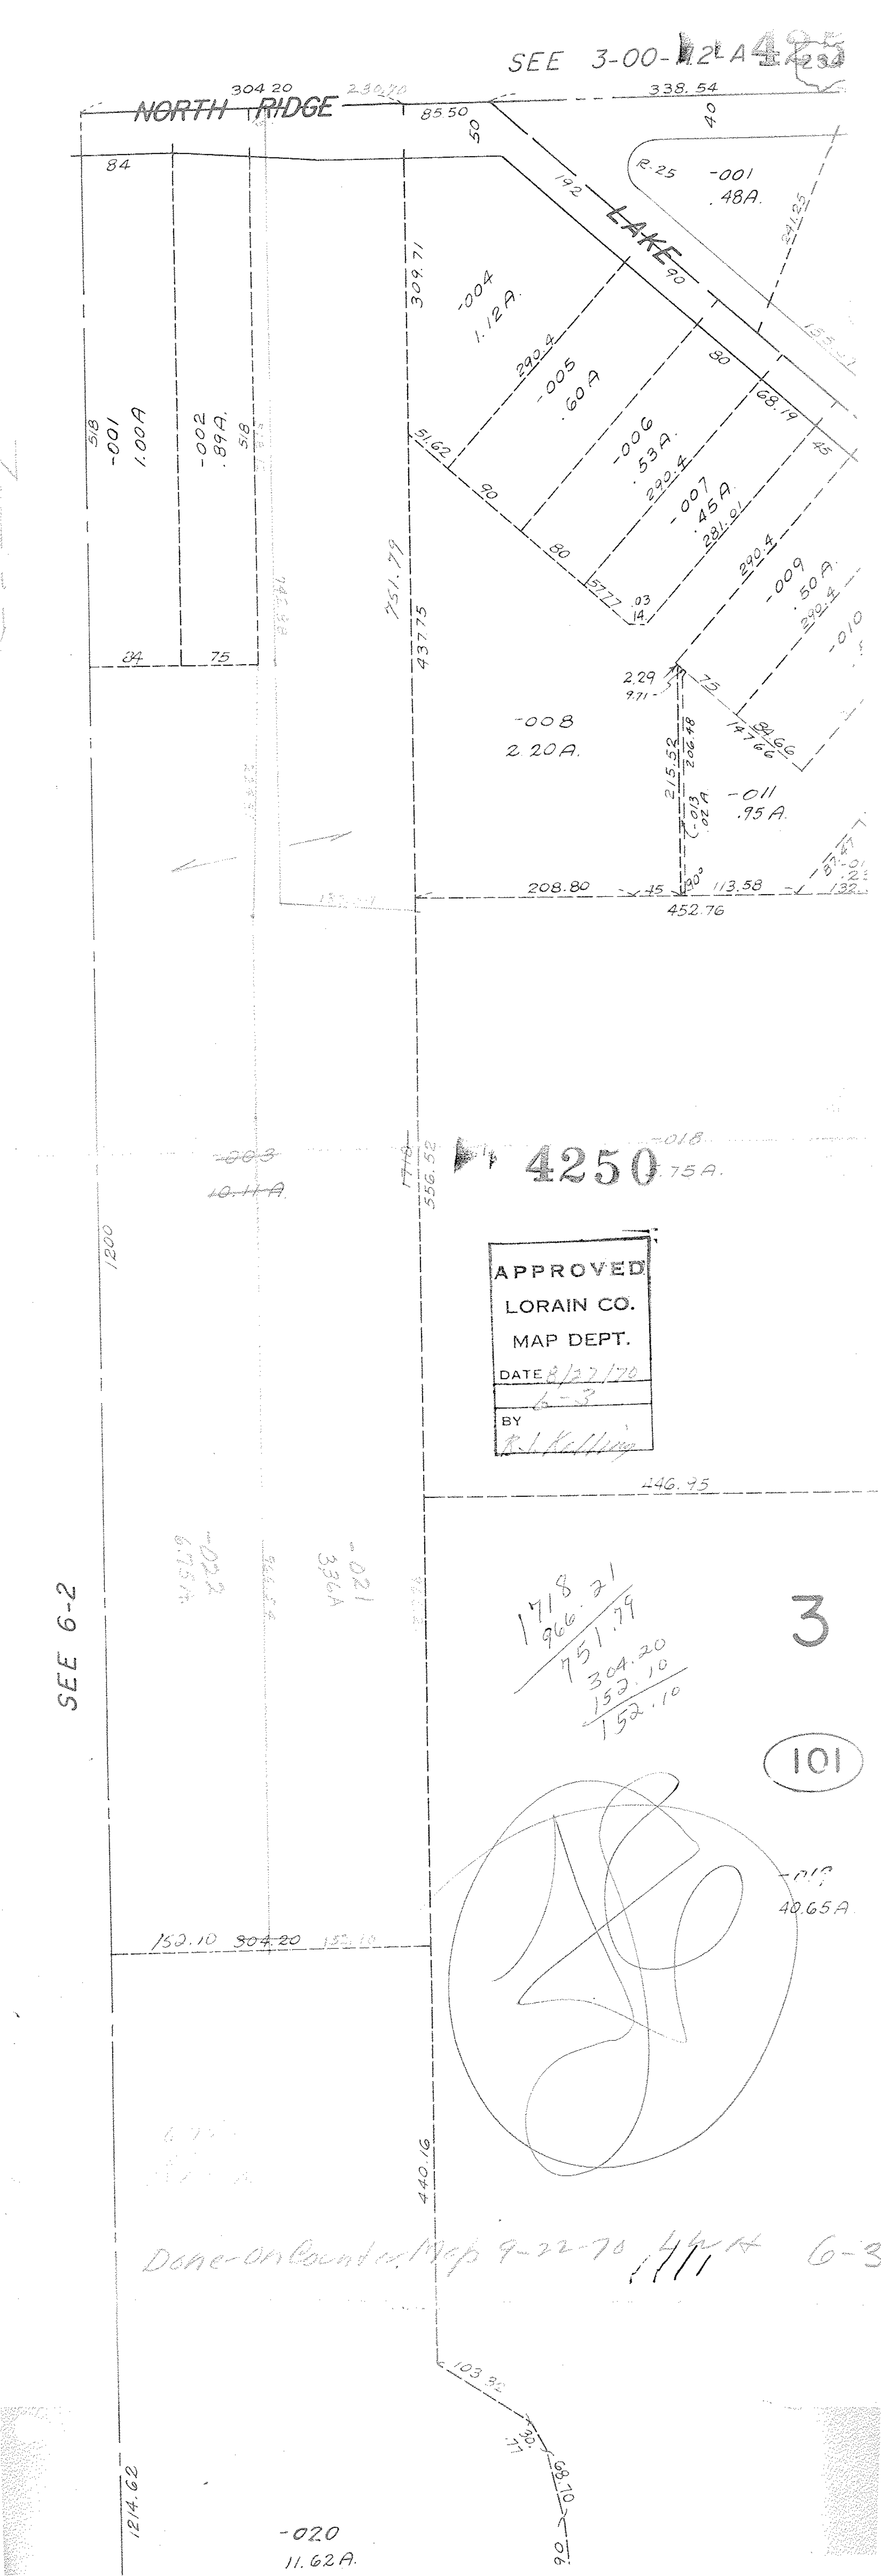
SEE 3-00-12-A
NORTH RIDGE
LAKE
-001
.48A.
-004
1.12A.
-005
.60A
-006
.53A.
-007
.45A.
-009
.50A.
-008
2.20A.
-011
.95A.
-001
1.00A
-002
.89A.
-003
10.11A.
4250
-018
.75A.
APPROVED
LORAIN CO.
MAP DEPT.
DATE 8/27/70
6-3
BY
R.J. Kelling
SEE 6-2
-022
6.75A.
-021
3.36A
1718
966.21
751.79
304.20
152.10
152.10
3
101
-019
40.65A.
Done-On Counter Map 9-22-70
6-3
-020
11.62A.