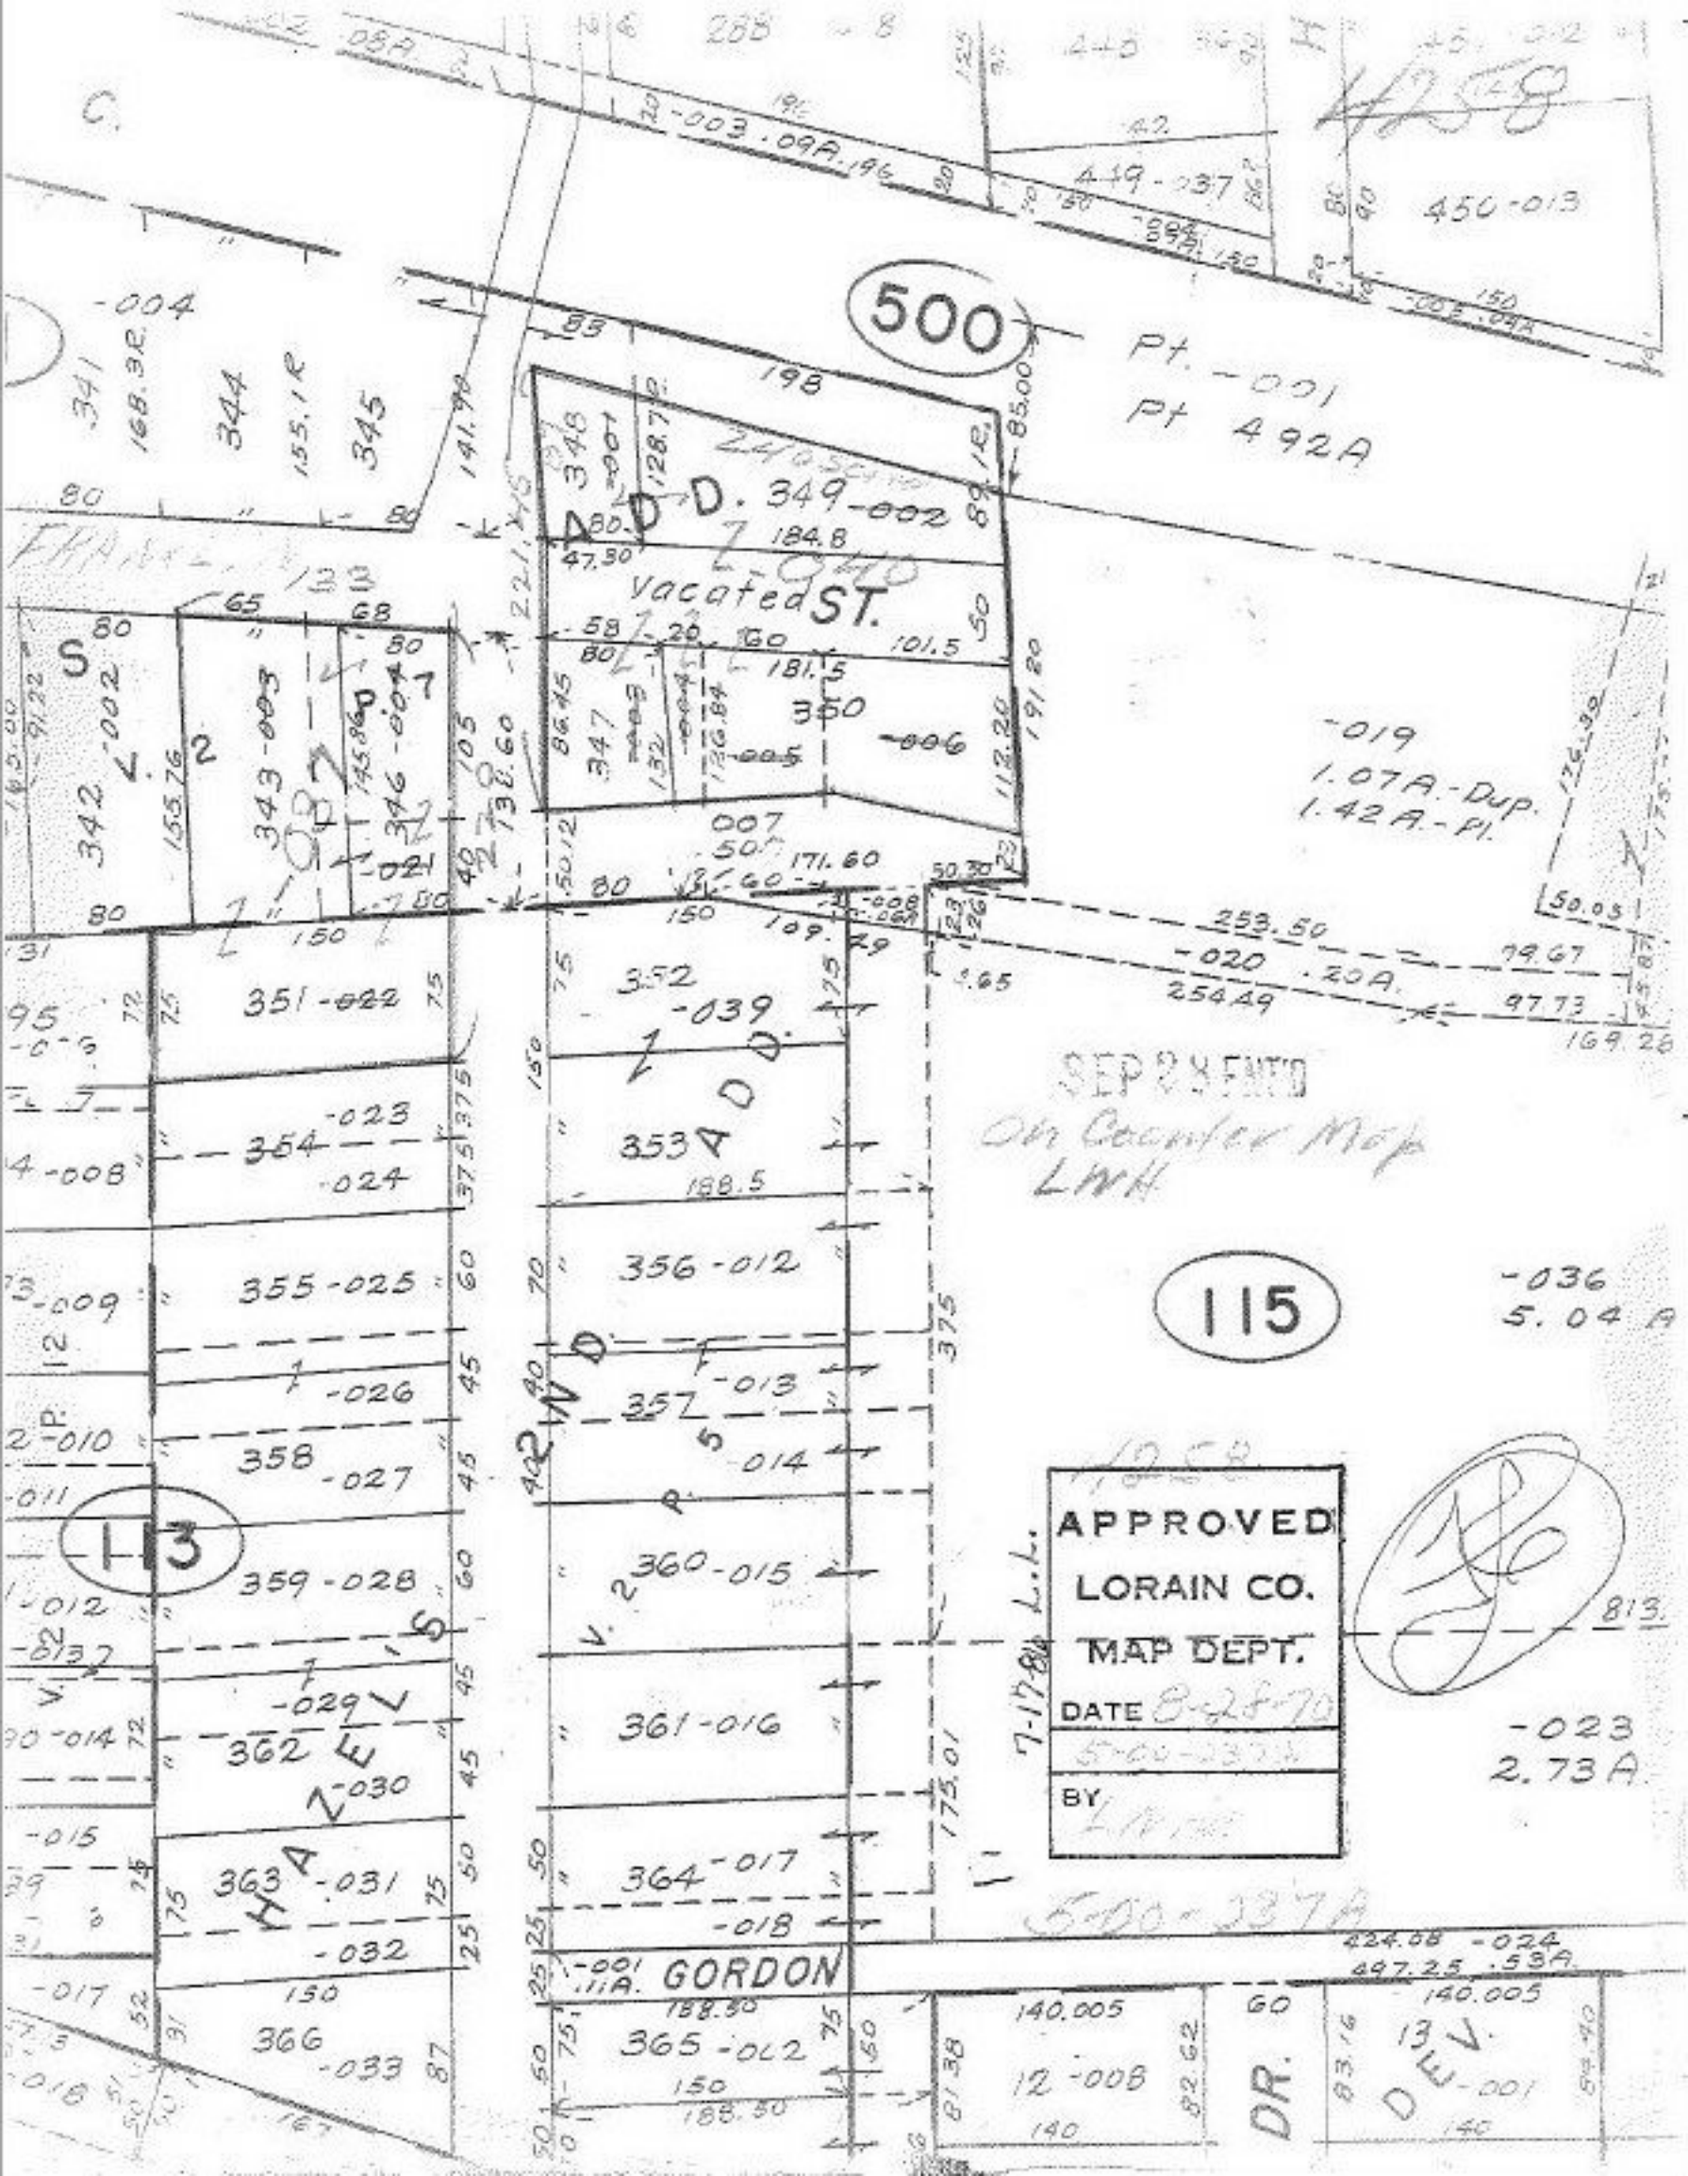
500
Pt. -001
Pt 492A
D. 349-002
184.8
Vacated ST.
-019
1.07A.-Dup.
1.42A.-Pl.
-020
.20A.
254.49
253.50
99.67
97.73
169.26
SEP 28 FMTD
On Counter Map
LWH
115
-036
5.04 A
-023
2.73A
APPROVED
LORAIN CO.
MAP DEPT.
DATE 8-28-70
BY
T-17 L.L.
424.08 -024
497.25 .53A.
GORDON
DR.
DEV.
H-3
HAZELS